


0055\_478

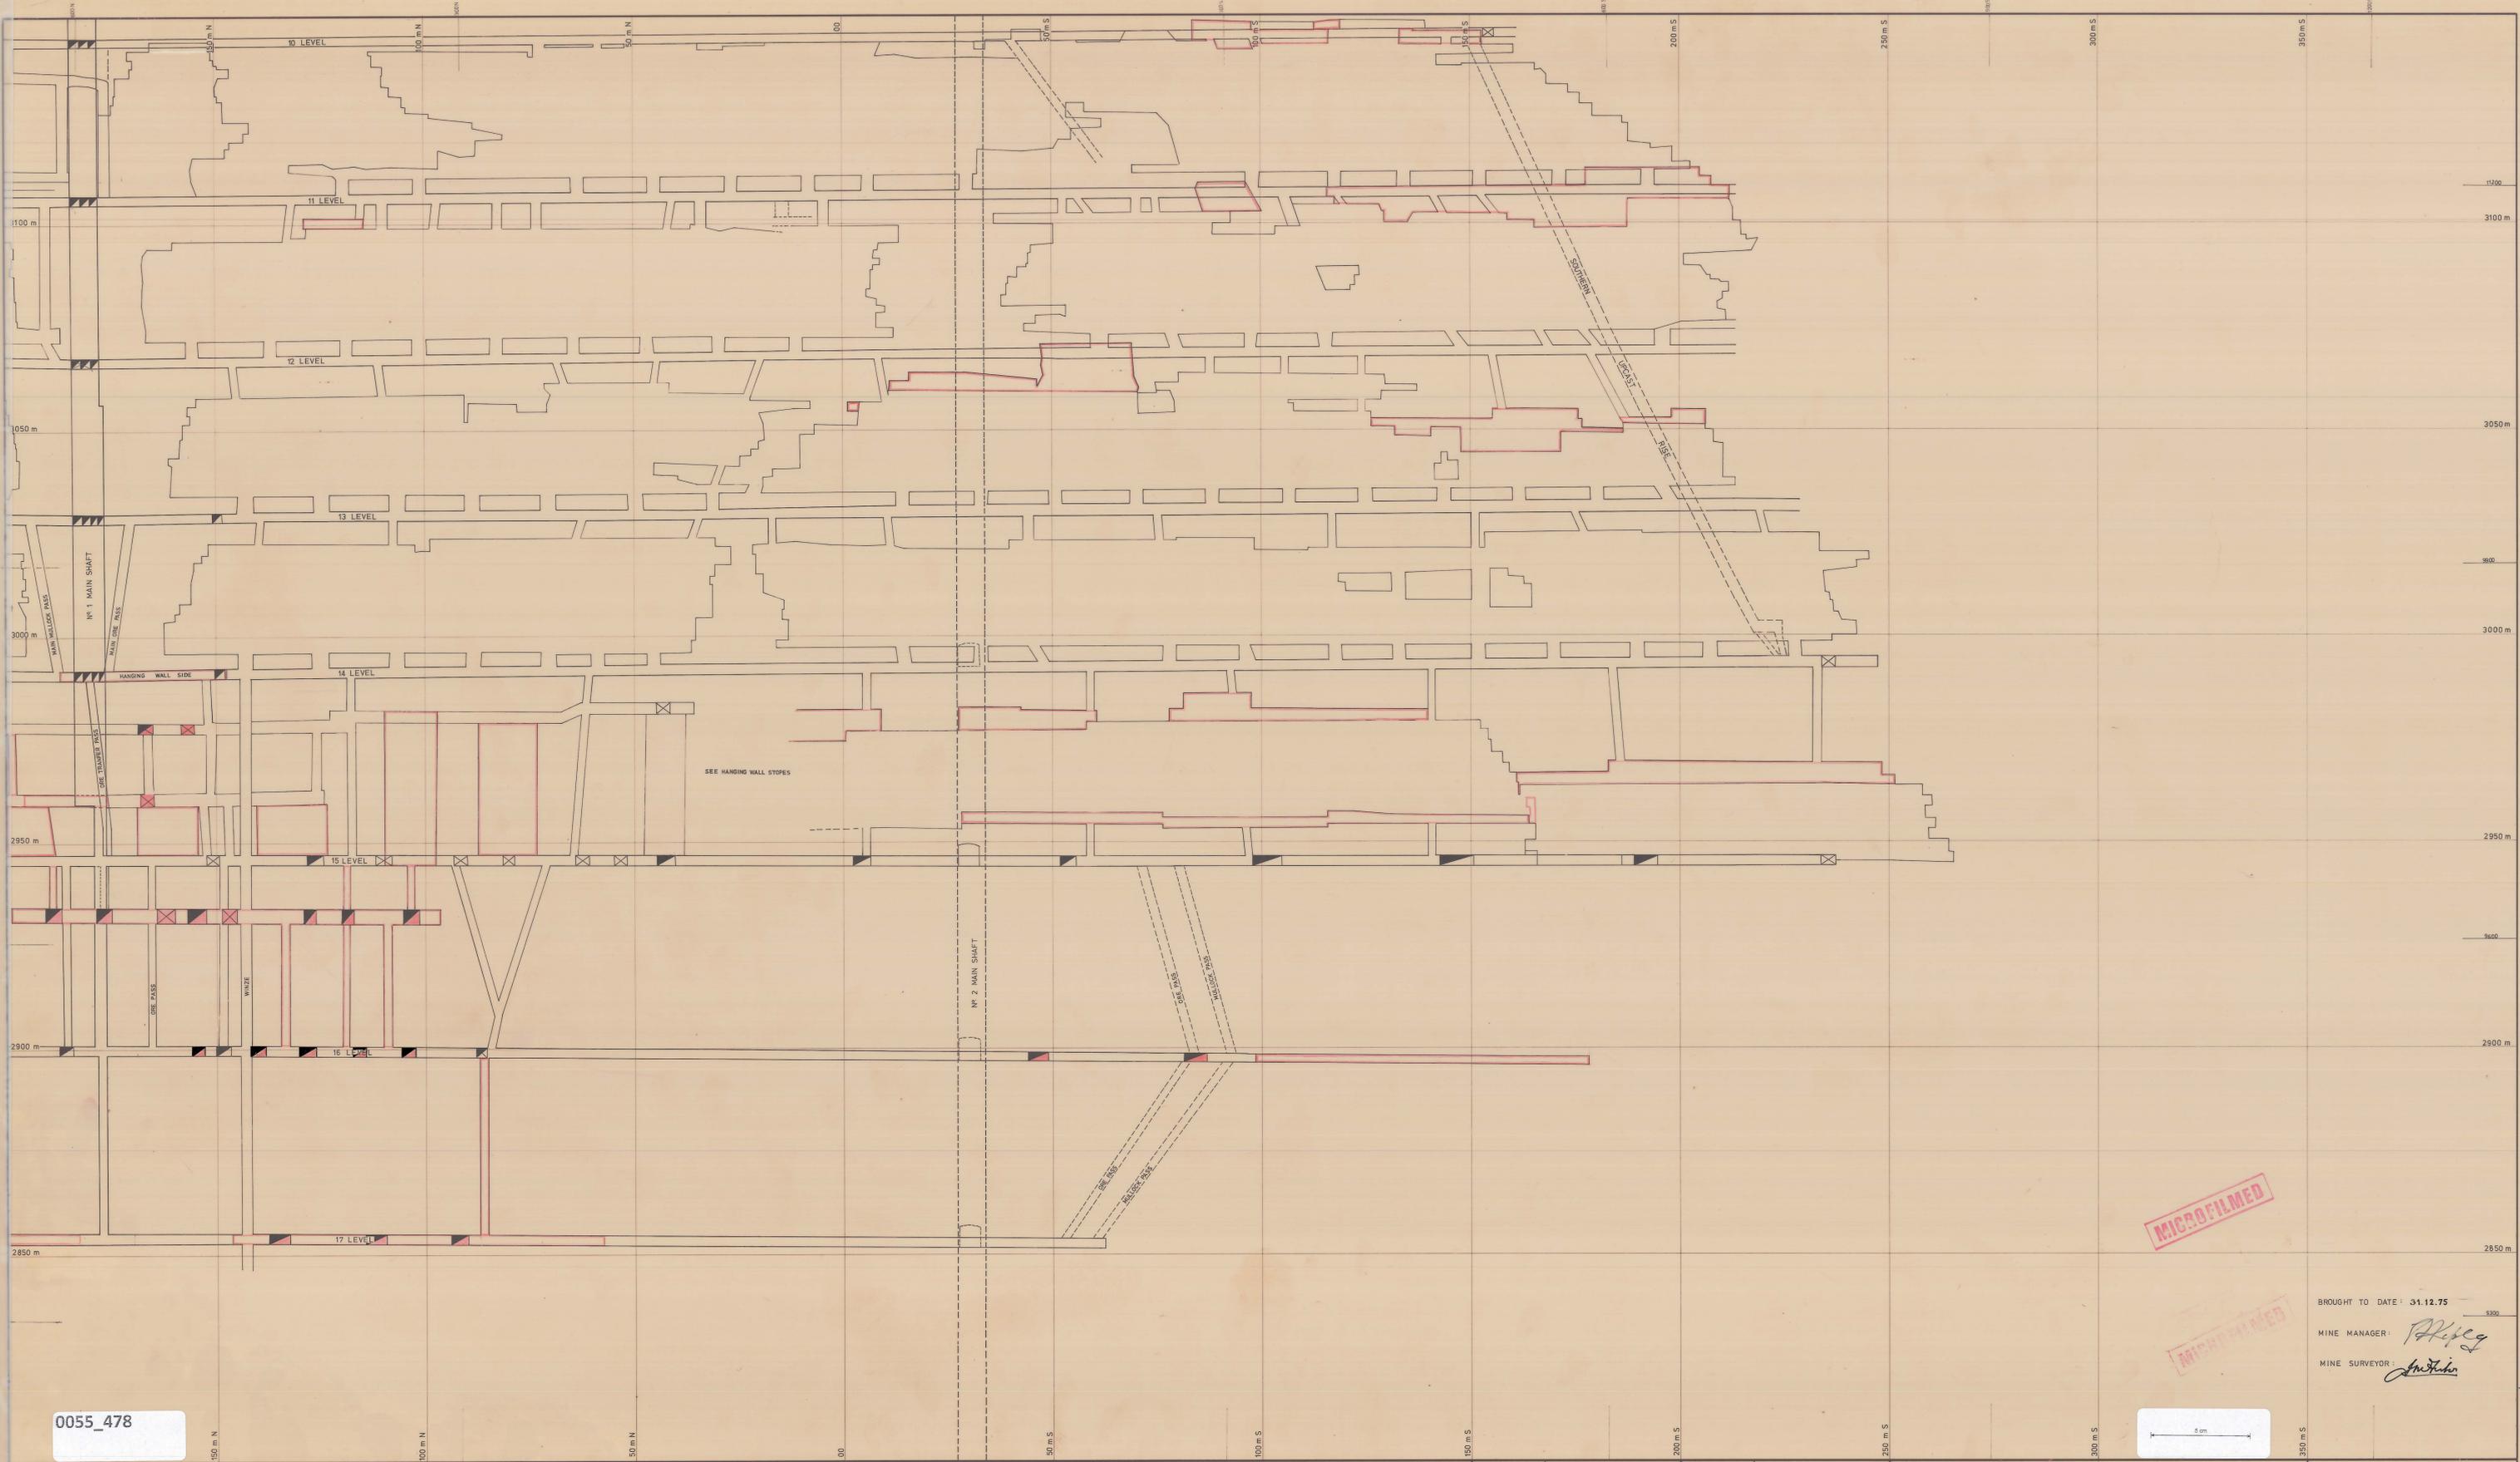


MICROFILMED

MICROFILMED

BROUGHT TO DATE: 31.12.75  
 MINE MANAGER: *P. Hiley*  
 MINE SURVEYOR: *A. Fisher*

0055\_478

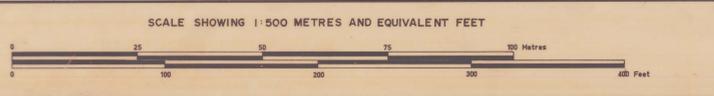

ELECTROLYTIC ZINC COMPANY OF AUSTRALASIA LIMITED  
 WEST COAST MINES, TAS.

SURVEY BY	SCALE	1:500 metres
DRAWN BY	DATE	1973
TRACED BY S.M. Burrows	REFERENCE	

ROSEBERY MINE  
 LONGITUDINAL PROJECTION  
 400mS-200mN - BELOW 10/L

DRAWING N°:  
 DEPARTMENT OF MINES  
 76078