

0055\_479




0055\_479

MICROFILMED  
MICROFILMED

BROUGHT TO DATE : 31.12.75  
 MINE MANAGER : *[Signature]*  
 MINE SURVEYOR : *[Signature]*

5 cm

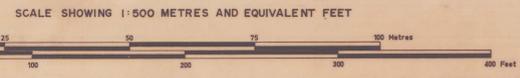

**ELECTROLYTIC ZINC COMPANY OF AUSTRALASIA LIMITED**  
 WEST COAST MINES, T.A.S.

|           |            |           |         |
|-----------|------------|-----------|---------|
| SURVEY BY |            | SCALE     | 1 : 500 |
| DRAWN BY  |            | DATE      | 1973    |
| TRACED BY | P. J. Lowe | REFERENCE |         |

ROSEBERY MINE  
 LONGITUDINAL PROJECTION  
 200mN - 800mN — BELOW 10 / L.

DRAWING NO :  
 DEPARTMENT OF MINES  
 16077