


0055_480

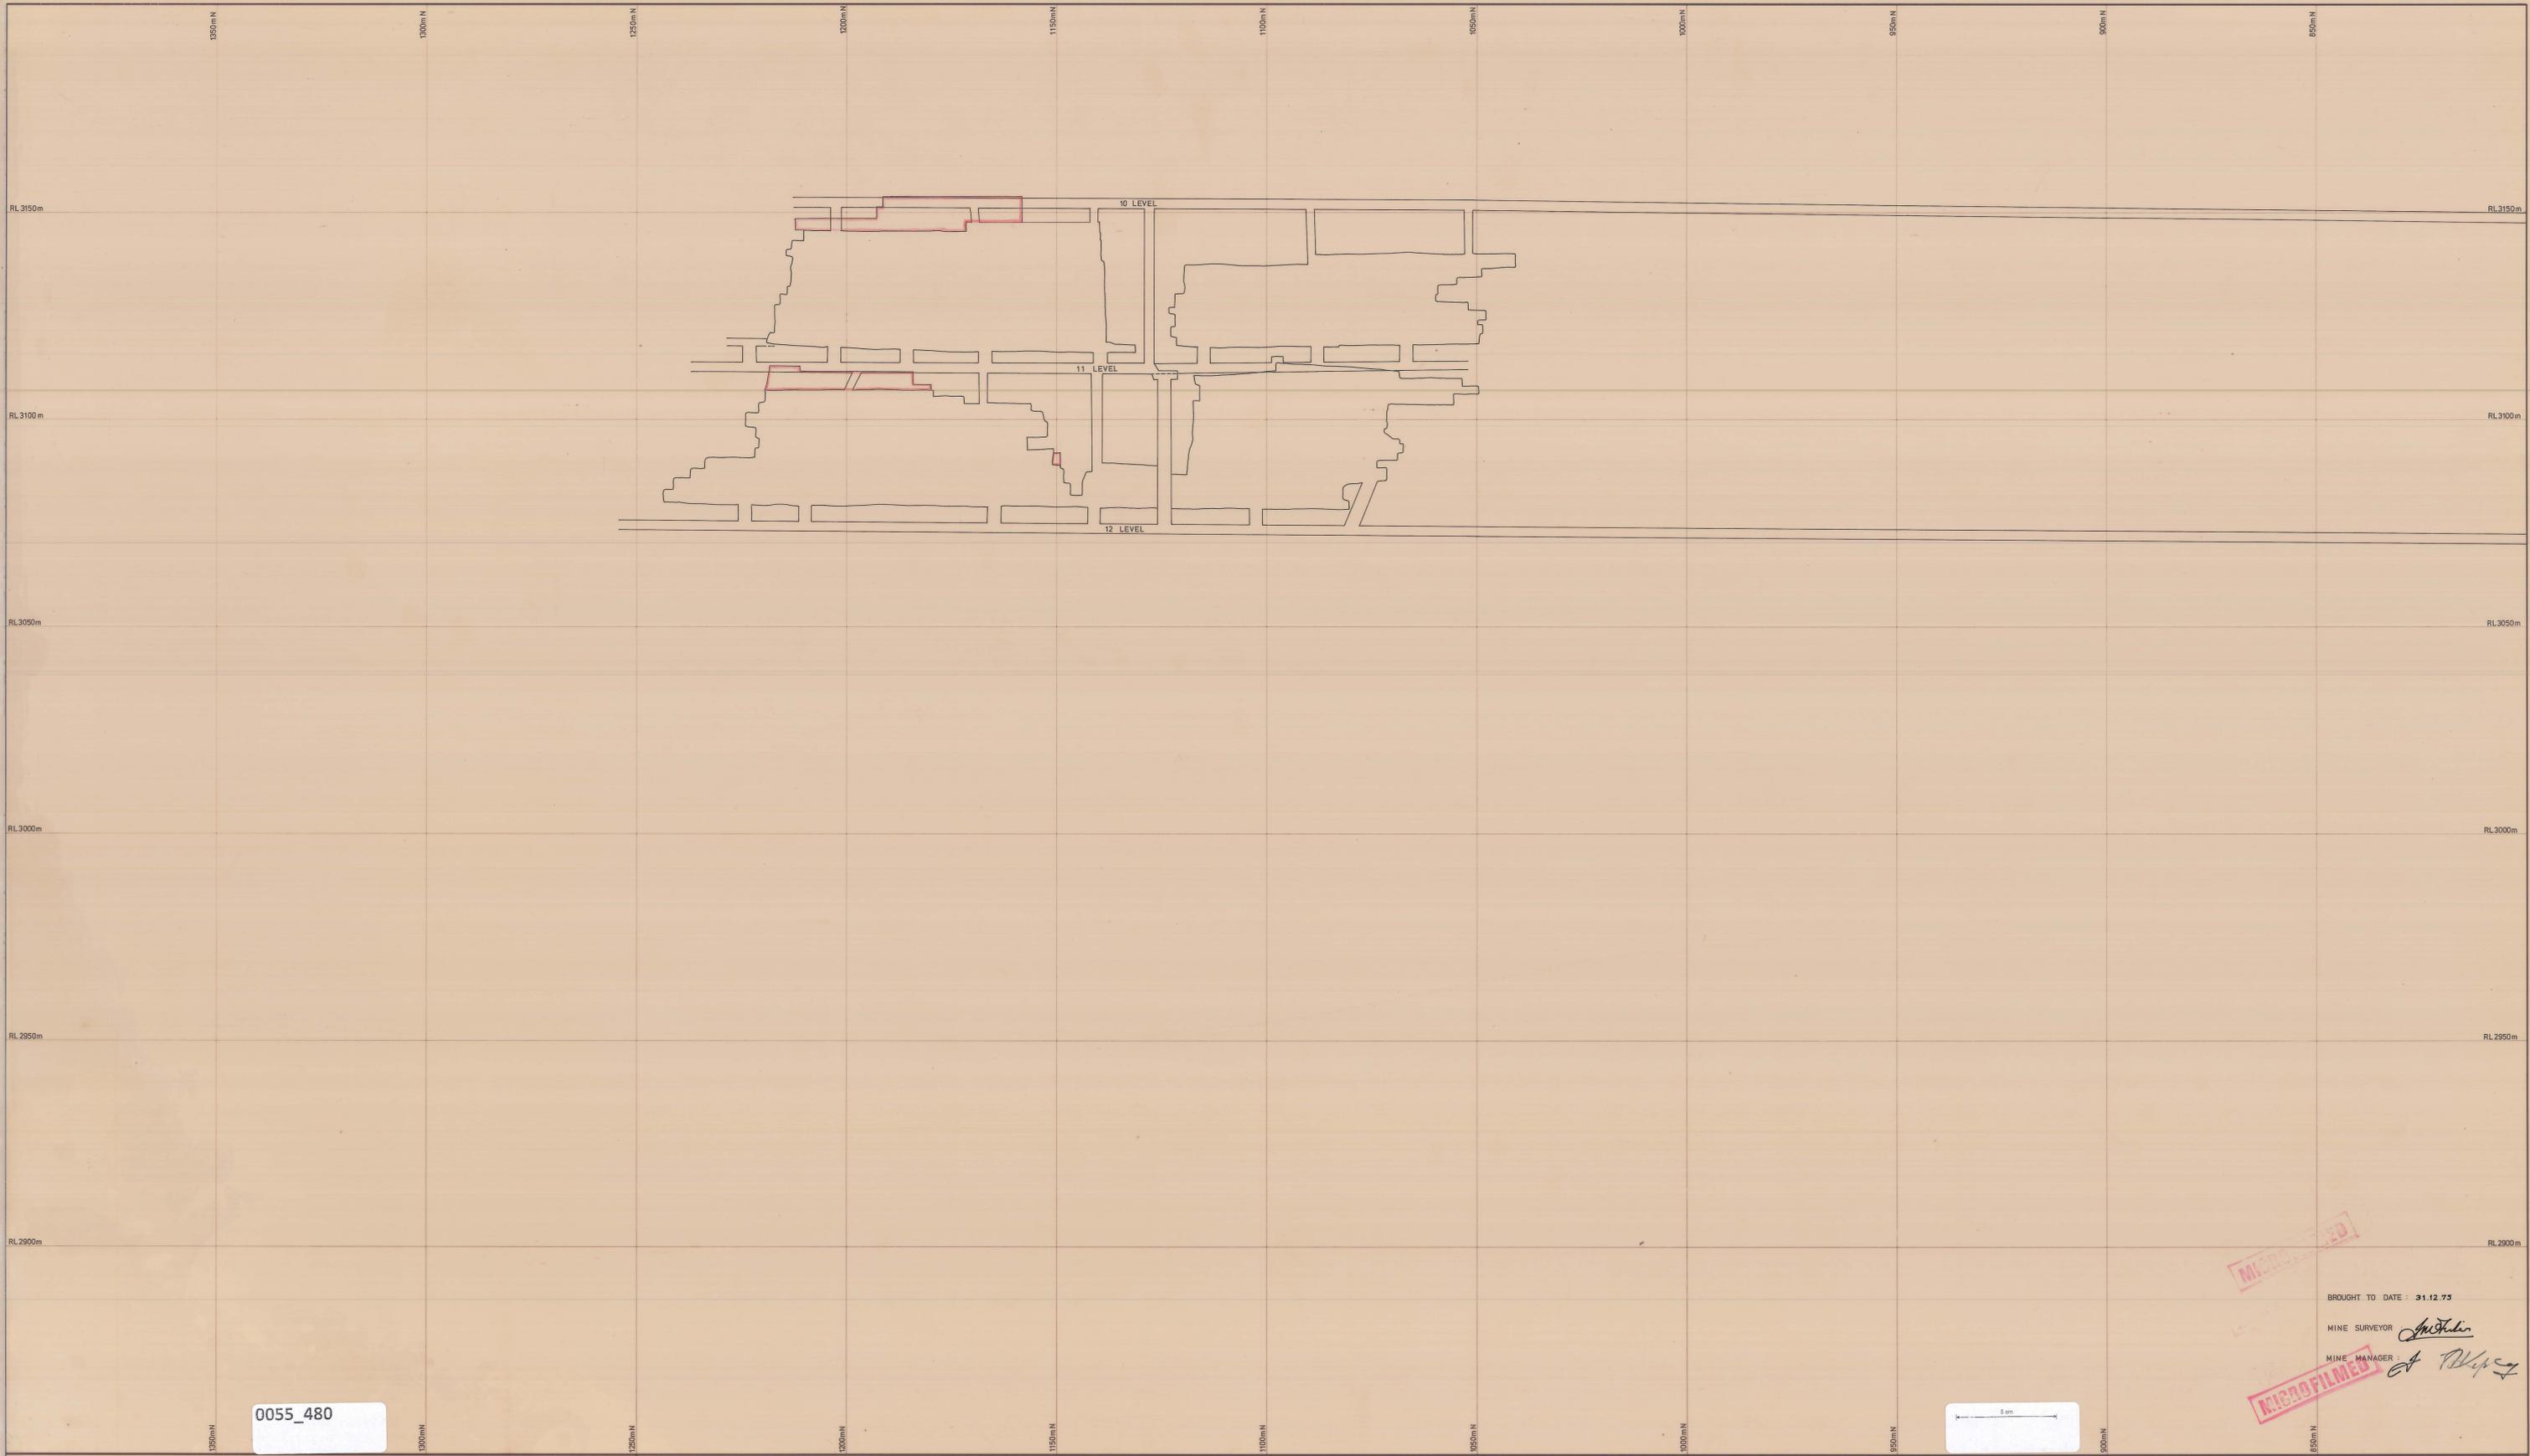

0055_480

MICROFILMED

MICROFILMED

BROUGHT TO DATE : 31.12.73

MINE SURVEYOR *[Signature]*

MINE MANAGER *[Signature]*



SCALE SHOWING 1:500 METRES AND EQUIVALENT FEET



ELECTROLYTIC ZINC COMPANY OF AUSTRALASIA LIMITED
WEST COAST MINES, T.A.S.

SURVEY BY	SCALE	1 : 500
DRAWN BY	DATE	1973
TRACED BY P. J. Lowe	REFERENCE	

ROSEBERY MINE
LONGITUDINAL PROJECTION
NORTH END - BELOW 10/L.

DRAWING N°:
DEPARTMENT OF MINES

78016