


0055_482



0055_482

BROUGHT TO DATE : 31.12.75
 MINE MANAGER : *[Signature]*
 MINE SURVEYOR : *[Signature]*

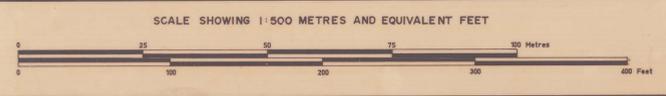

ELECTROLYTIC ZINC COMPANY OF AUSTRALASIA LIMITED
 WEST COAST MINES, T.A.S.

SURVEY BY		SCALE	1 : 500
DRAWN BY		DATE	1973
TRACED BY	P.J. Lowe	REFERENCE	

ROSEBERY MINE
 LONGITUDINAL PROJECTION
 200m N-800m N — ABOVE 10/L.

DRAWING N^o :
 DEPARTMENT OF MINES

78074