


0002/0019


0055_505

DO NOT SCALE

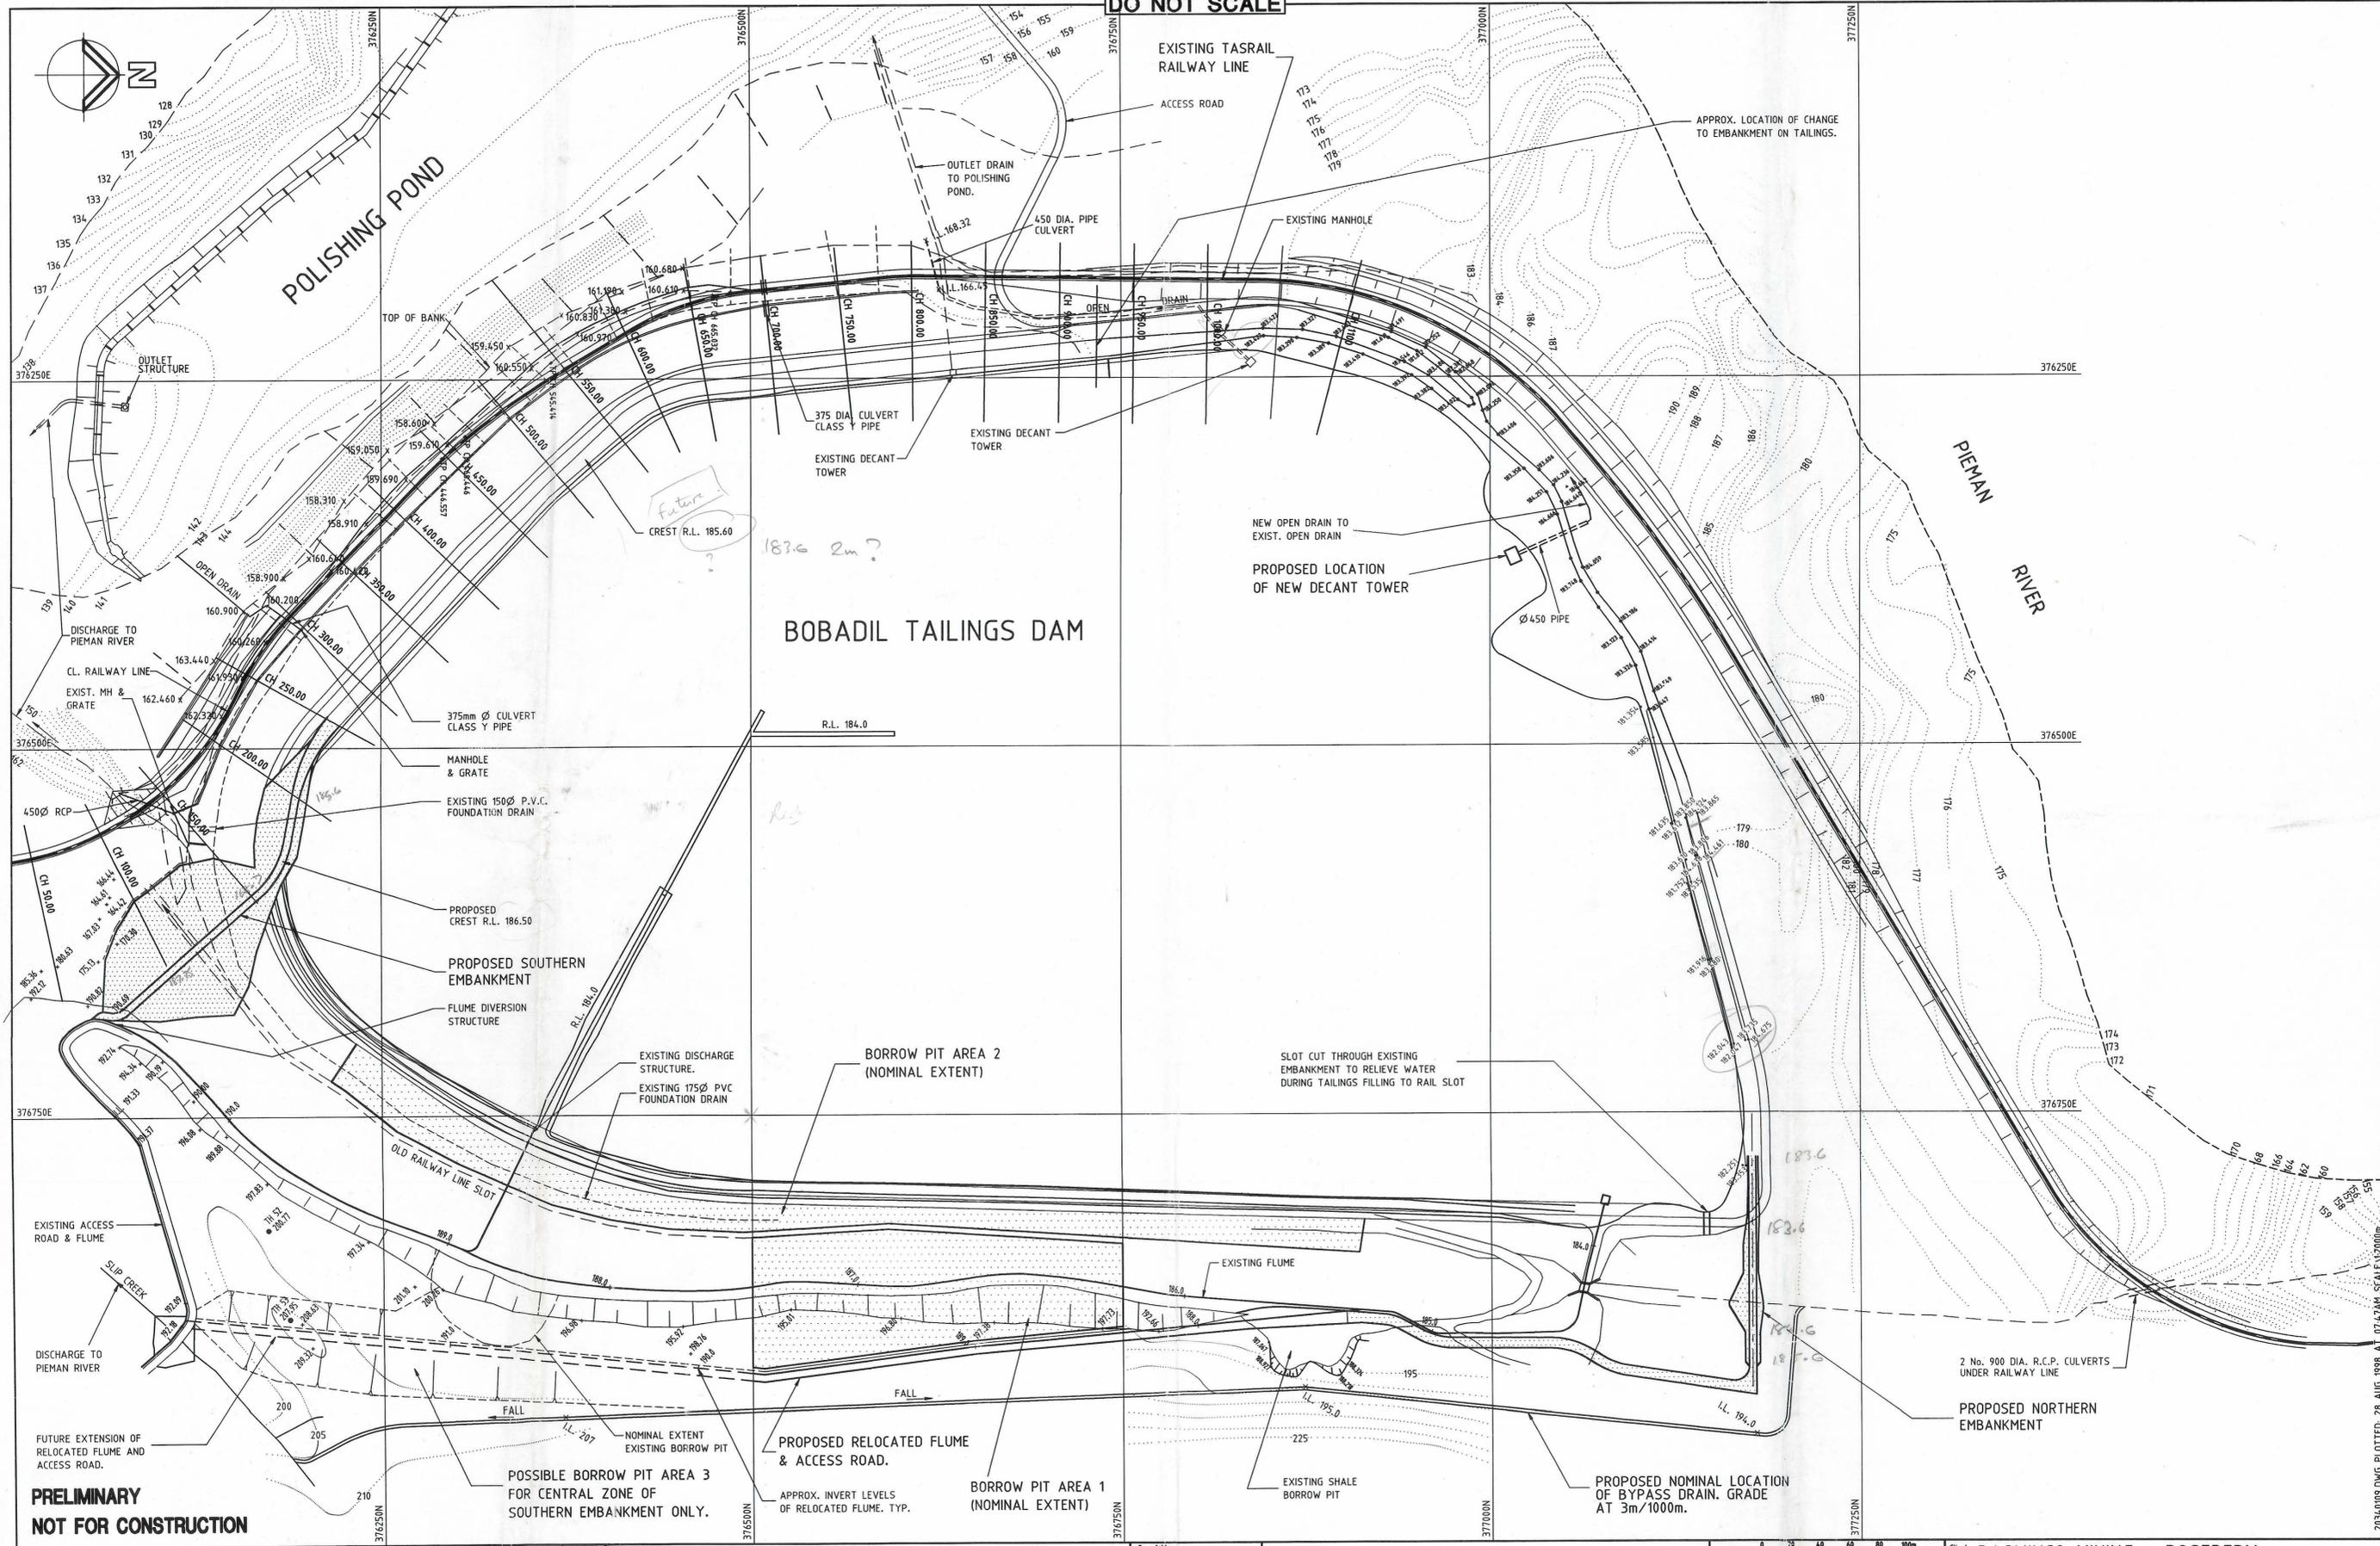

PRELIMINARY
NOT FOR CONSTRUCTION

No.	Revision	Engineer	Approved	Date	M/Firm

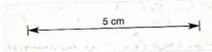

Copyright
This document is the property of
Gutteridge Haskins & Davey
Pty. Ltd. The document may
only be used for the purpose
for which it was commissioned
& in accordance with the terms
of engagement for the commission.
Unauthorized use of this document
in any way is prohibited.

Drawing File No.
3212034.0100/2034.0109.DWG

GHD Gutteridge Haskins & Davey Pty Ltd
INCORPORATING THE PRACTICE OF SMITH, SALE AND BURBURY
CONSULTING ENGINEERS • ENVIRONMENTAL SCIENTISTS & PLANNERS • PROJECT MANAGERS
ACN 008 488 373

83A Wilson Street, Burnie, Tasmania 7320
Telephone (03) 6431 4884 Facsimile (03) 6431 4042

Scale	0 20 40 60 80 100m (1:2000 or A1 Size Plot)
Drawn/Traced	LPW 27-E-98
Engineer design	MAC 27-B-98
Draft Check	Engineer Check
Approved	

Client and Job
**PASMINCO MINING - ROSEBERY
BOBADIL TAILINGS DAM - STAGE 3**

Title
**NORTHERN & SOUTHERN EMBANKMENTS
LAYOUT PLAN**

Size
A1

Drg. No.
2034 - 01 - 09

Rev
A

2034.0109.DWG PLOTTED: 28 AUG 1998 AT 07:47AM SCALE 1:2000