



X2-55

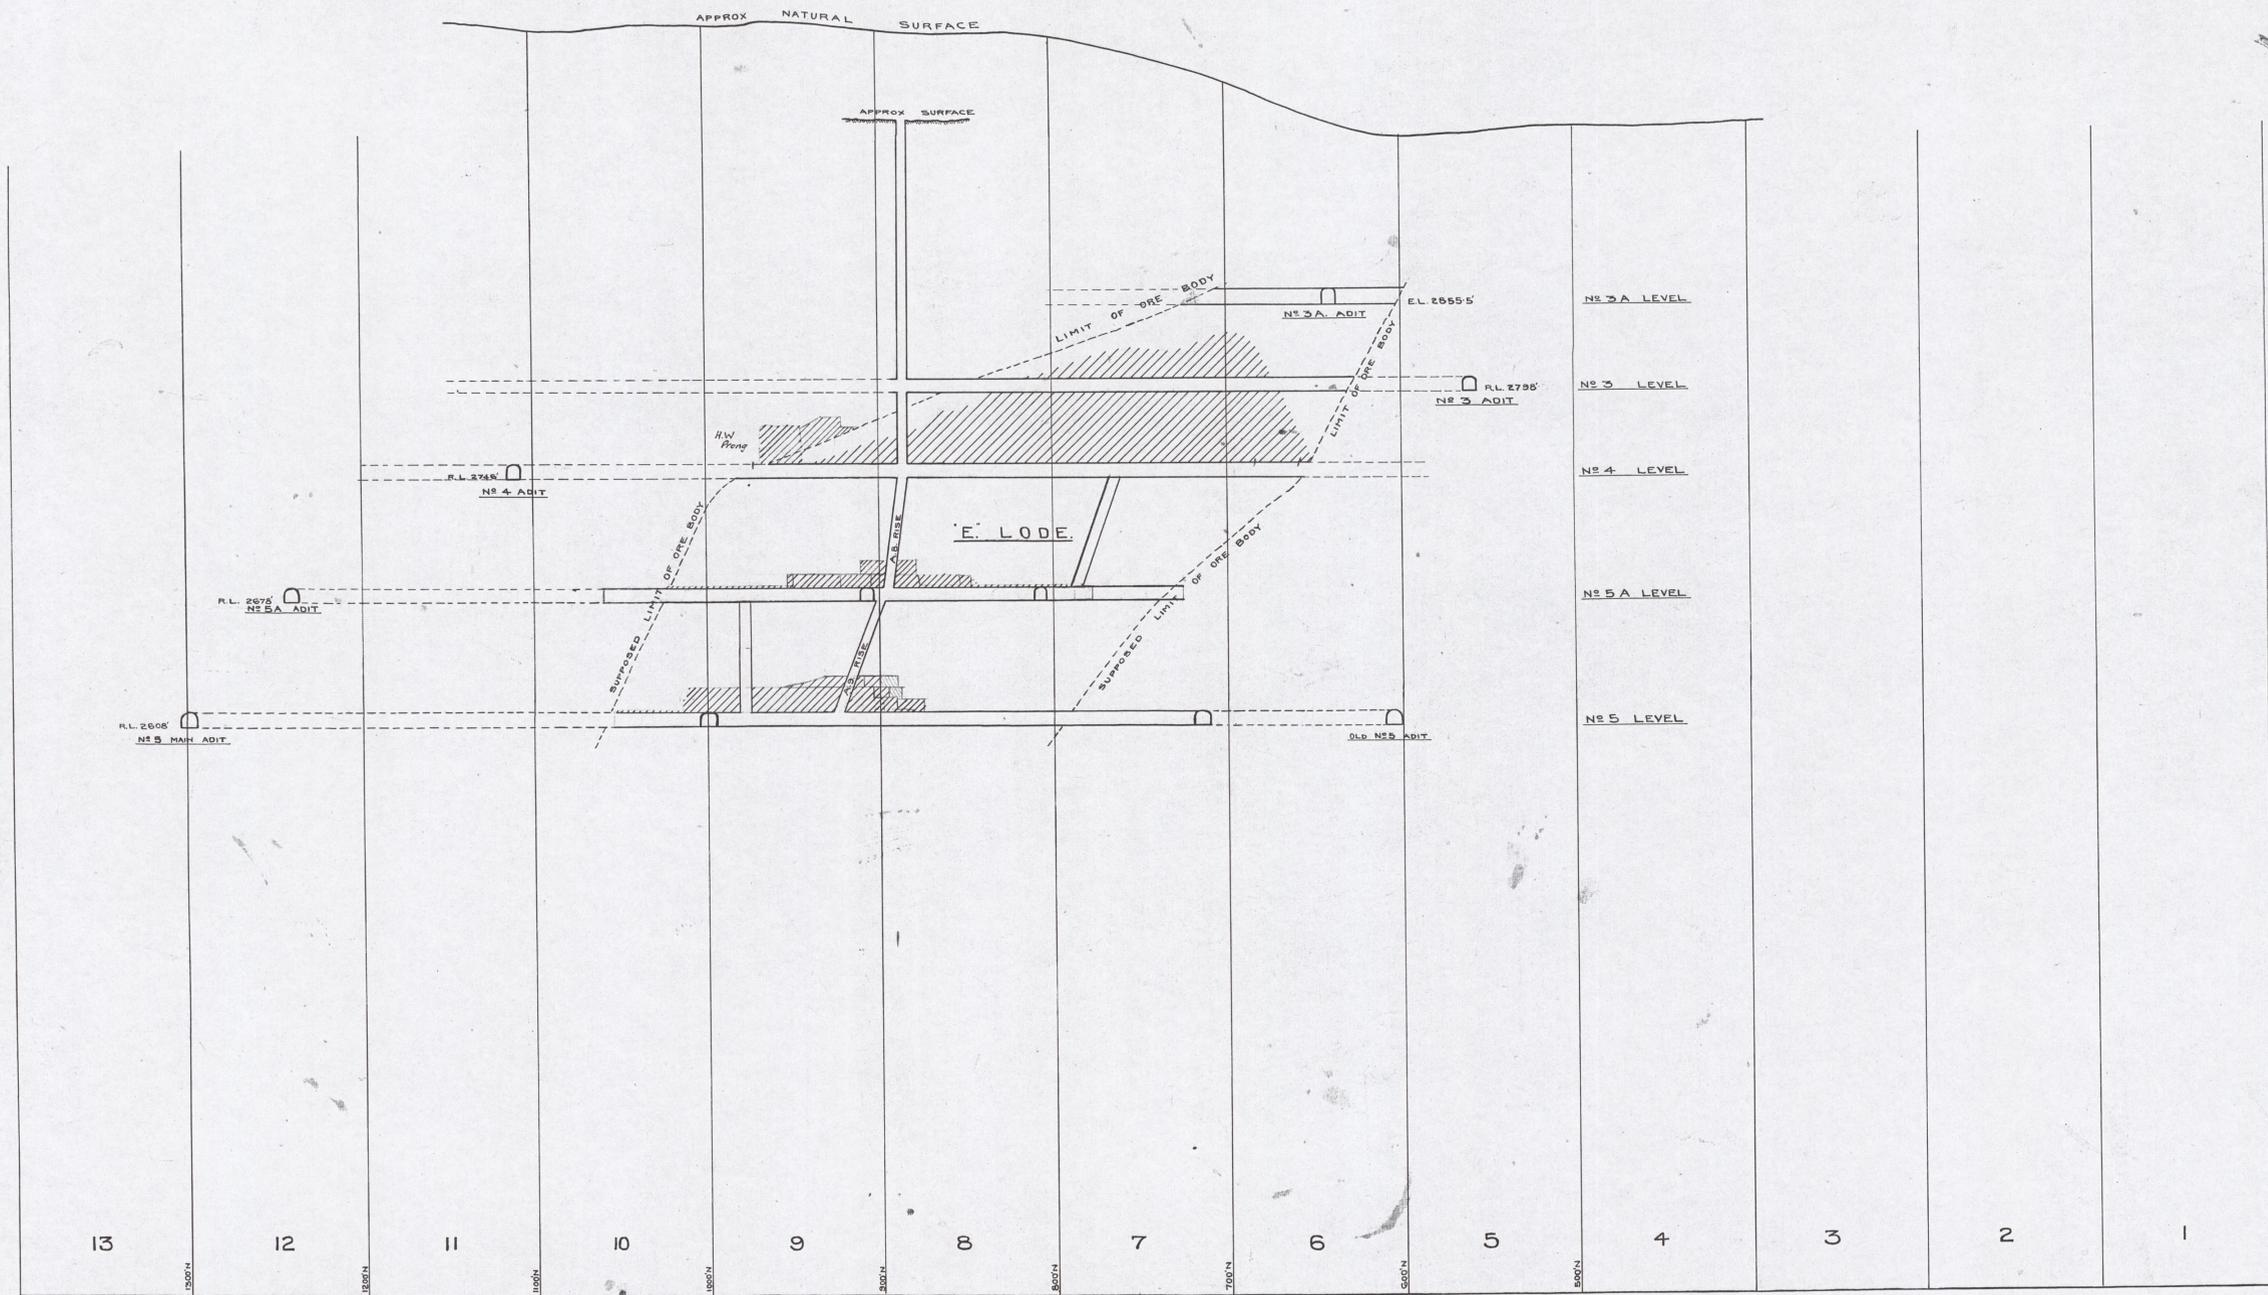

ELECTROLYTIC ZINC CO OF AUSTRALASIA LTD
 HOBART TASMANIA
 WEST COAST DEPARTMENT MINES
 HERCULES MINE
 LONGITUDINAL SECTION OF WORKINGS E. LODE.
 SCALE 1" = 50'

WORK DONE FROM [] TO [] SHOWN IN RED

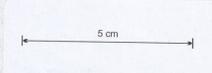

SCALE 1" = 50'
 X2-

Long Proj
 E Lode

0055 -
 699