

ELECTROLYTIC ZINC COMPANY OF AUSTRALASIA LTD

HERCULES MINE
LONGITUDINAL SECTIONS

SCALE 40 FT. TO IN

Note - Datum = Sea level


Drawing and tracing by F.G. Burns 19-1-28

A. Clark Chief Surveyor


Reference
Hanging-wall crosscuts
Footwall
Slopes

Work done from [] to [] shown in red


Note - Sections taken parallel to N.S. co-ordinates
North footwall slopes 'E' lode shown dotted

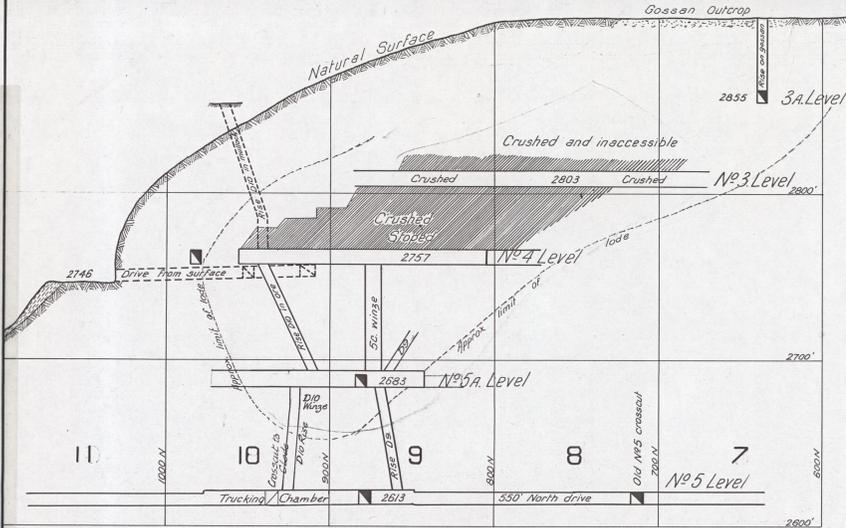


"C" LODE

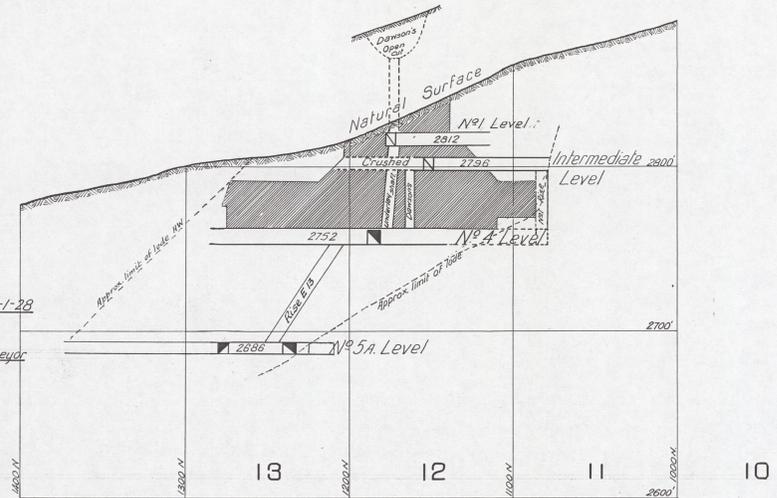


"F" LODE

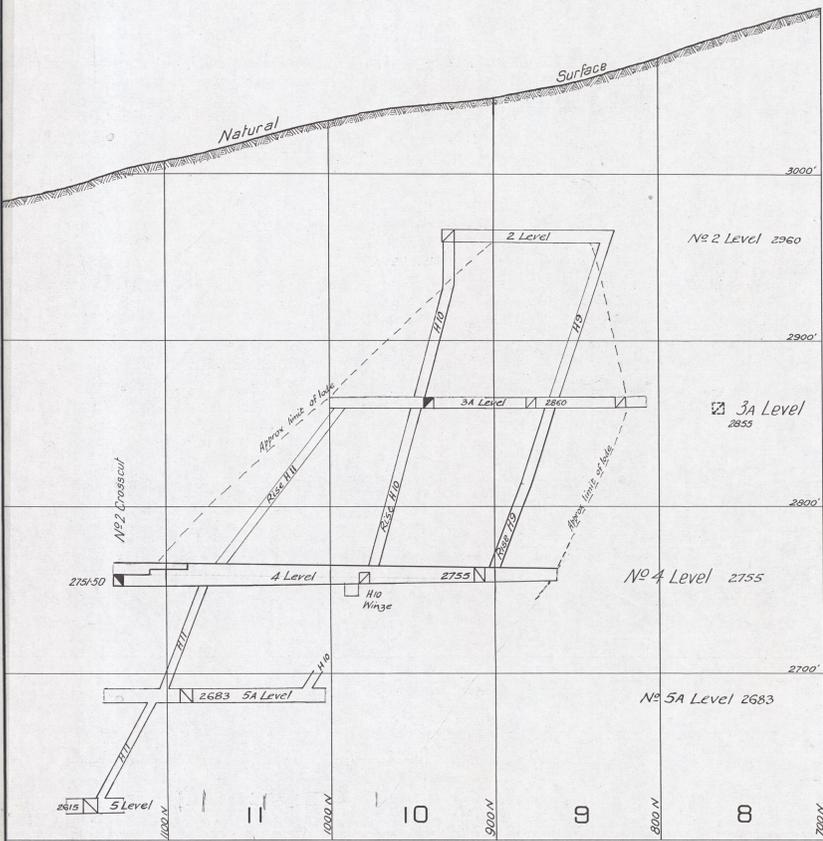

"G" LODE

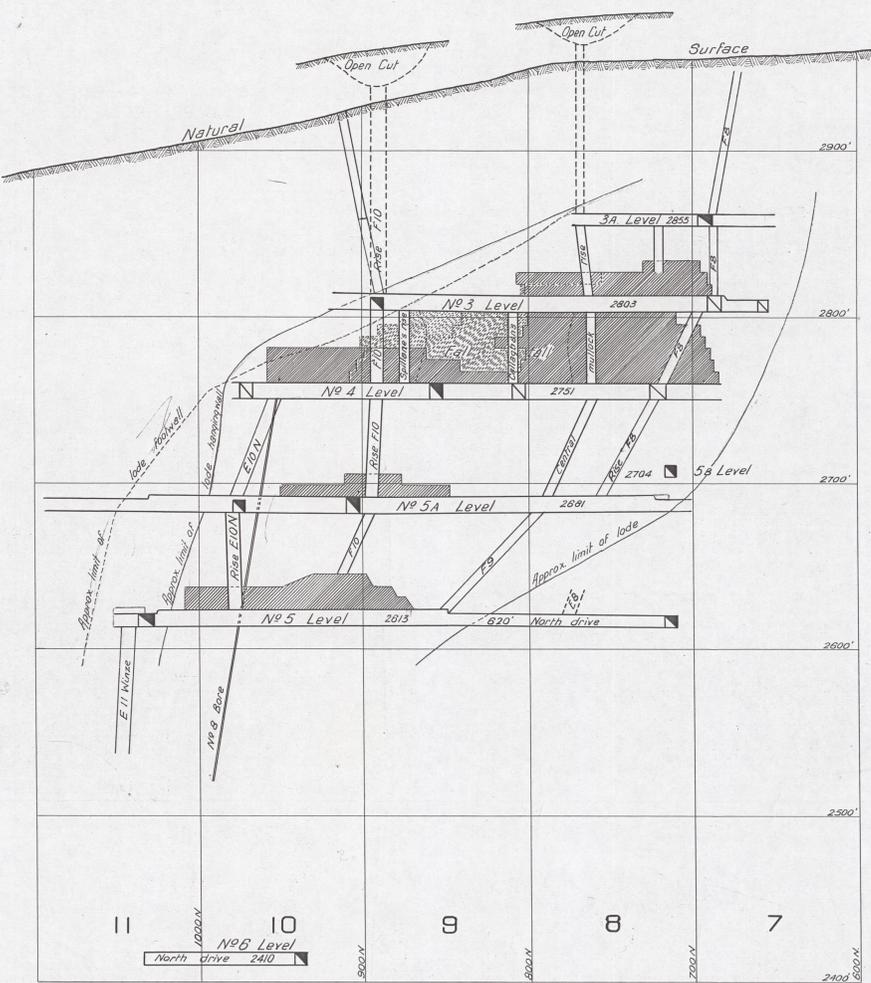

"E" LODE

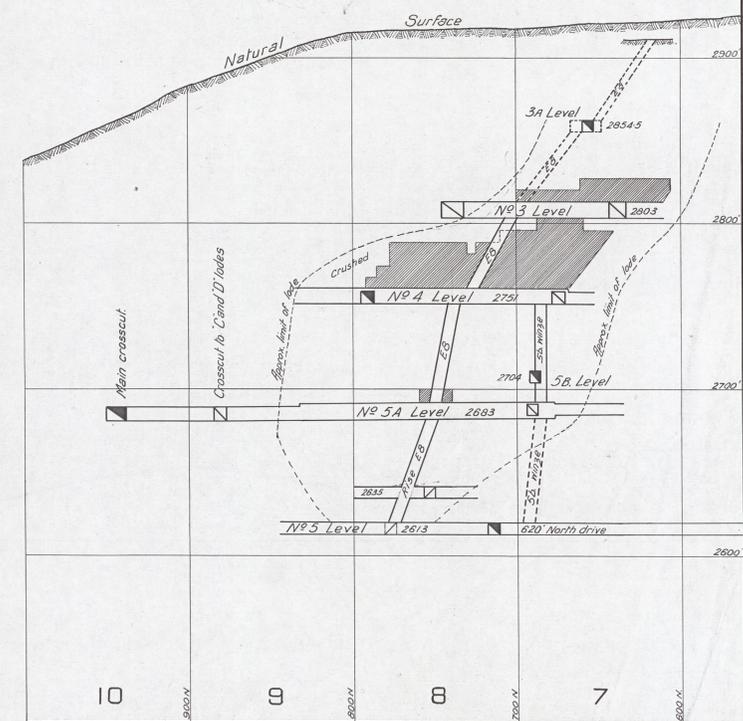

"B" LODE

X2R-8

Long Section
G, C, E, B, & F Lodes

0055 -
702

5m