


0055 -
704

Development
1" = 40'

6 Level

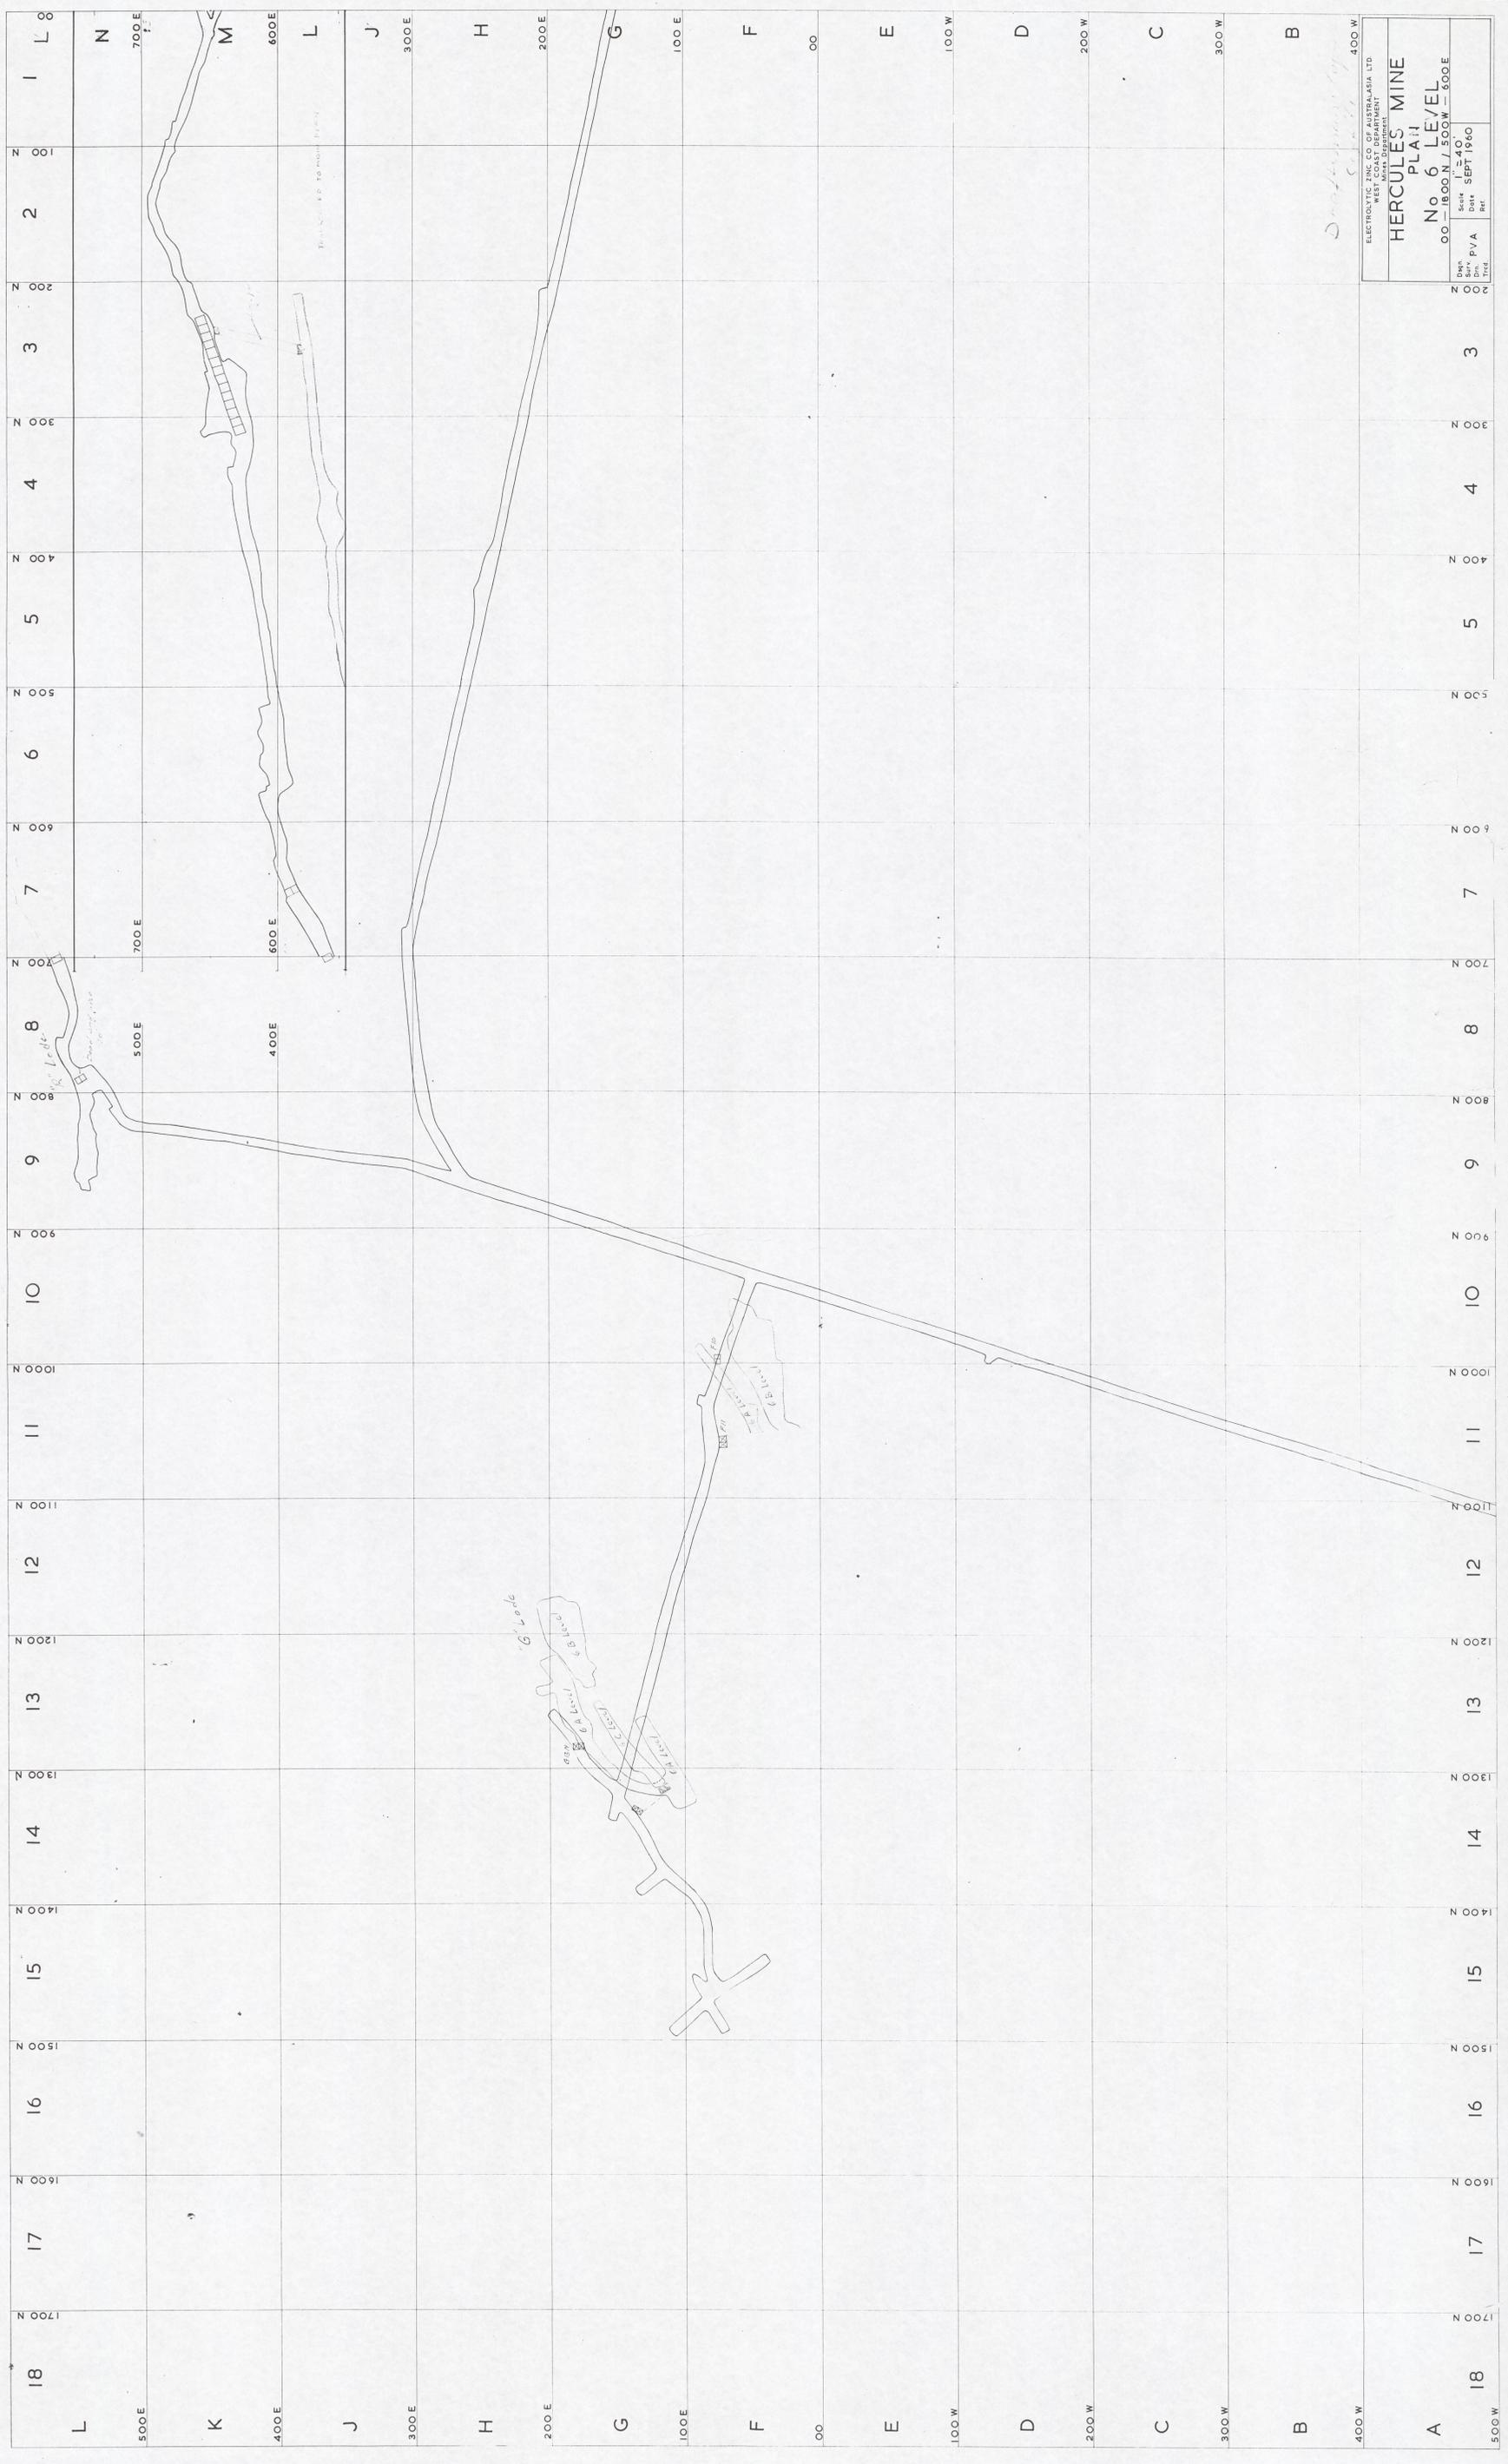

ELECTRONIC SYSTEMS DIVISION
 HERCULES MINE
 No. 6 LEVEL
 Scale 1" = 40'
 Date SEPT 1960
 Ref. 00-1800N/500W-500E