


0055-705

1964

6 Level Development

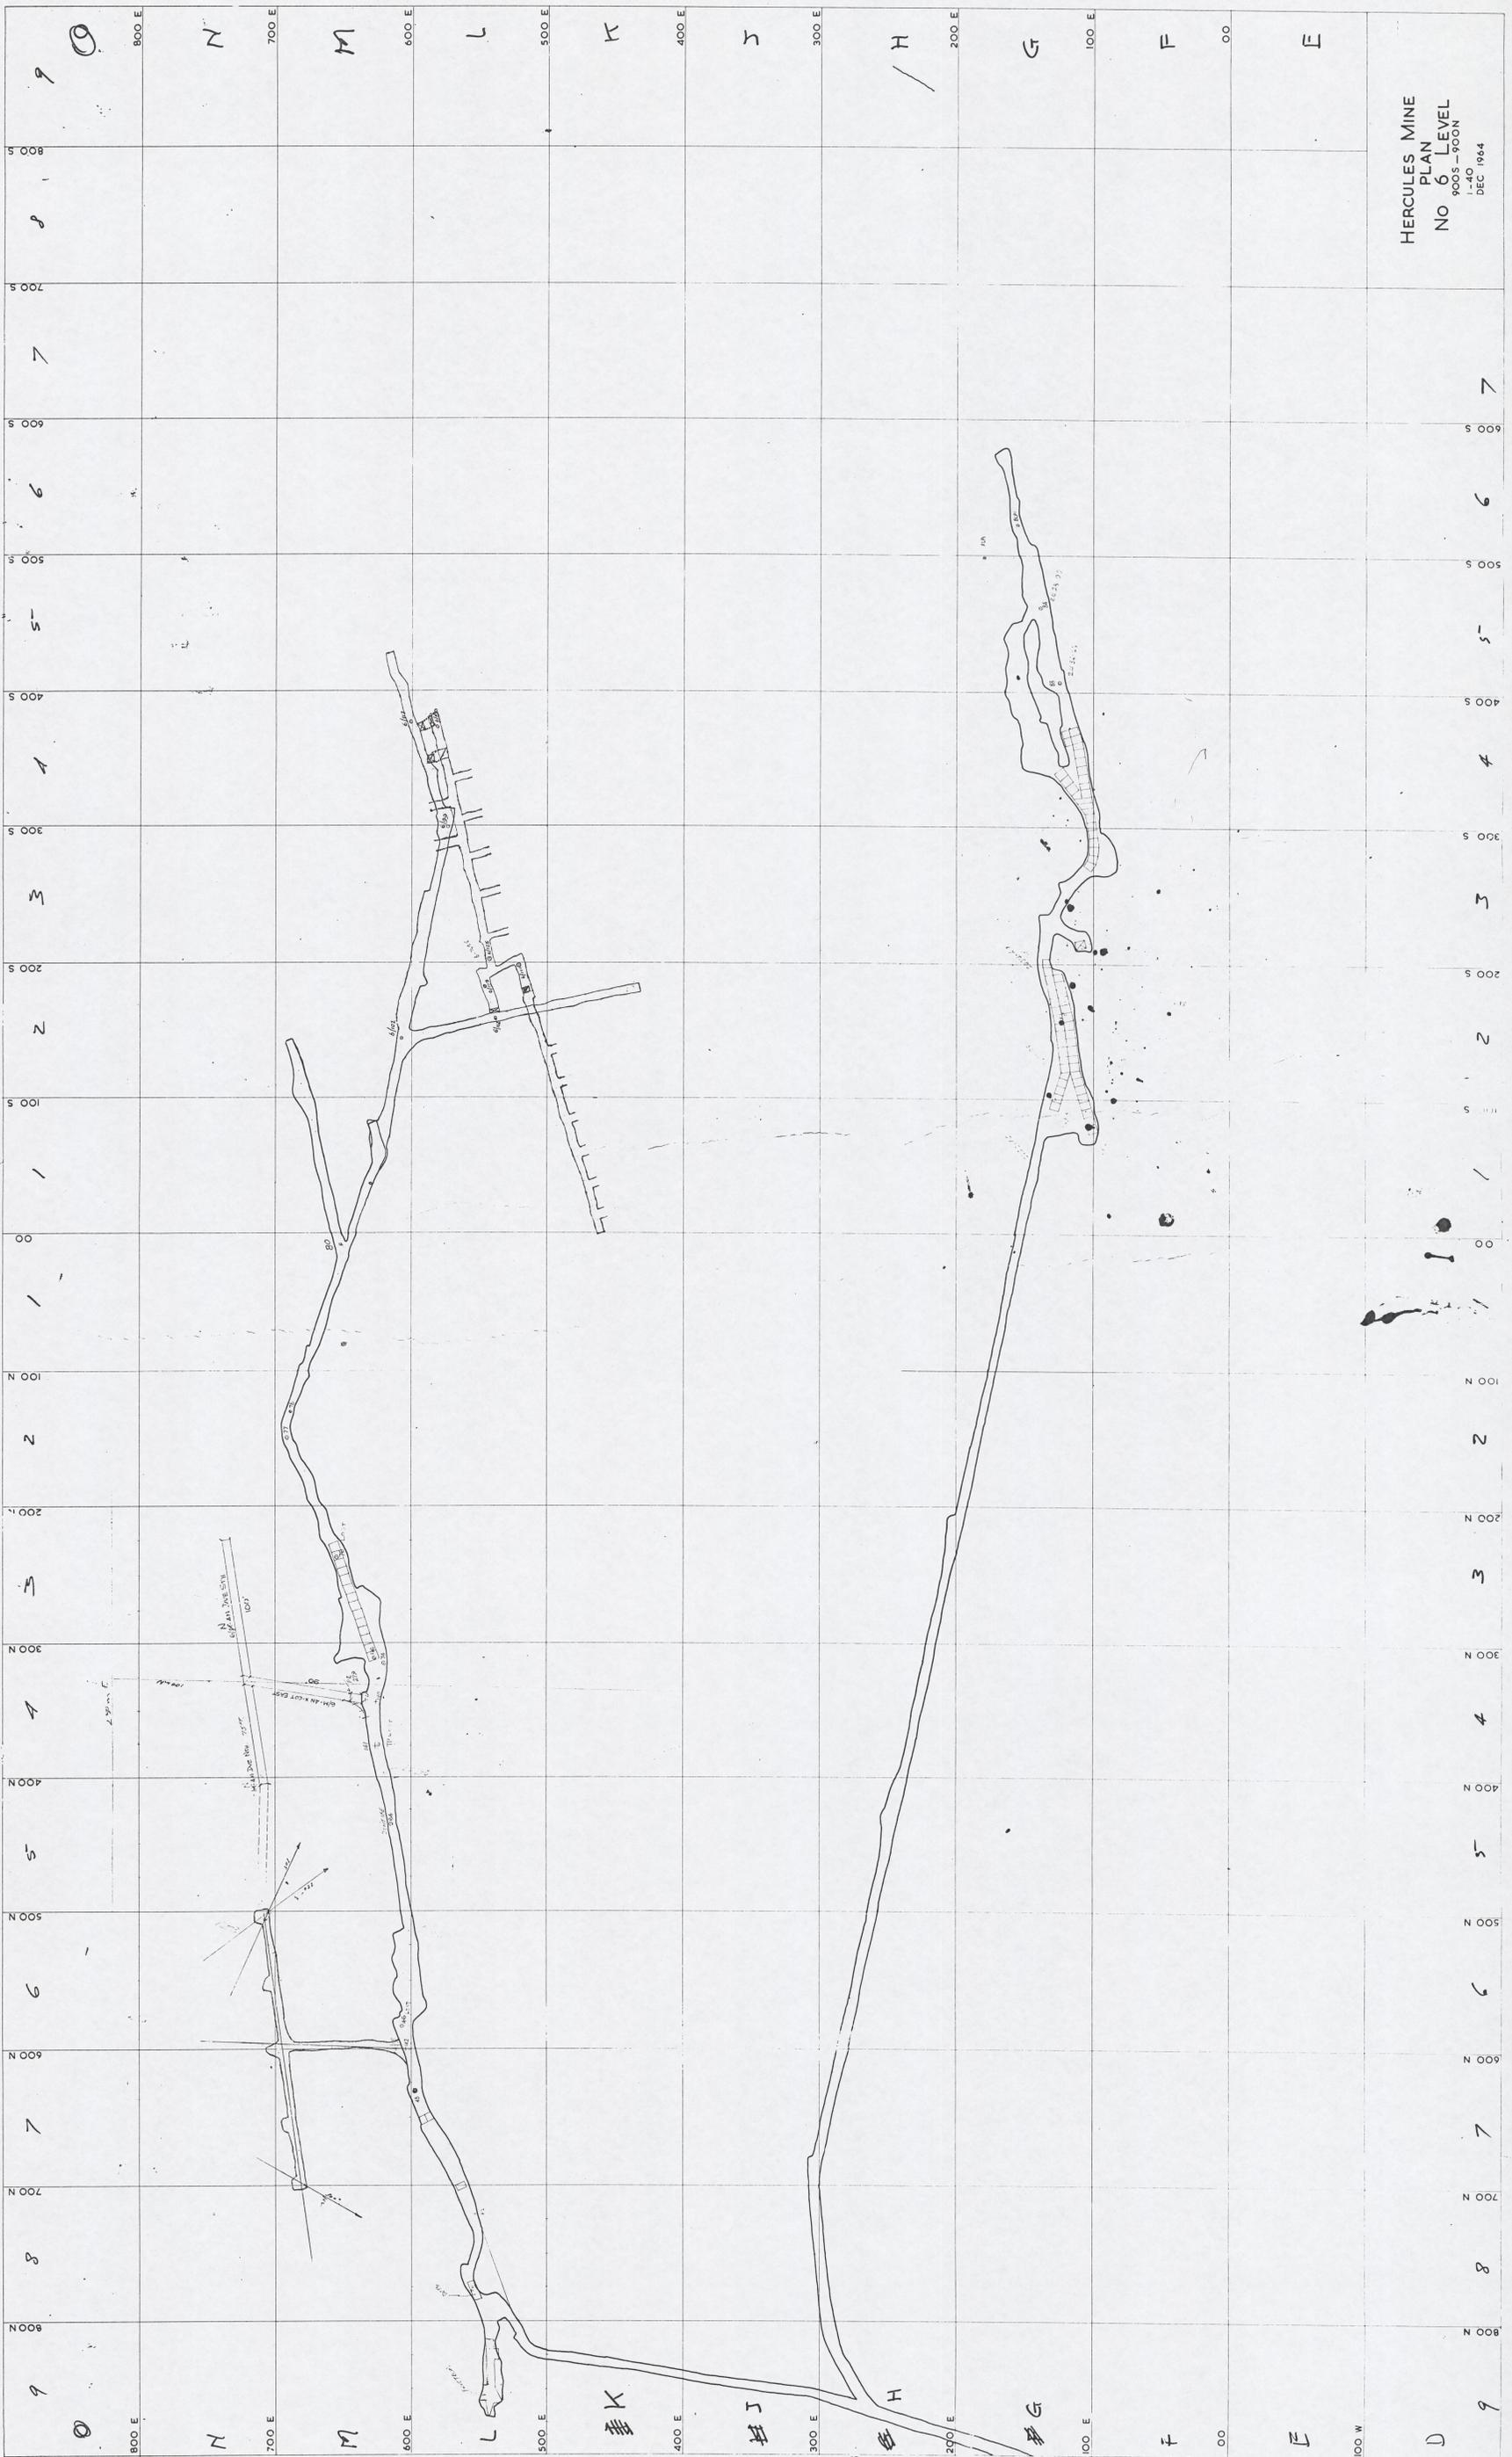

HERCULES MINE  
 PLAN  
 NO 6 LEVEL  
 9005-900N  
 1-40  
 DEC 1964