


AH502-0001

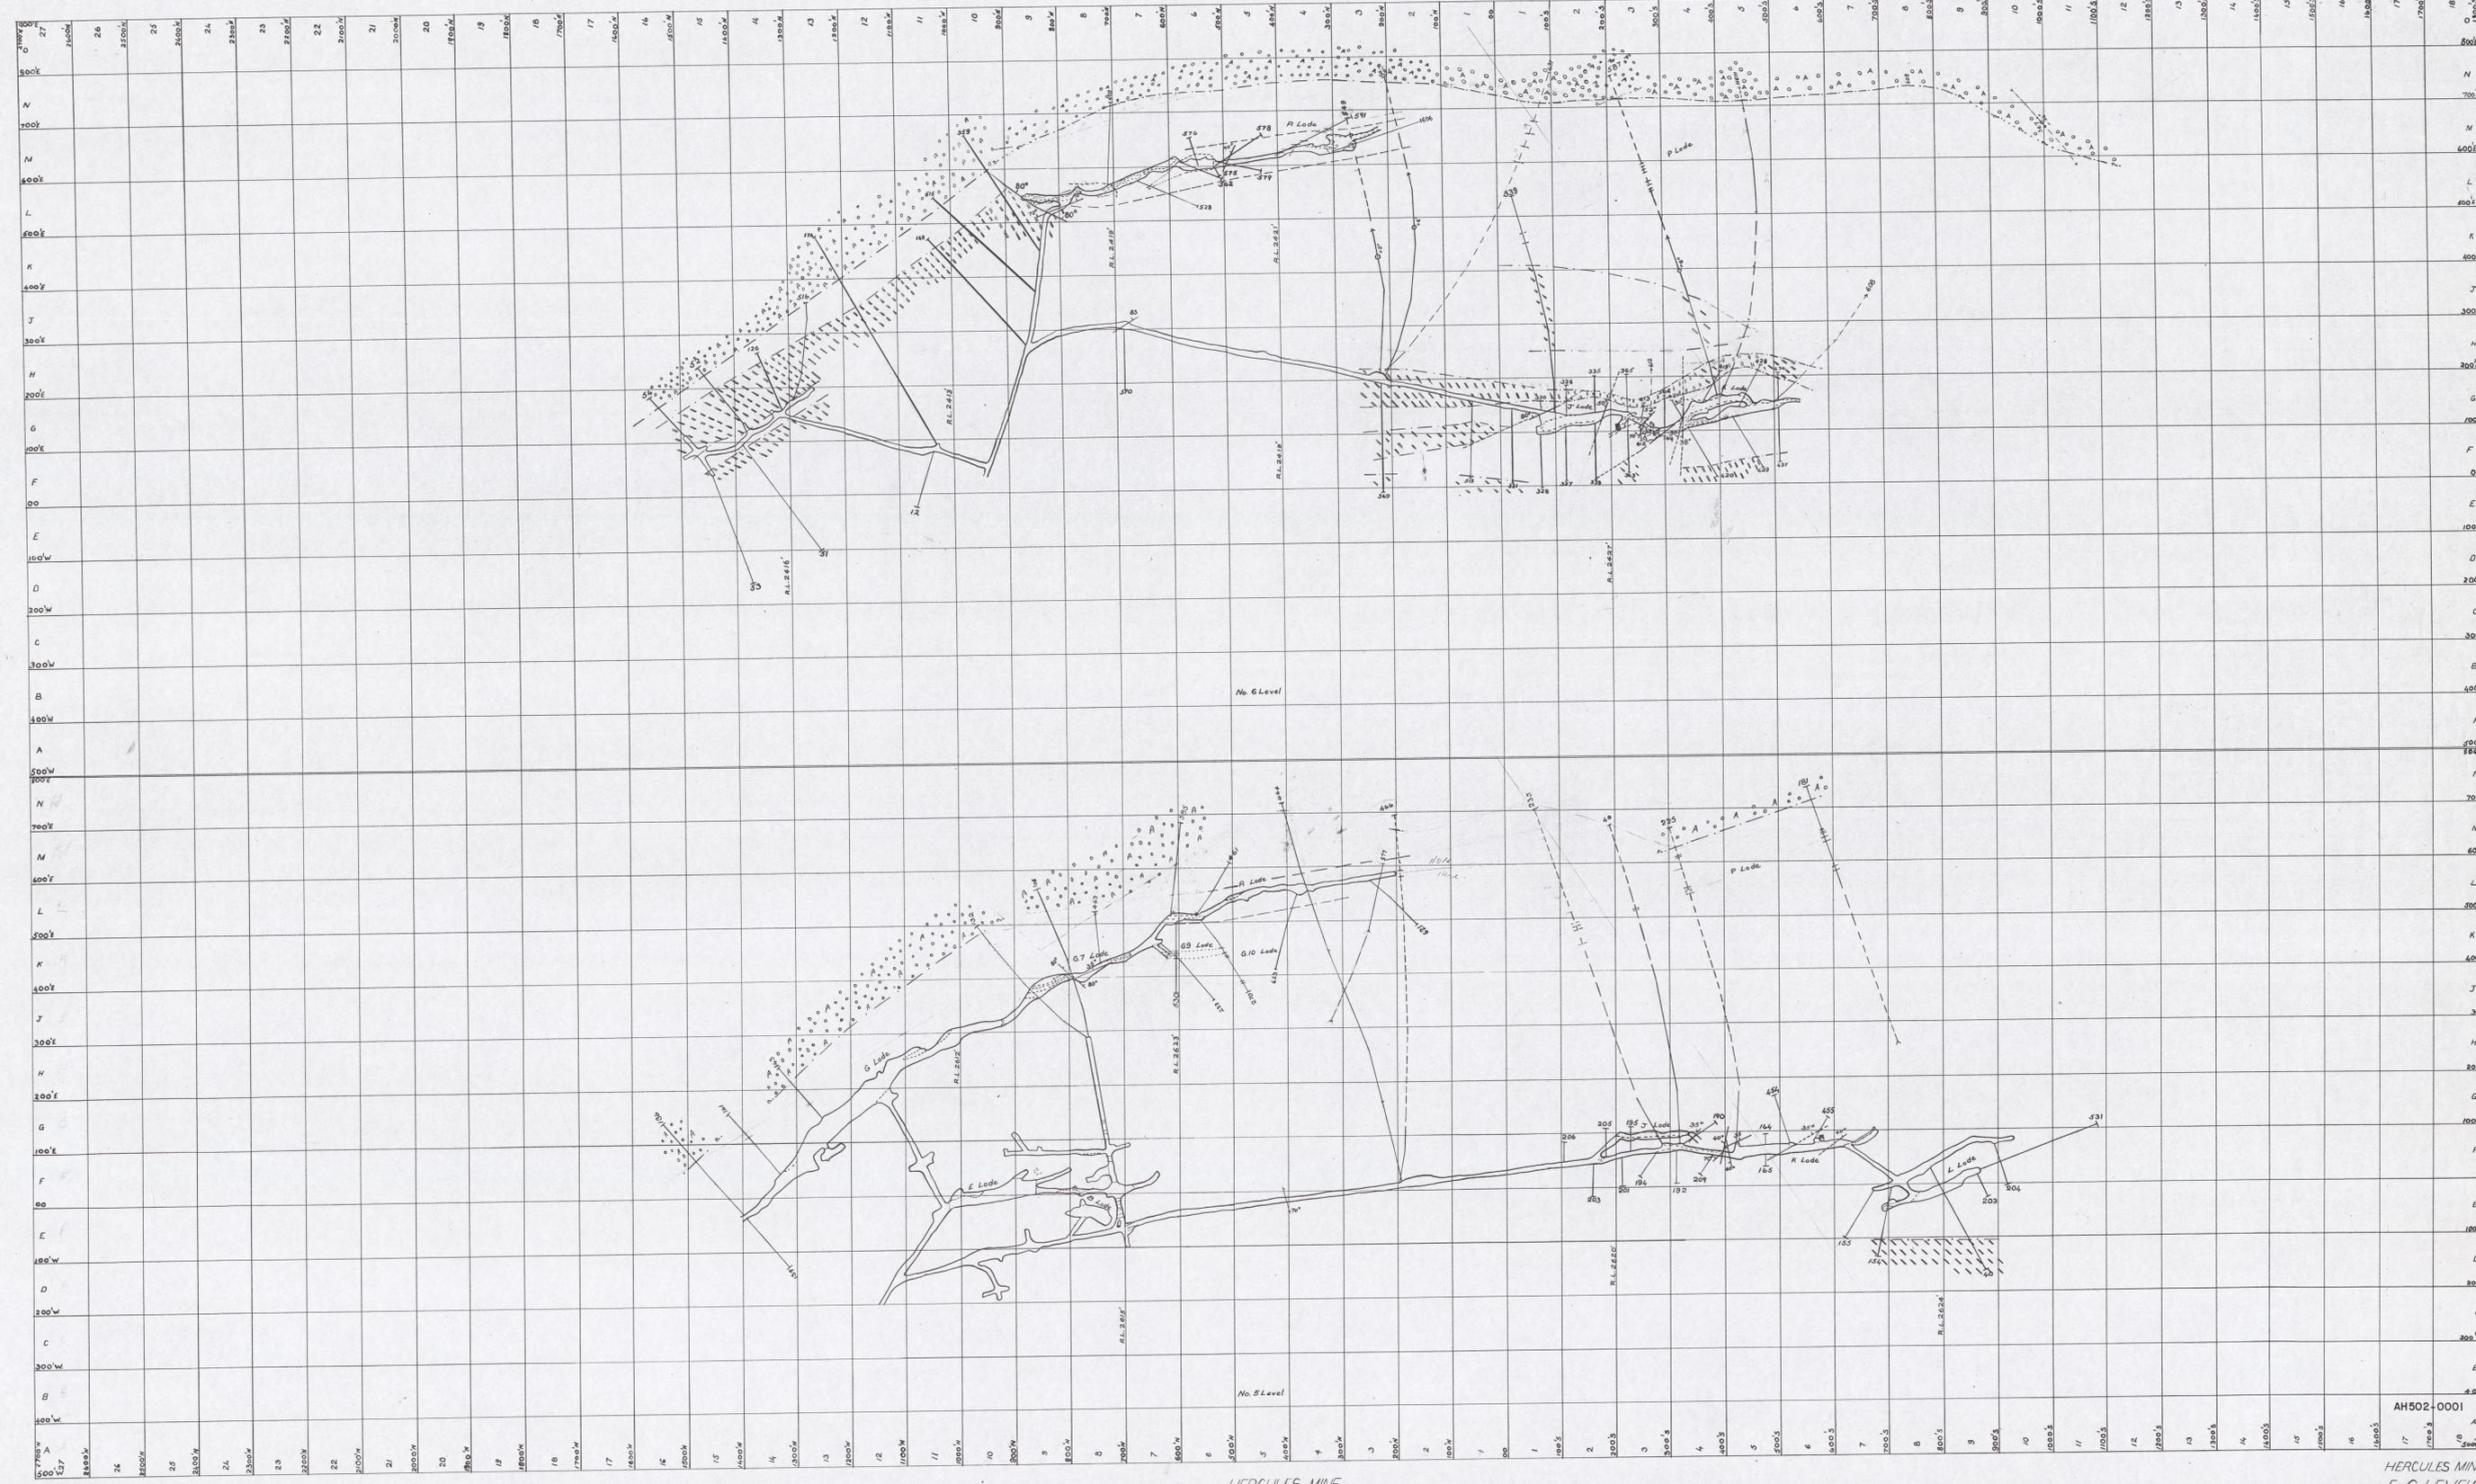

6 + 5 Level
Geology Interp.

1" = 100'

0055 -
710

ELECTROLYTIC ZINC CO OF ASIA

GEOLOGICAL DEPARTMENT

Hercules Grid

HERCULES MINE
5-6 LEVELS

Scale 1"=100'

AH502-0001

HERCULES MINE
5-6 LEVELS
No. 3536