


0055-729

3A-4 Levels  
Composite Plan

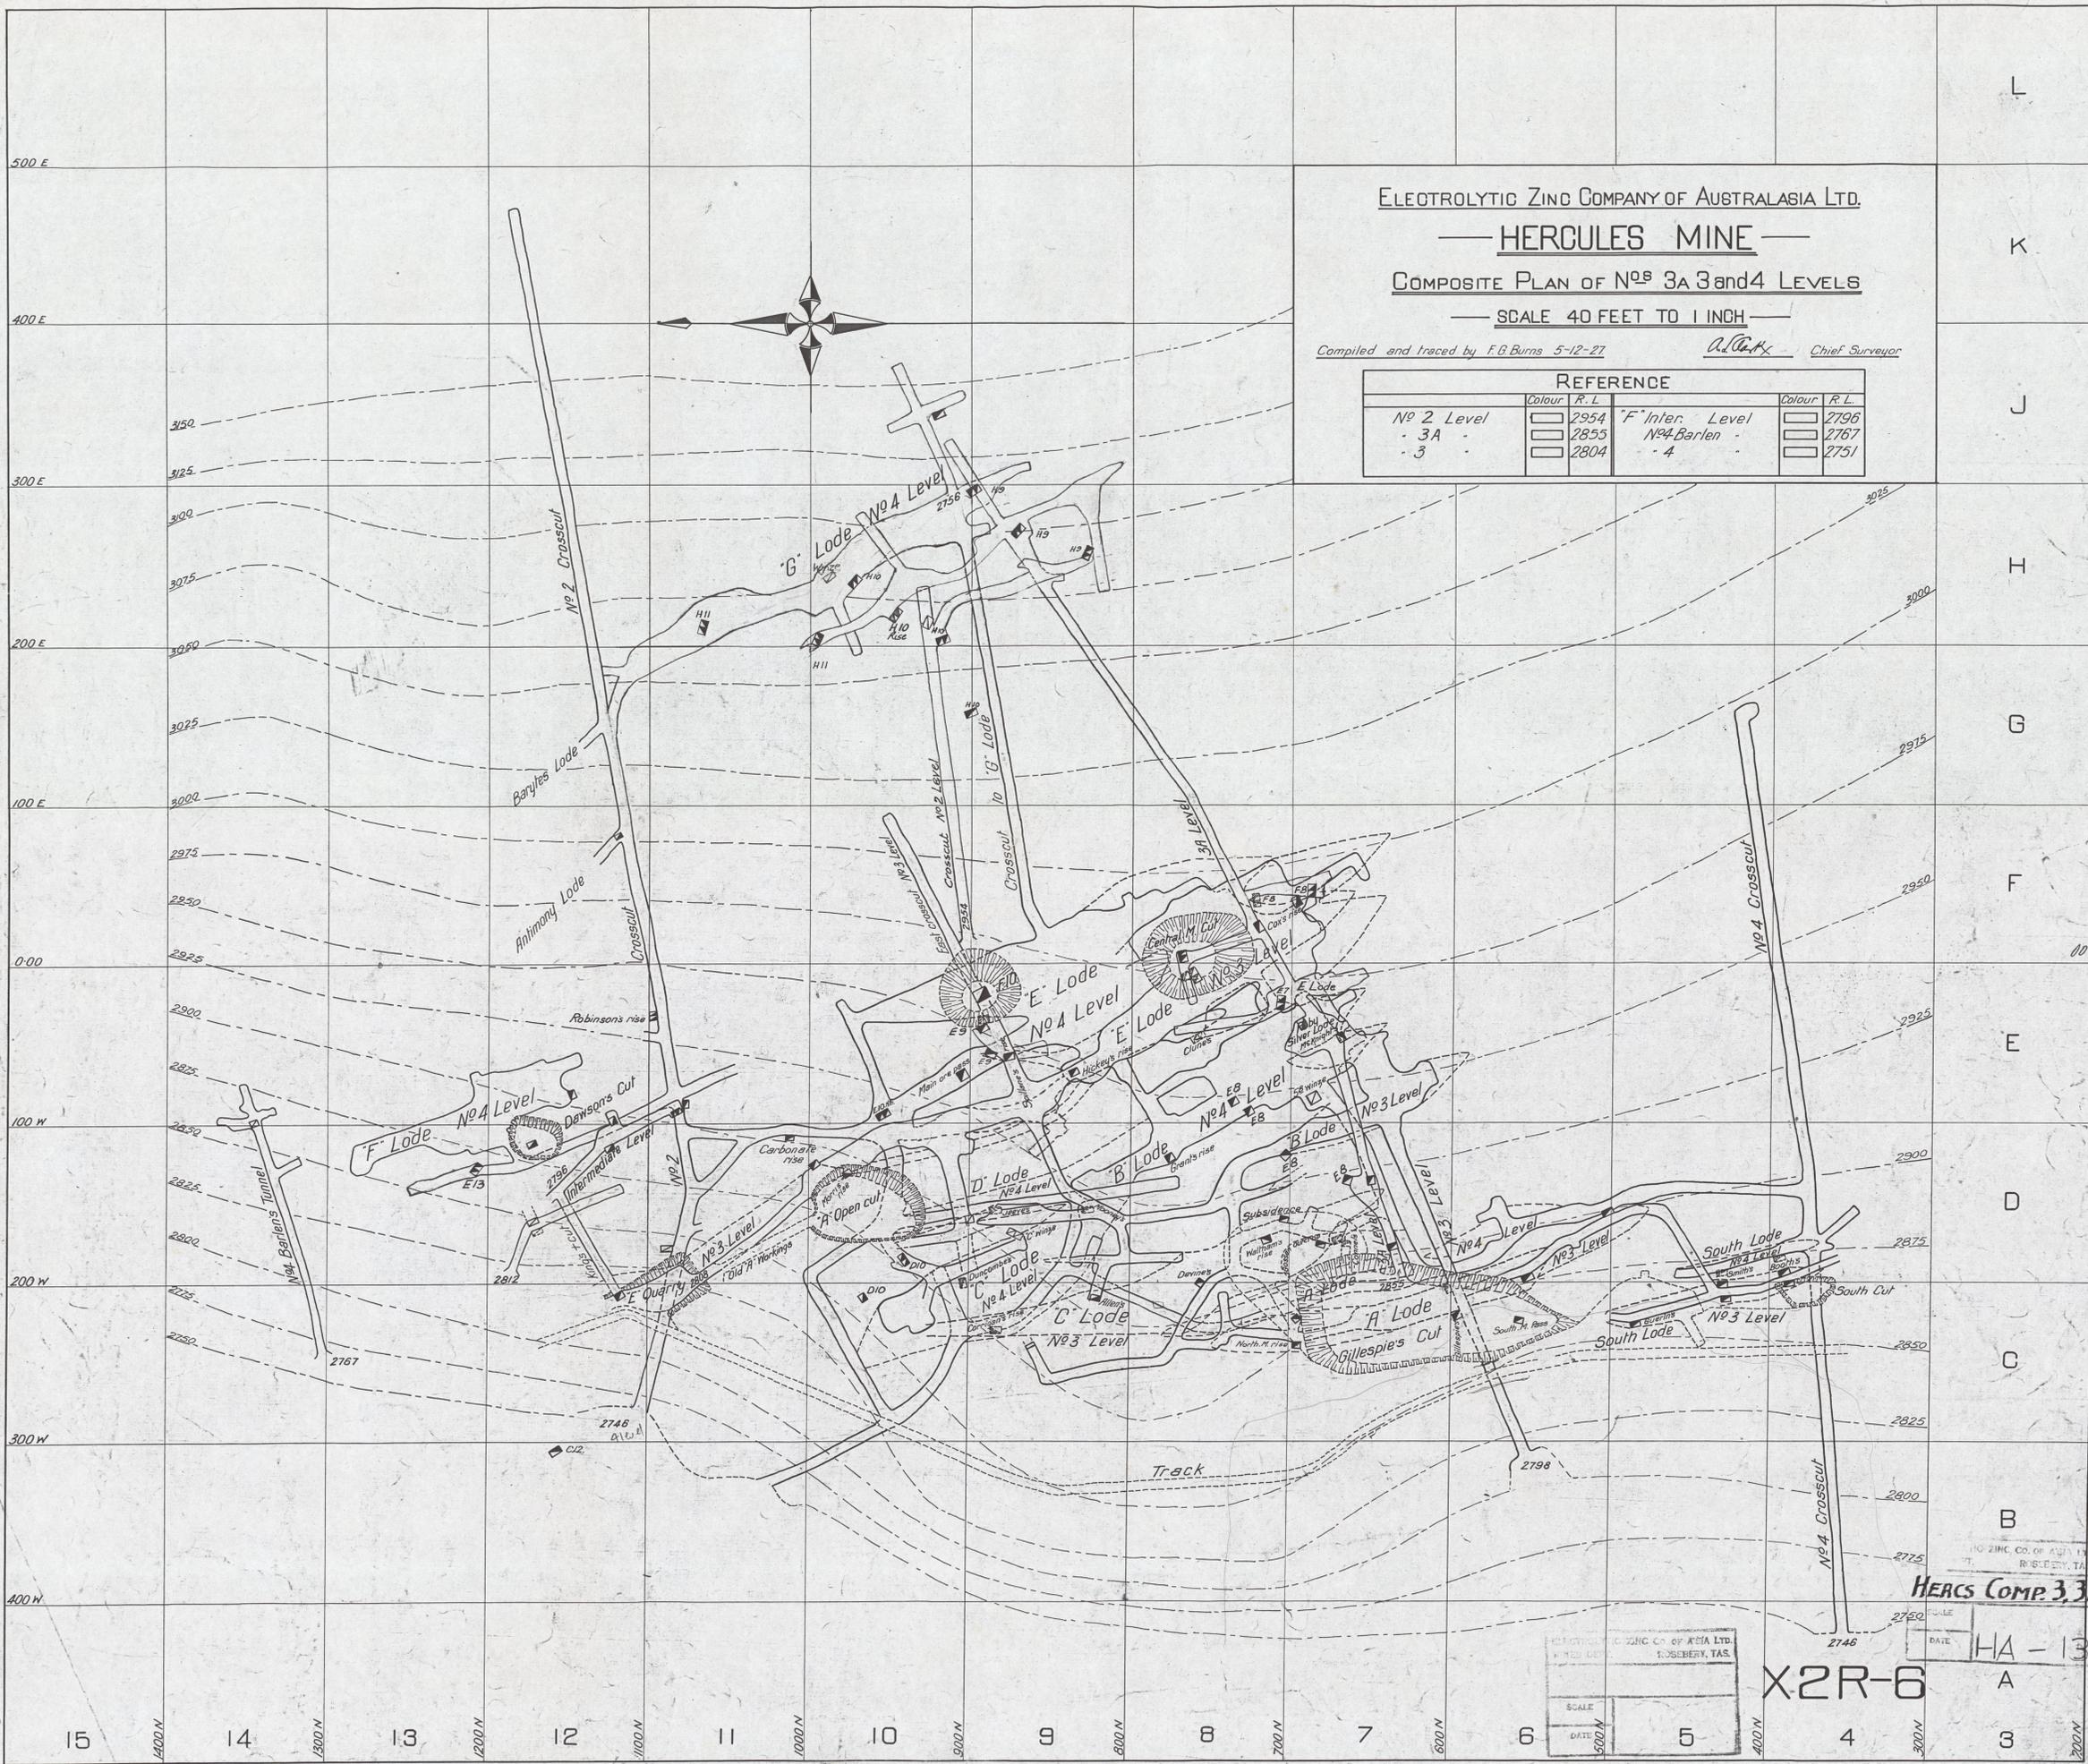

ELECTROLYTIC ZINC COMPANY OF AUSTRALASIA LTD.  
**HERCULES MINE**  
 COMPOSITE PLAN OF NOS 3A 3 and 4 LEVELS  
 SCALE 40 FEET TO 1 INCH

Compiled and traced by F.G. Burns 5-12-27 *A.G.H.* Chief Surveyor

REFERENCE					
	Colour	R.L.		Colour	R.L.
No 2 Level	[Symbol]	2954	"F" Inter. Level	[Symbol]	2796
3A	[Symbol]	2855	No 4 Barlen	[Symbol]	2767
3	[Symbol]	2804	4	[Symbol]	2751

HERCULES COMP. 3, 3A & 4

SCALE	5
DATE	5

X2R-6

HA-13

A

3

5 cm