
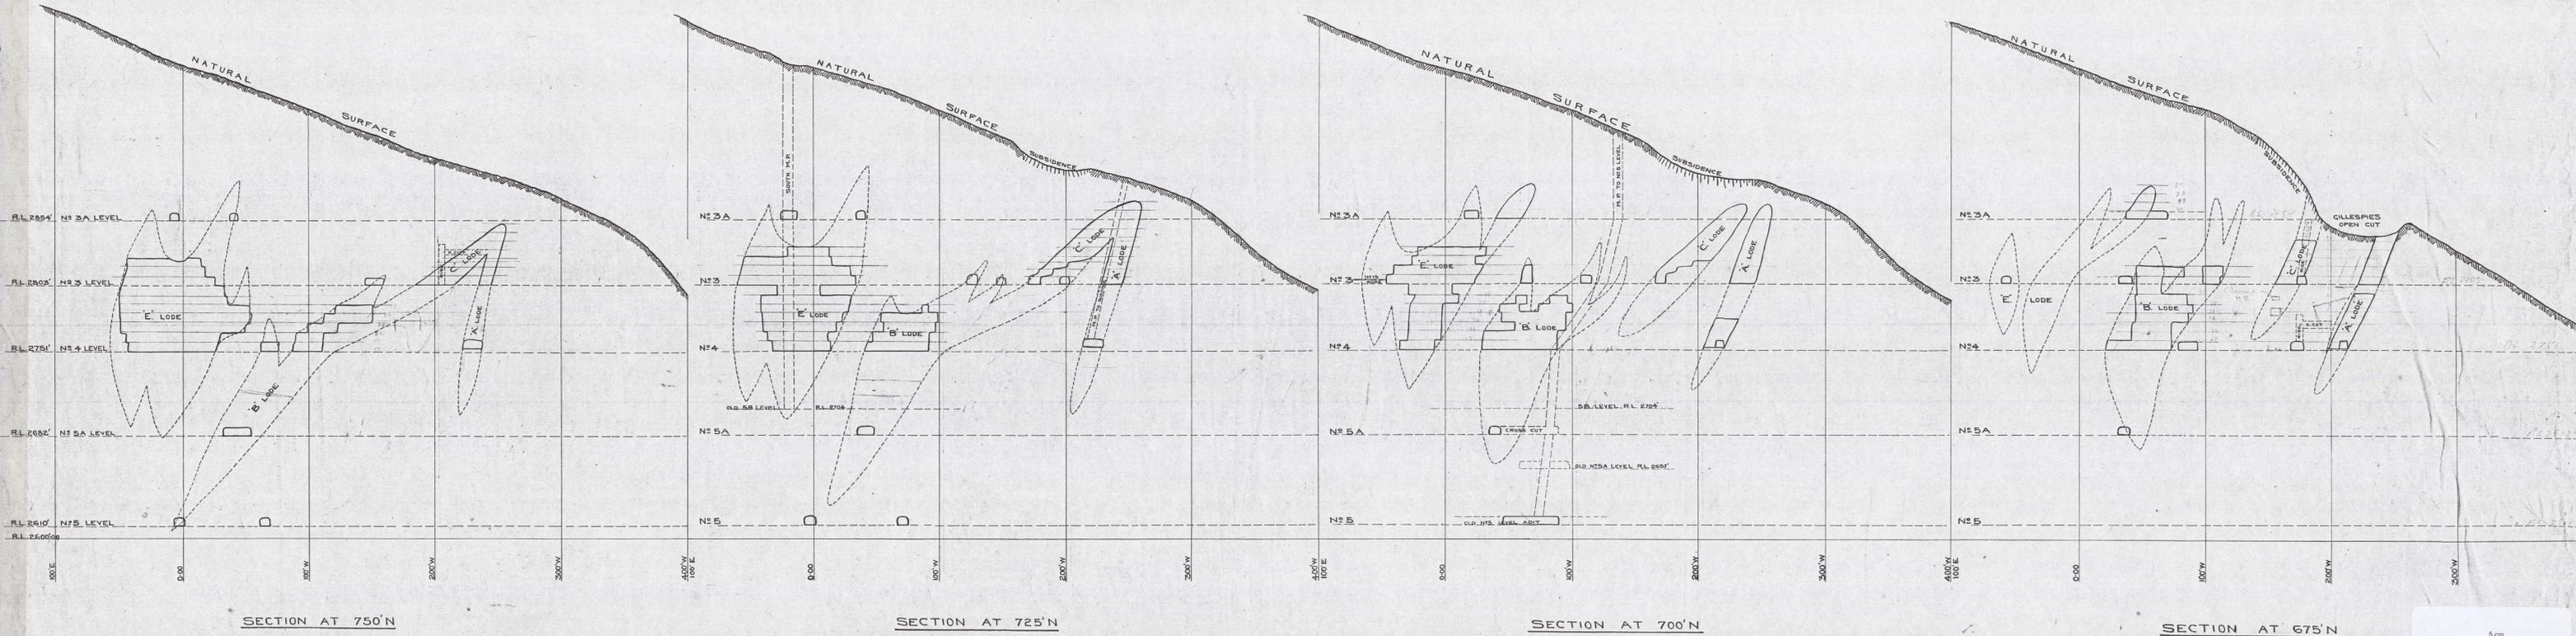


1925
X-Sections
675' N
to
850' N

0055-799

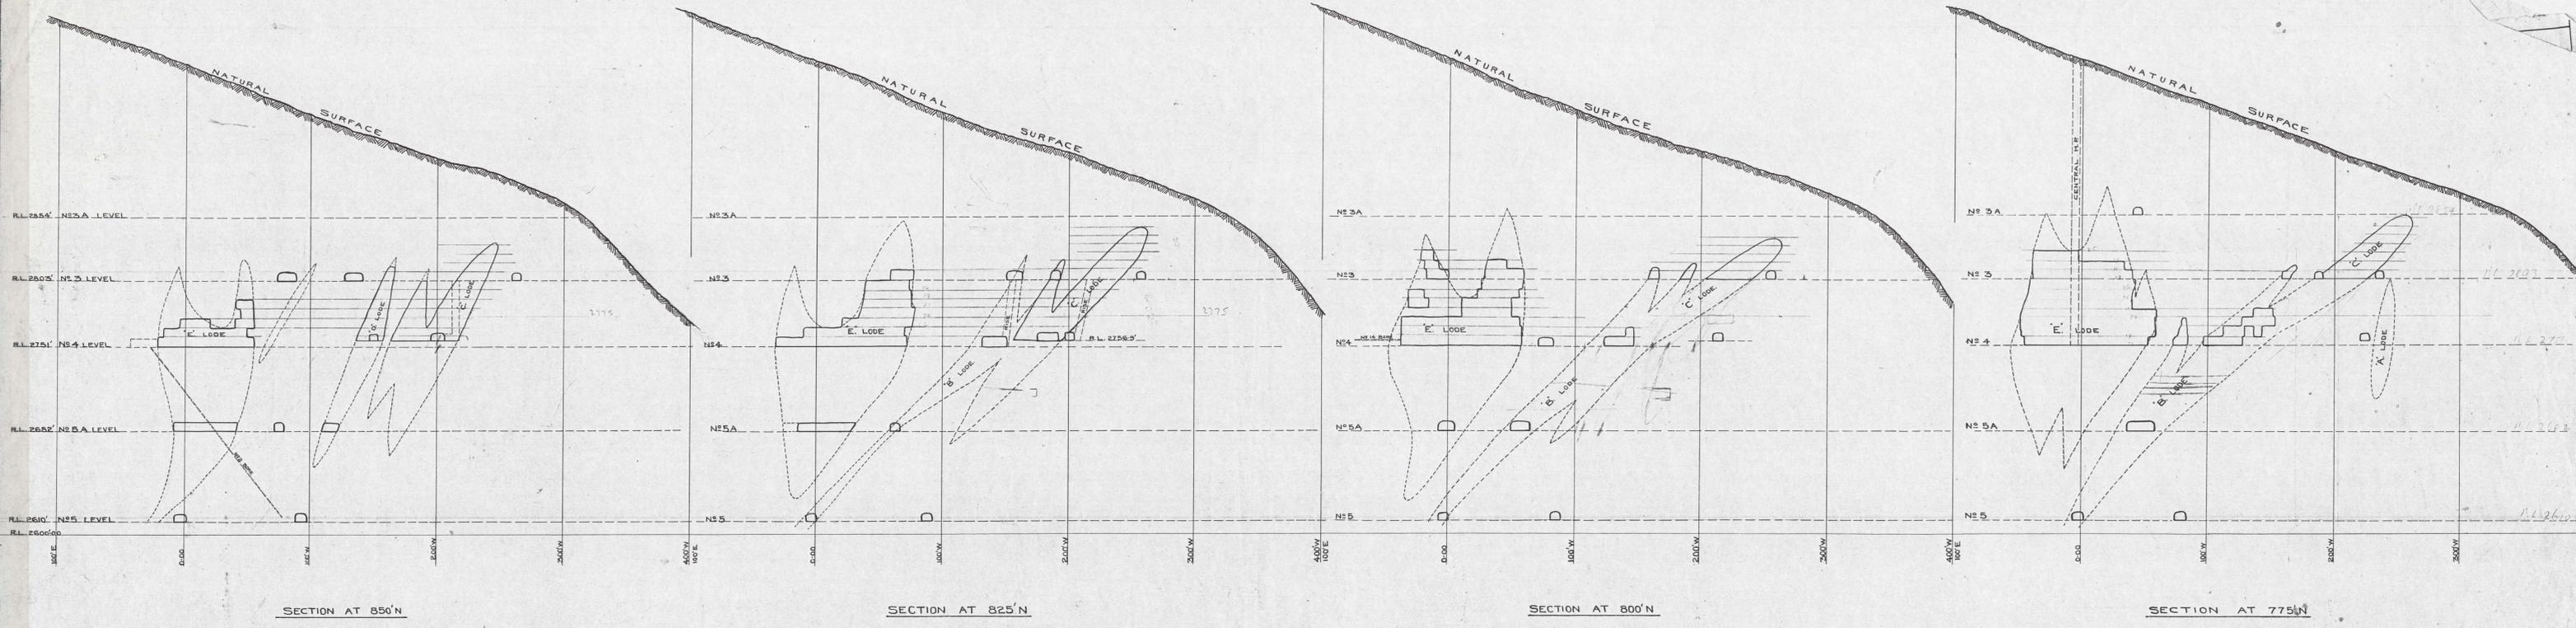

WORK DONE FROM [] TO [] SHOWN IN RED

NOTE- SECTIONS ABOVE N2.4 LEVEL TAKEN FROM M. LYELL M.F.R. CO. DRAWINGS

APPROVED BY	DATE	DATE	WEST COAST DEPARTMENT MINES HERCULES MINE SECTIONS THROUGH OREBODIES FROM 675' NORTH TO 850' NORTH	ELECTROLYTIC ZINC CO. OF AUSTRALASIA LTD HOBART TASMANIA
		25/4/25		
		3/9/25		
DRAWN BY	C. SIMPSON			
TRACED BY	C. SIMPSON			
CHECKED BY	O. K. BY.			

SCALE 1" = 50' FEET
X2-60