



0055-
802

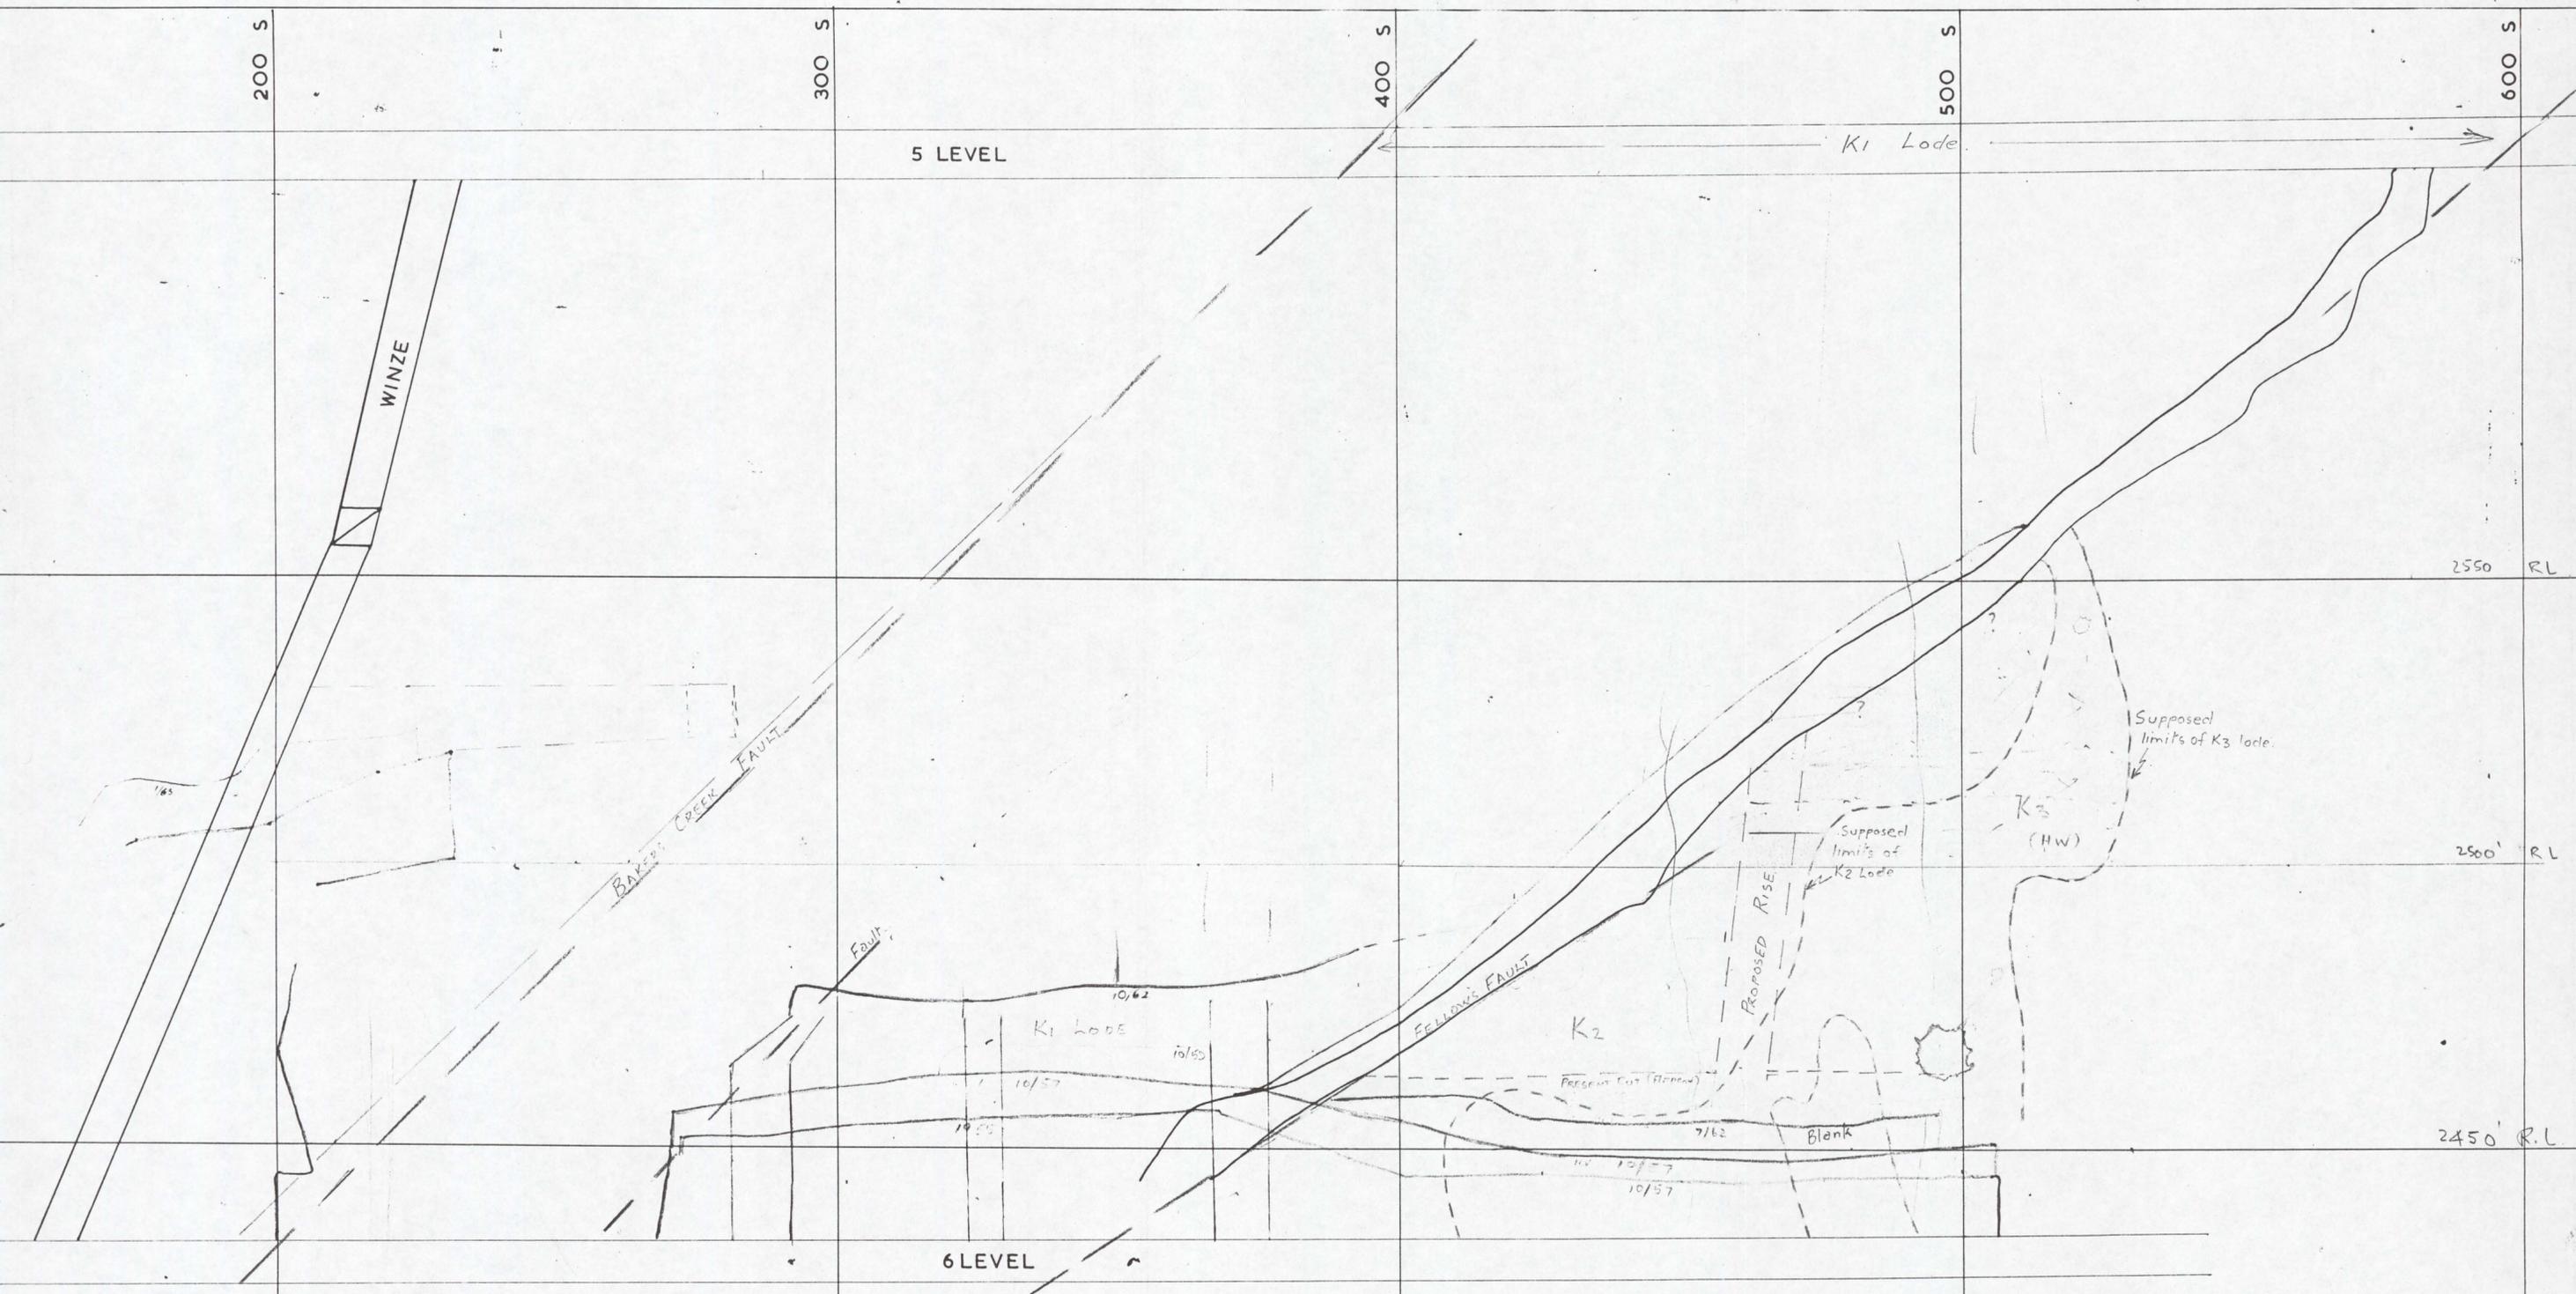

LONGITUDINAL PROJECTION

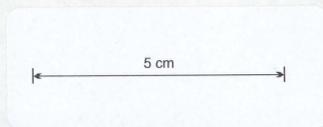

HERCULES MINE
6/G-55 FILL RISE
1-5-63
[Signature]