

0055-  
803

EIB  
1926







Electrolytic Zinc Company of Australasia Ltd.  
HERCULES MINE  
 Field Notes of Underground Workings  
 Brought up to 30th September 1926

Certified correct:-

S. Parker Surveyor  
H. G. ...


Instrument used 4in. Theodolite

For Tasmanian Govt. Mines Dept.

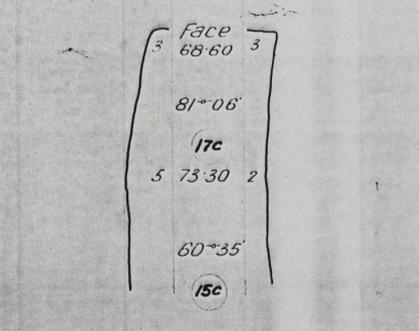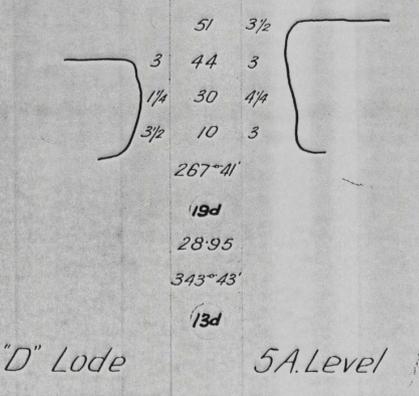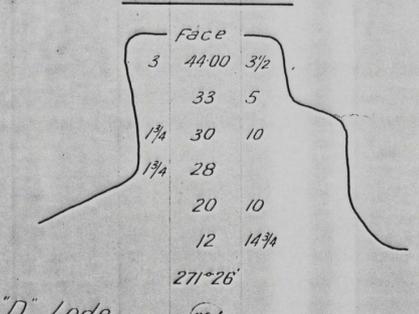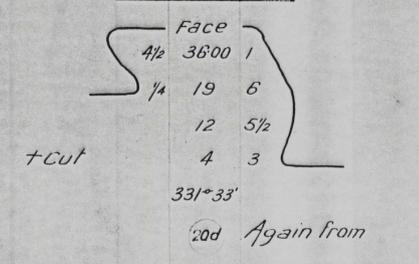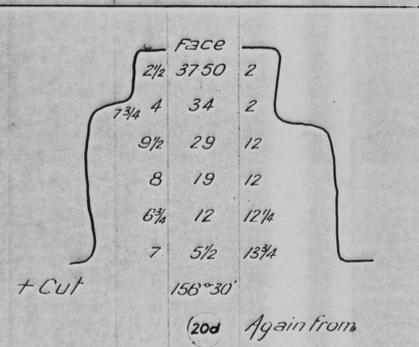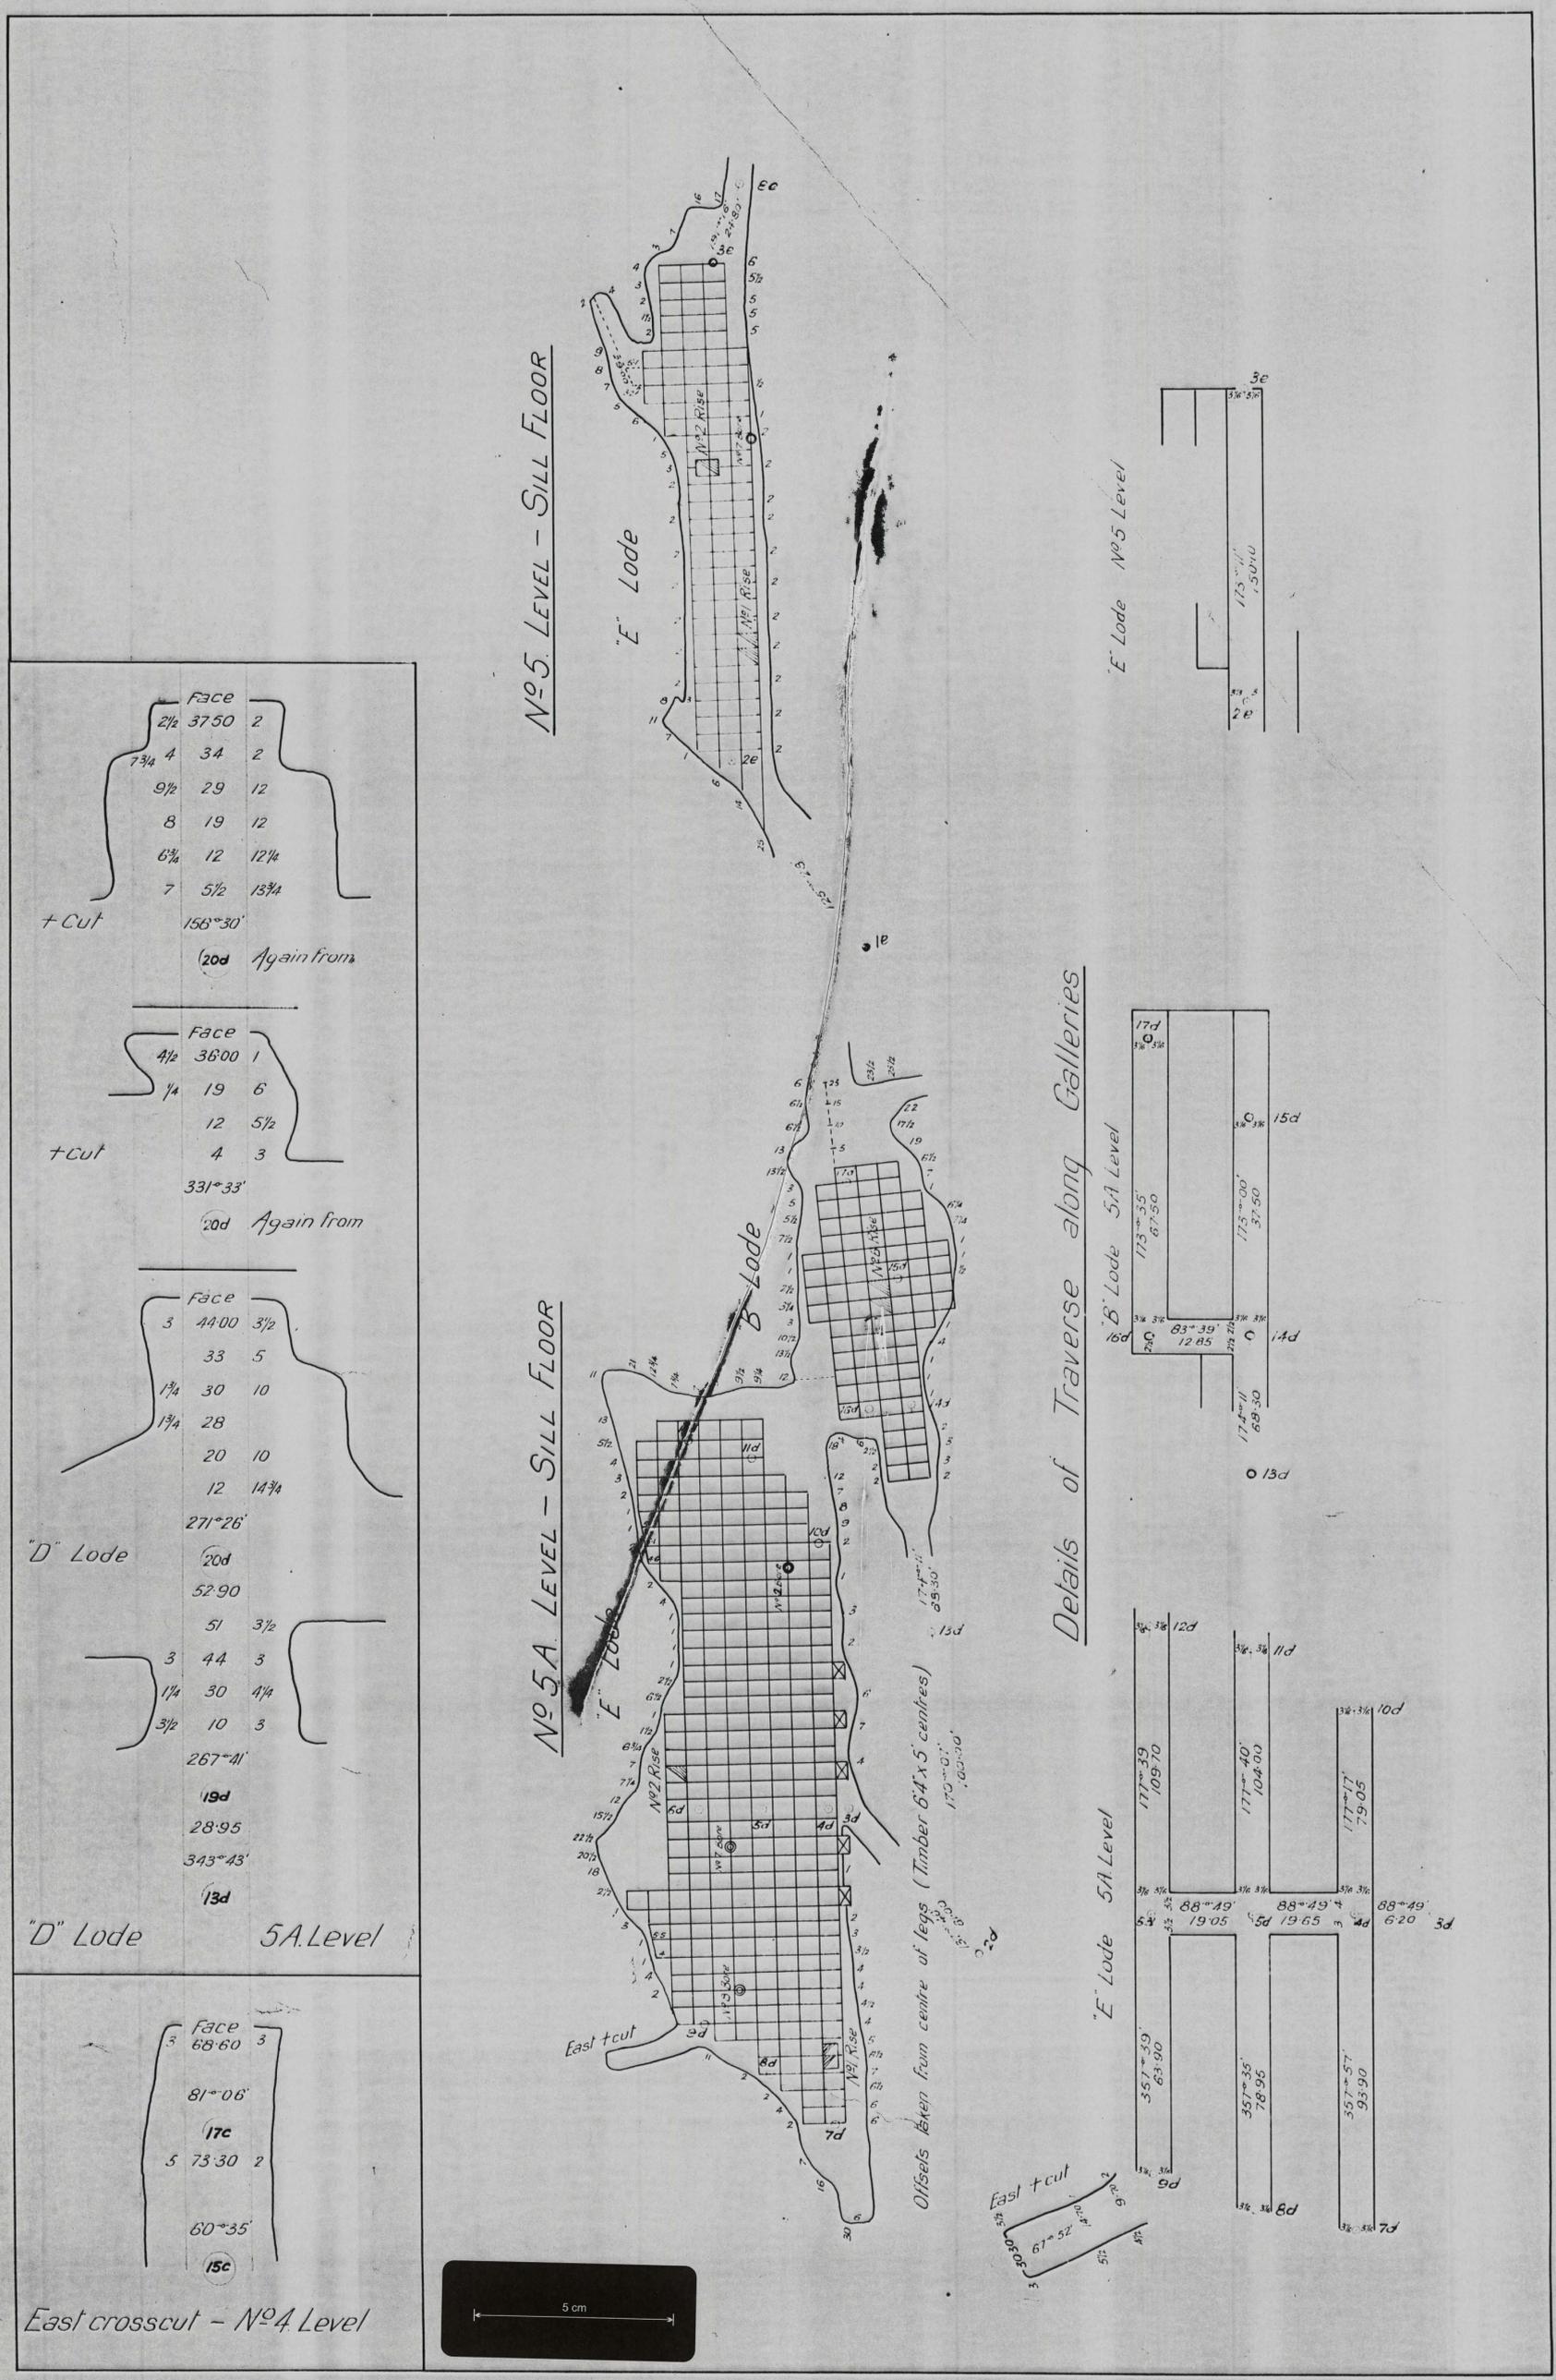

No 5 Level - Sill Floor

No 5A Level - Sill Floor

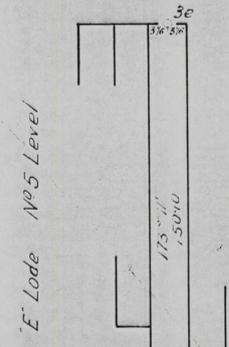

Details of Traverse along Galleries

