


0055 -  
805

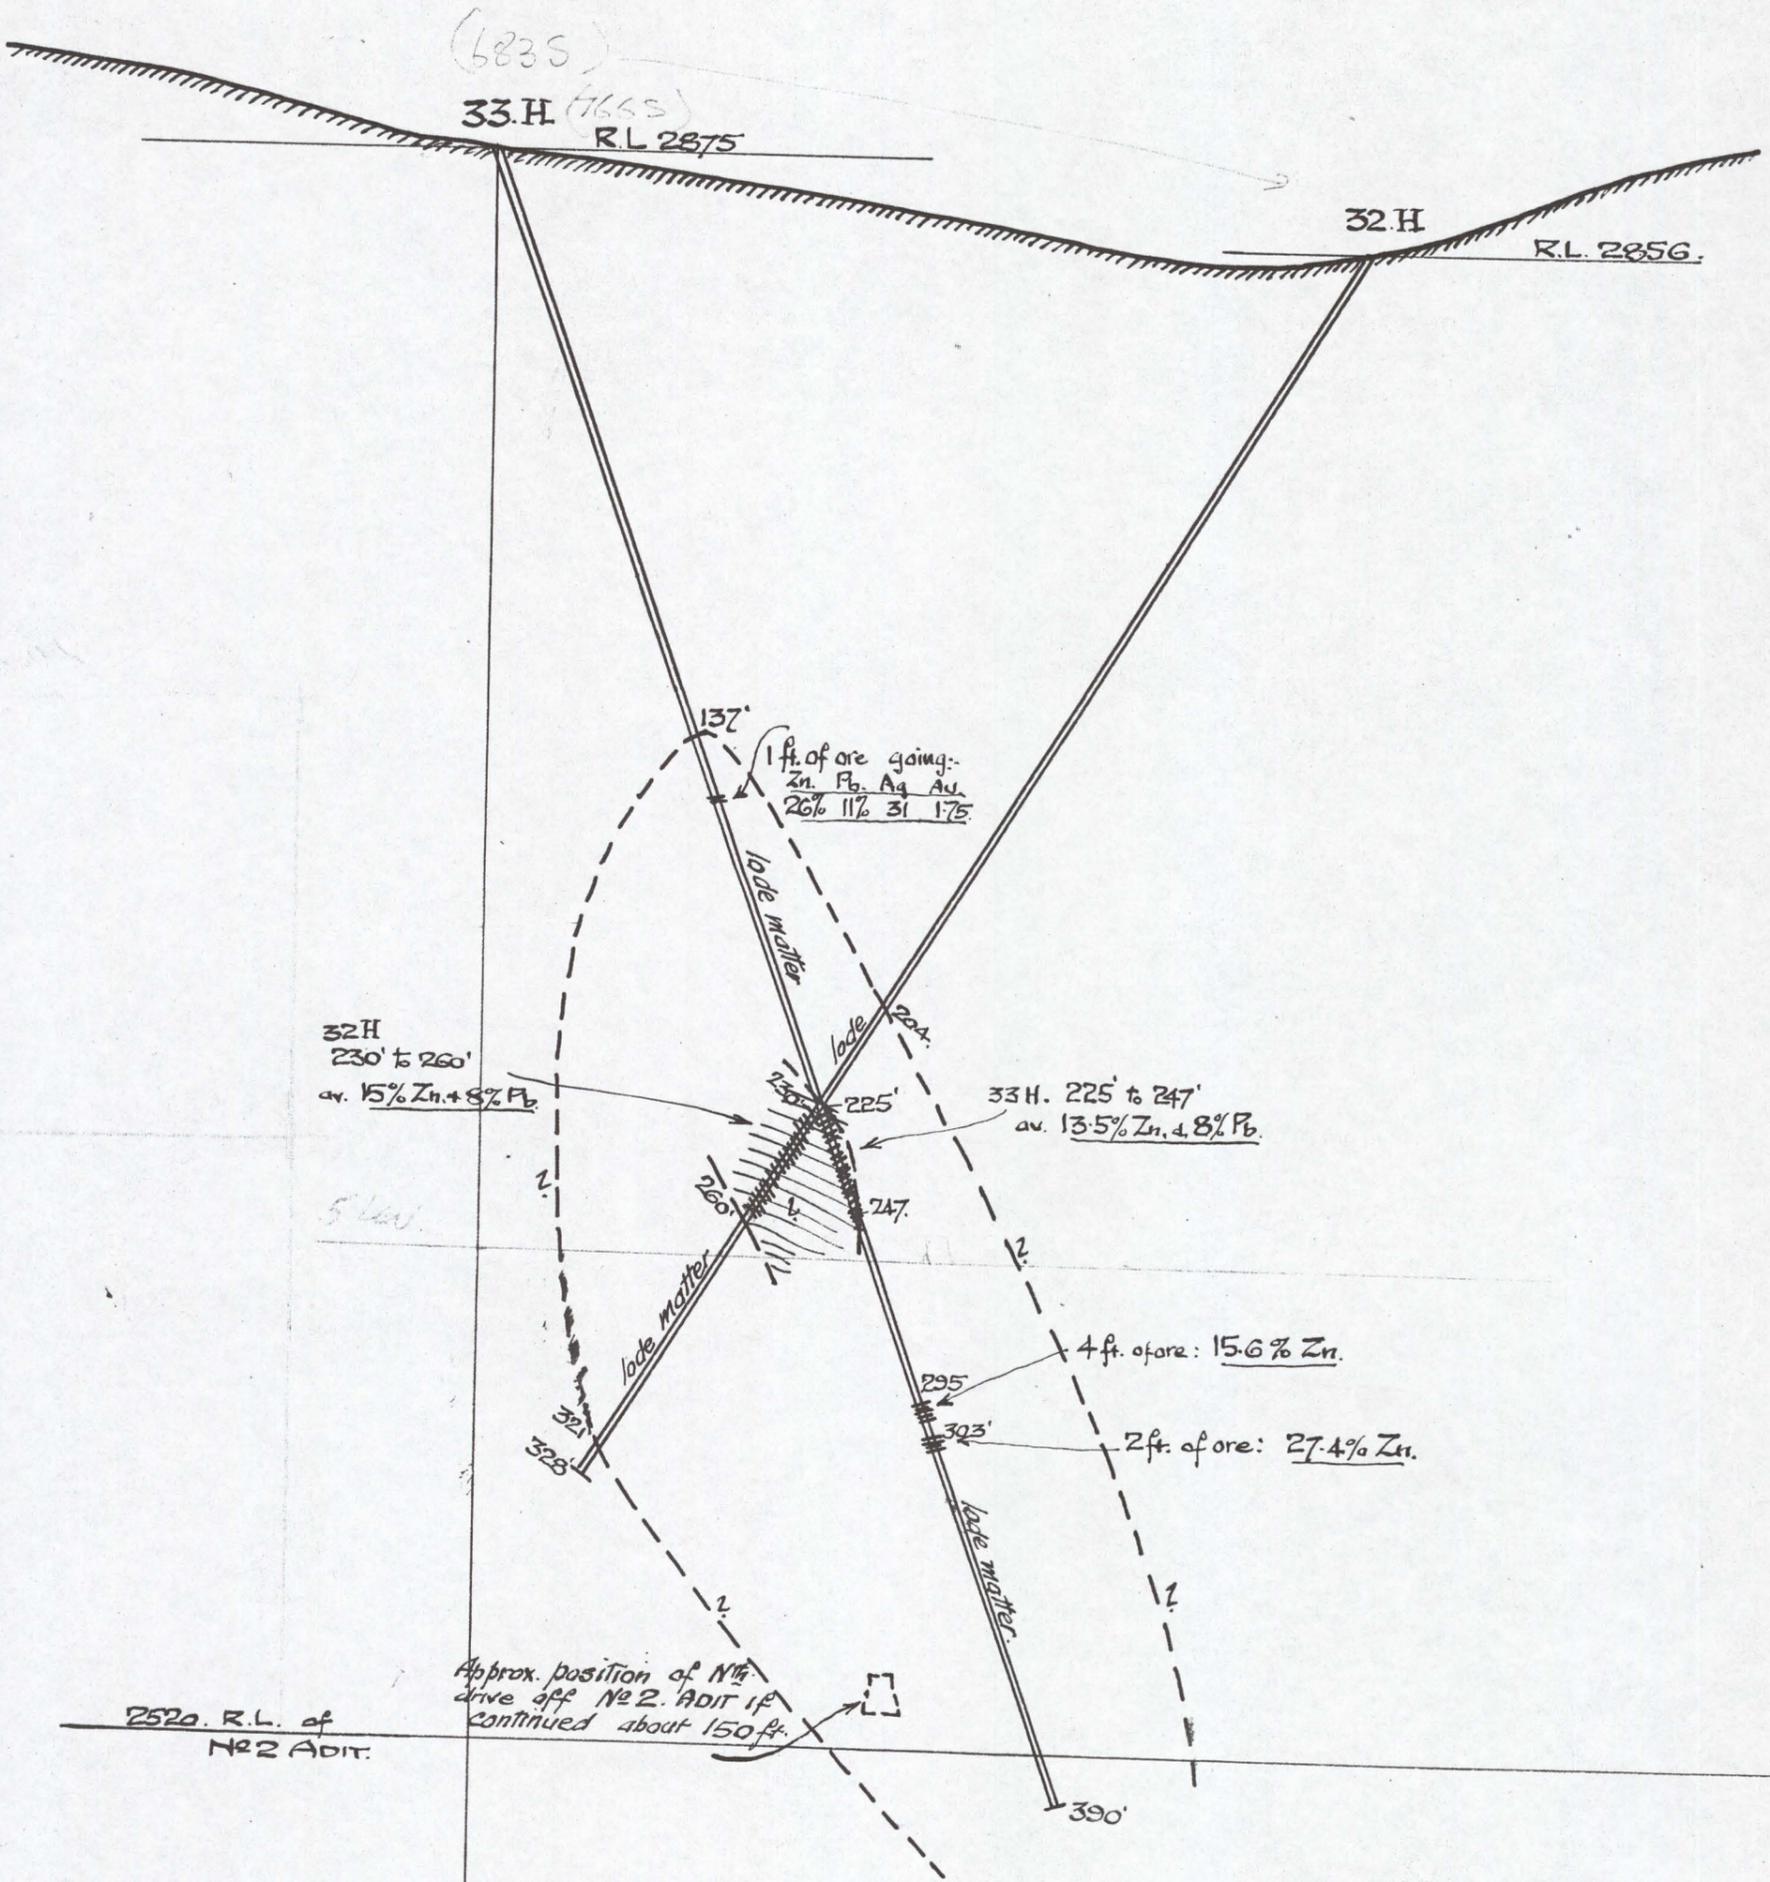

**E. Z. C.**  
**MC READ MINE.**  
**CROSS SECTION SHOWING**  
**RESULTS FROM THE BORES**  
**32.H. and 33.H.**

looking N.  
SCALE: 40' to inch  
A.J.M.  
2/7/26.

1.3  
20-0  
1.10

