
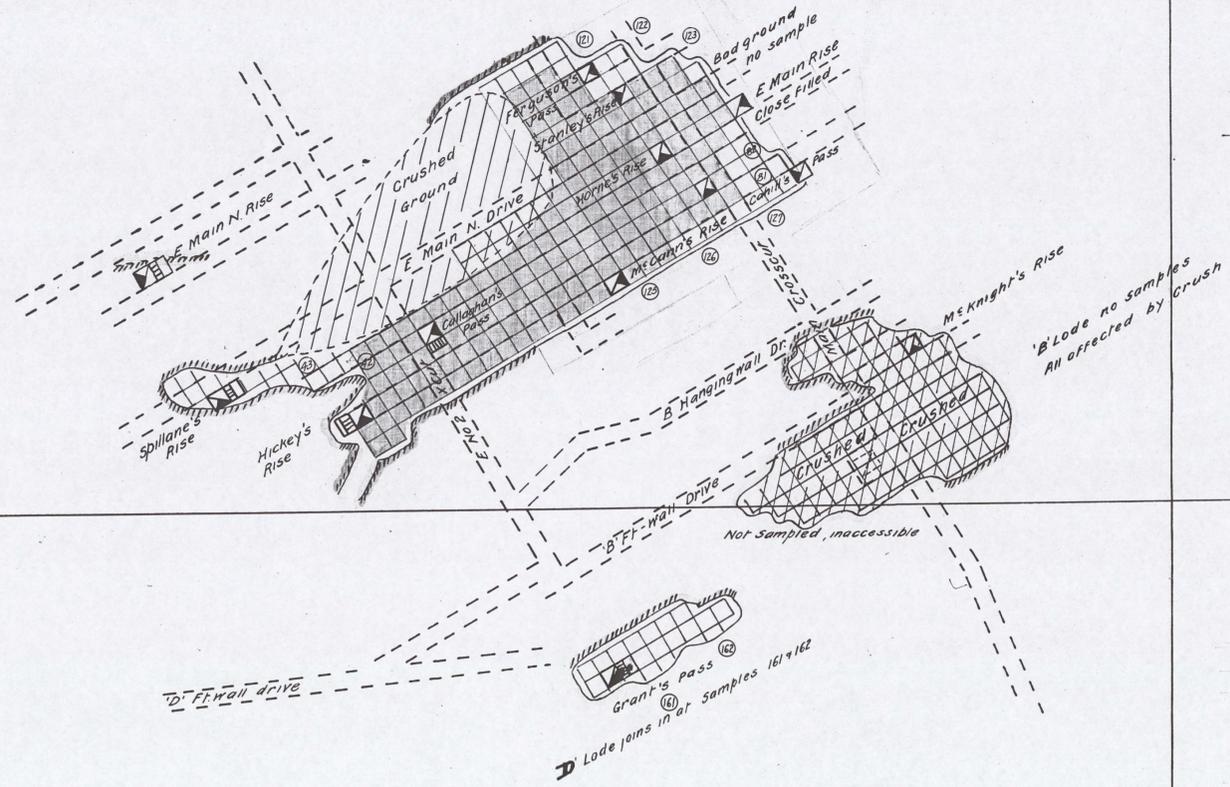


FOURTH STOPE No 4 LEVEL

14K

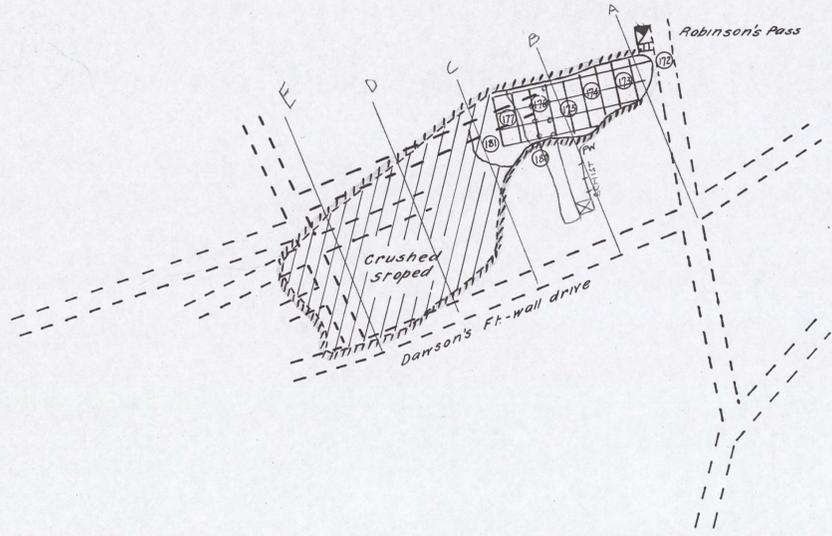

AREA STOPED SHOWN ON PLAN
 E' Lode 5692.64 Sq. Ft.
 B' Lode 2752.2 "
 Dawson's Lode 641.32 "

5 cm

TABLE SAMPLES & ASSAYS

No. of Sample	Length	Width	Locality & Description	Gold ozs.	Silver ozs.
<u>E' Lode</u>					
42	10'0"			.165	8.2
43	9'0"			.136	9.4
31	10'0"			.138	10.0
82	10'0"			.205	13.9
121	15'0"			.202	16.6
122	15'0"			.180	18.1
123	15'0"			.154	9.9
125	20'0"			.125	6.1
126	20'0"			.155	9.0
127	15'0"			.176	8.8
<u>B' Lode</u>					
161	10'0"			.112	7.8
162	15'0"			.221	13.8
<u>Dawson's Lode</u>					
172	8'0"			.162	14.0
173	8'0"			.151	31.6
174	10'0"			.185	33.6
175	10'0"			1.462	38.5
176	10'0"			.382	171.0
177	10'0"			.238	35.0
180	5'0"			.726	28.0
181	7'6"			.149	16.0

4 Level
 E & B Stopes
 0055-84-8