


0505-850

M¹ Read Mine

Assay Plan

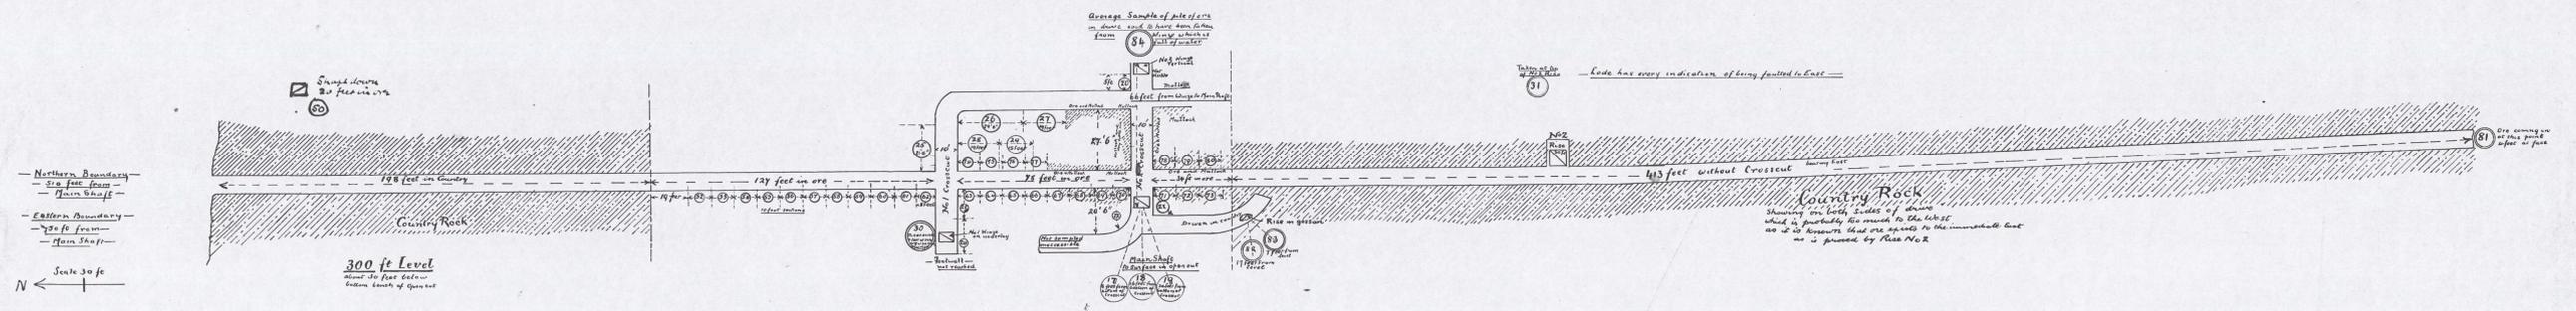

— ASSAY PLAN —
— M¹-READ MINE —

4 April 1910



*Completed as of
6-10-10
PP*

E 11e