


Mt. Read Mine

Plan 0055-852

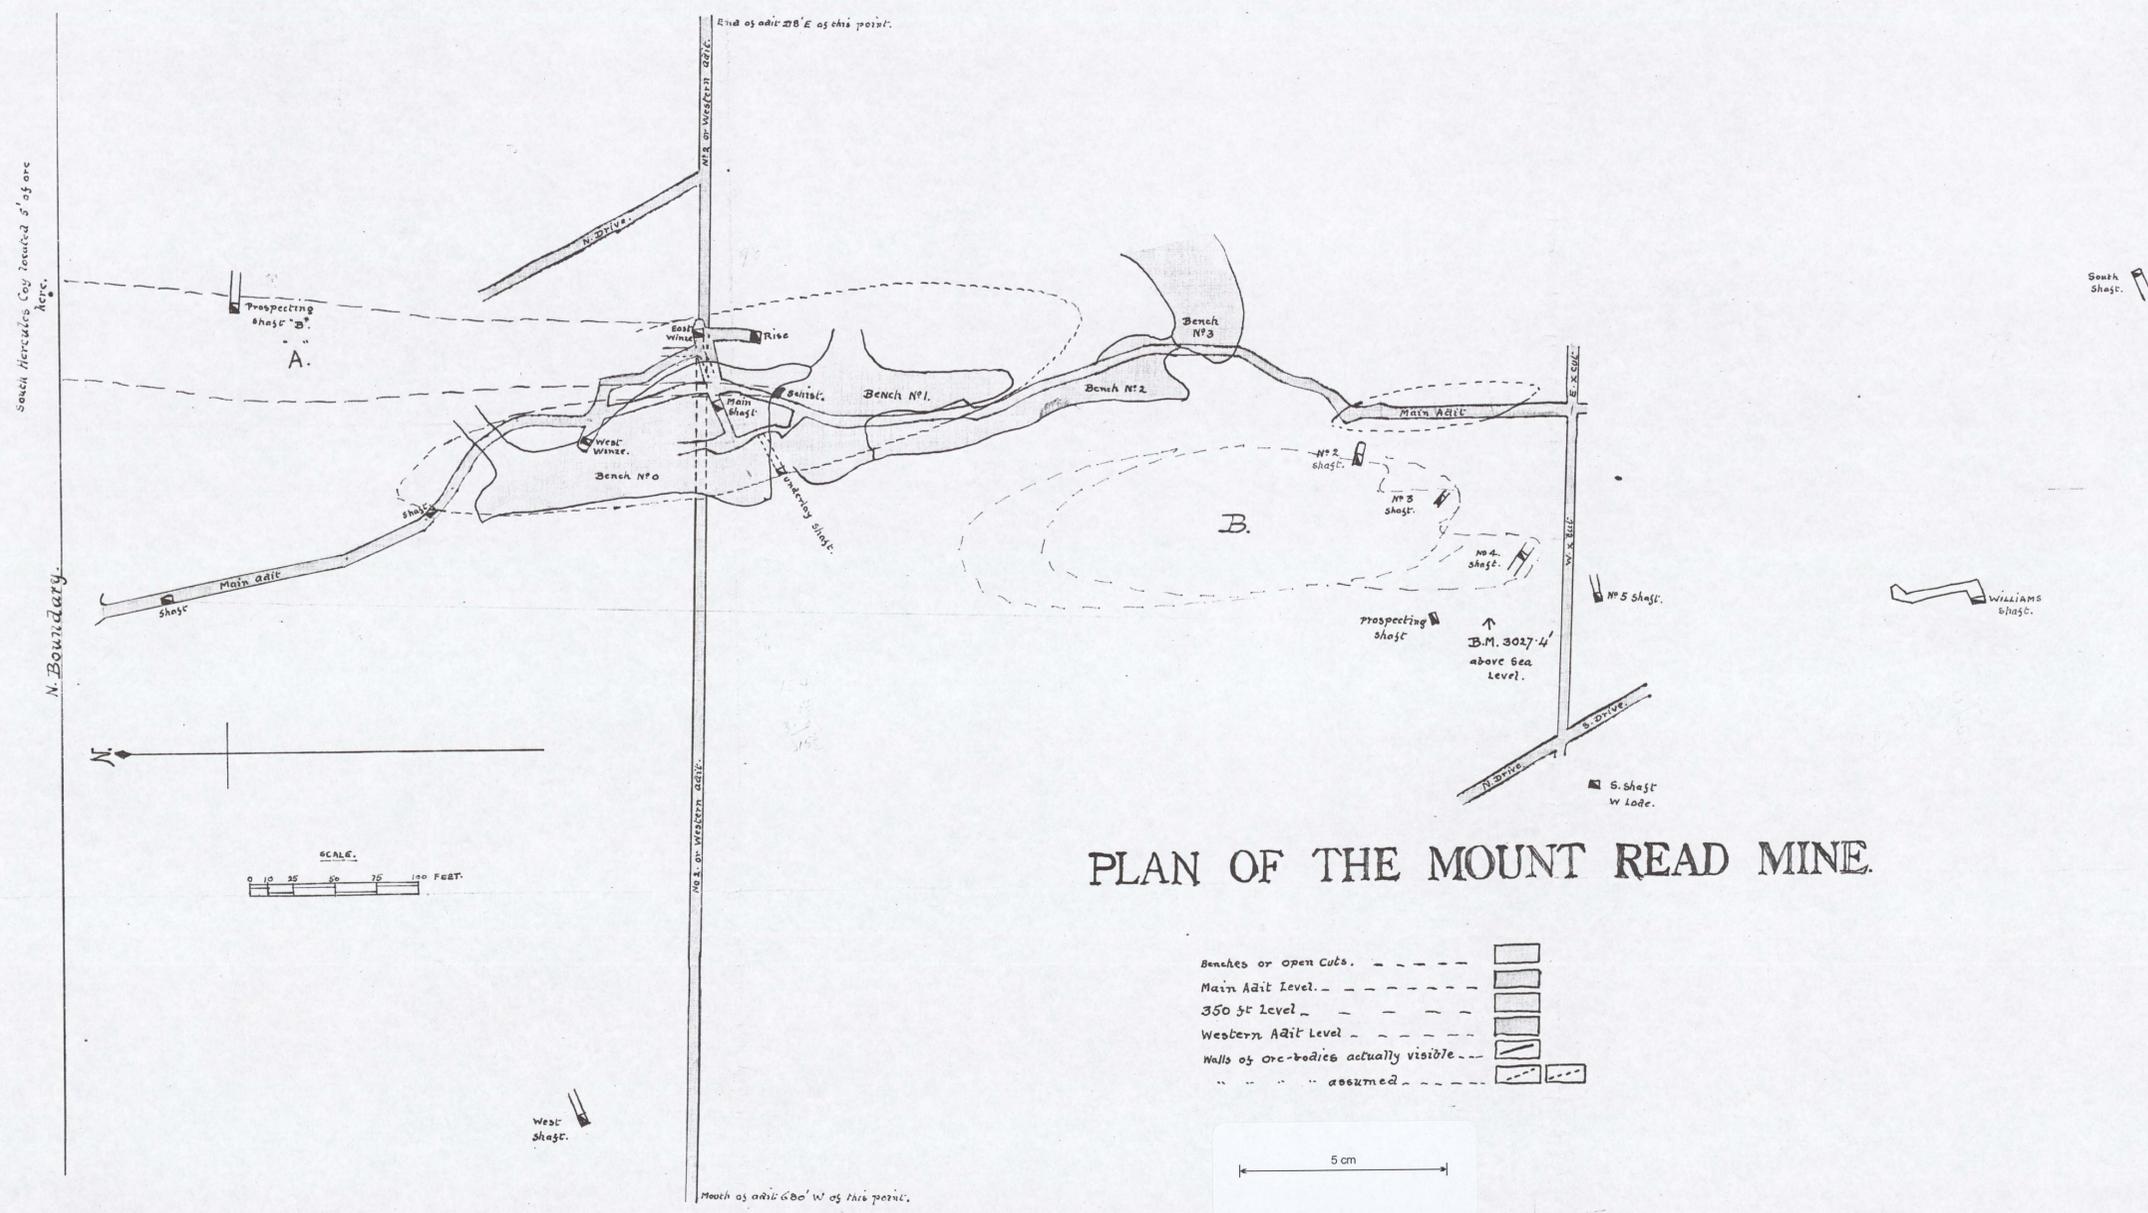

PLAN OF THE MOUNT READ MINE.

- Benchets or Open Cuts.
- Main Adit Level.
- 350 ft Level.
- Western Adit Level.
- Walls of ore-bodies actually visible.
- " " " " assumed.

5 cm

Search Hercules Coy records 5' of ore here.

Prospecting shaft "A".

East Winze.

West Winze.

Bench No. 0.

Main Adit.

Main Shaft.

Bench No. 1.

Bench No. 2.

Bench No. 3.

No. 2 shaft.

No. 3 shaft.

No. 4 shaft.

No. 5 shaft.

Williams shaft.

B.M. 3027-4 above sea level.

6. shaft w. lode.

South shaft.

End of adit 28' E of this point.

N. Boundary.

E. Boundary.

Scale: 0 10 20 30 40 50 60 70 80 90 100 FEET.

West shaft.

Mouth of adit 60' W of this point.