


# N°3-A LEVEL

14a



Reference ————— Crushed ground  
 ~~~~~ Schistose Rock  
 ——— Ore showing in face  
 - - - Probable boundary of Ore  
 □ Height in feet above datum

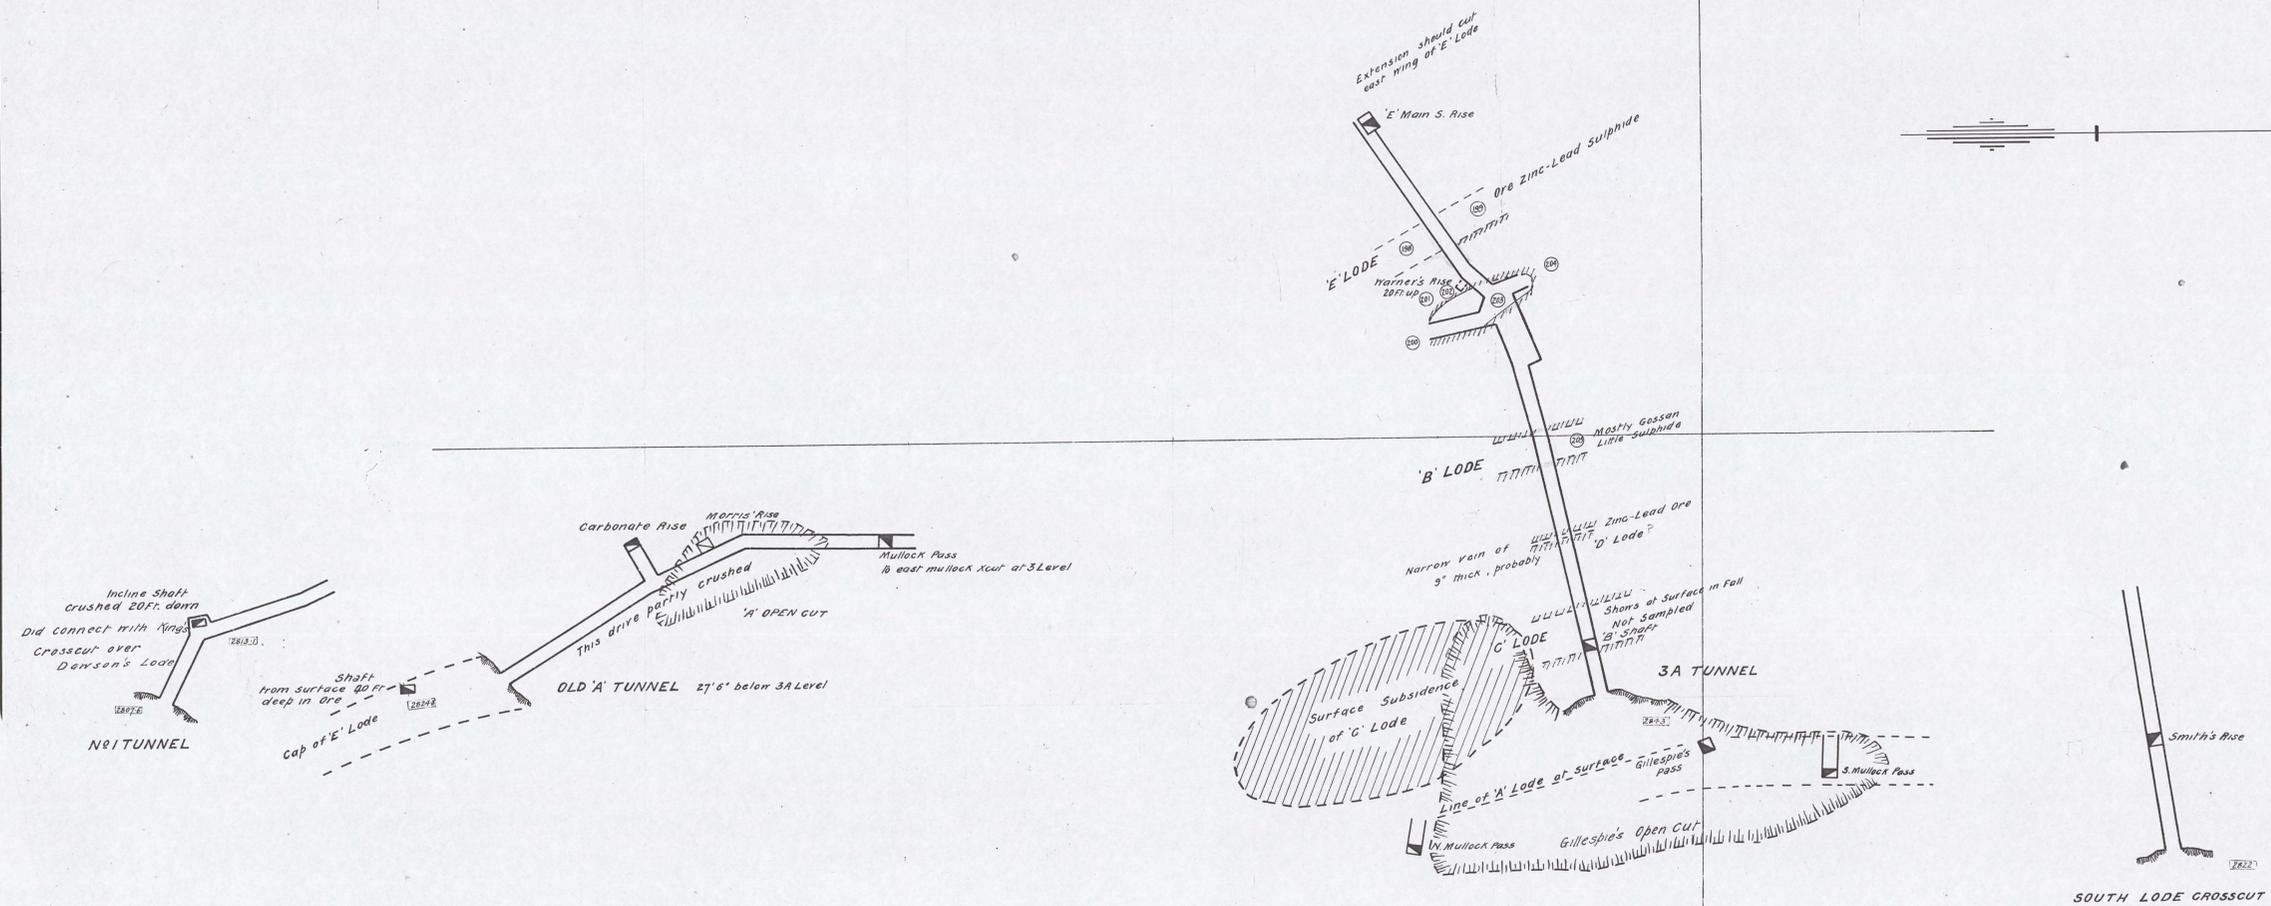

ELECTROLYTIC ZINC COMPANY  
 OF AUSTRALASIA LTD.  
 HERCULES MINE ROSEBERRY

**3A LEVEL.**  
 Scale: Date: 1/1/1911

|            |           |
|------------|-----------|
| Survey by  | PLAN No.  |
| Geology by | SHEET No. |

3A Level 0655-856