

ELECTROLYTIC ZINC COMPANY OF AUSTRALASIA LTD.

HERCULES MINE



No 3a Level and No 2 Level

SCALE 40 FEET TO 1 INCH

Work done from [] to [] shown red

Drawing and tracing by F.G. Burns 29-12-27


A.S. Clark Chief Surveyor

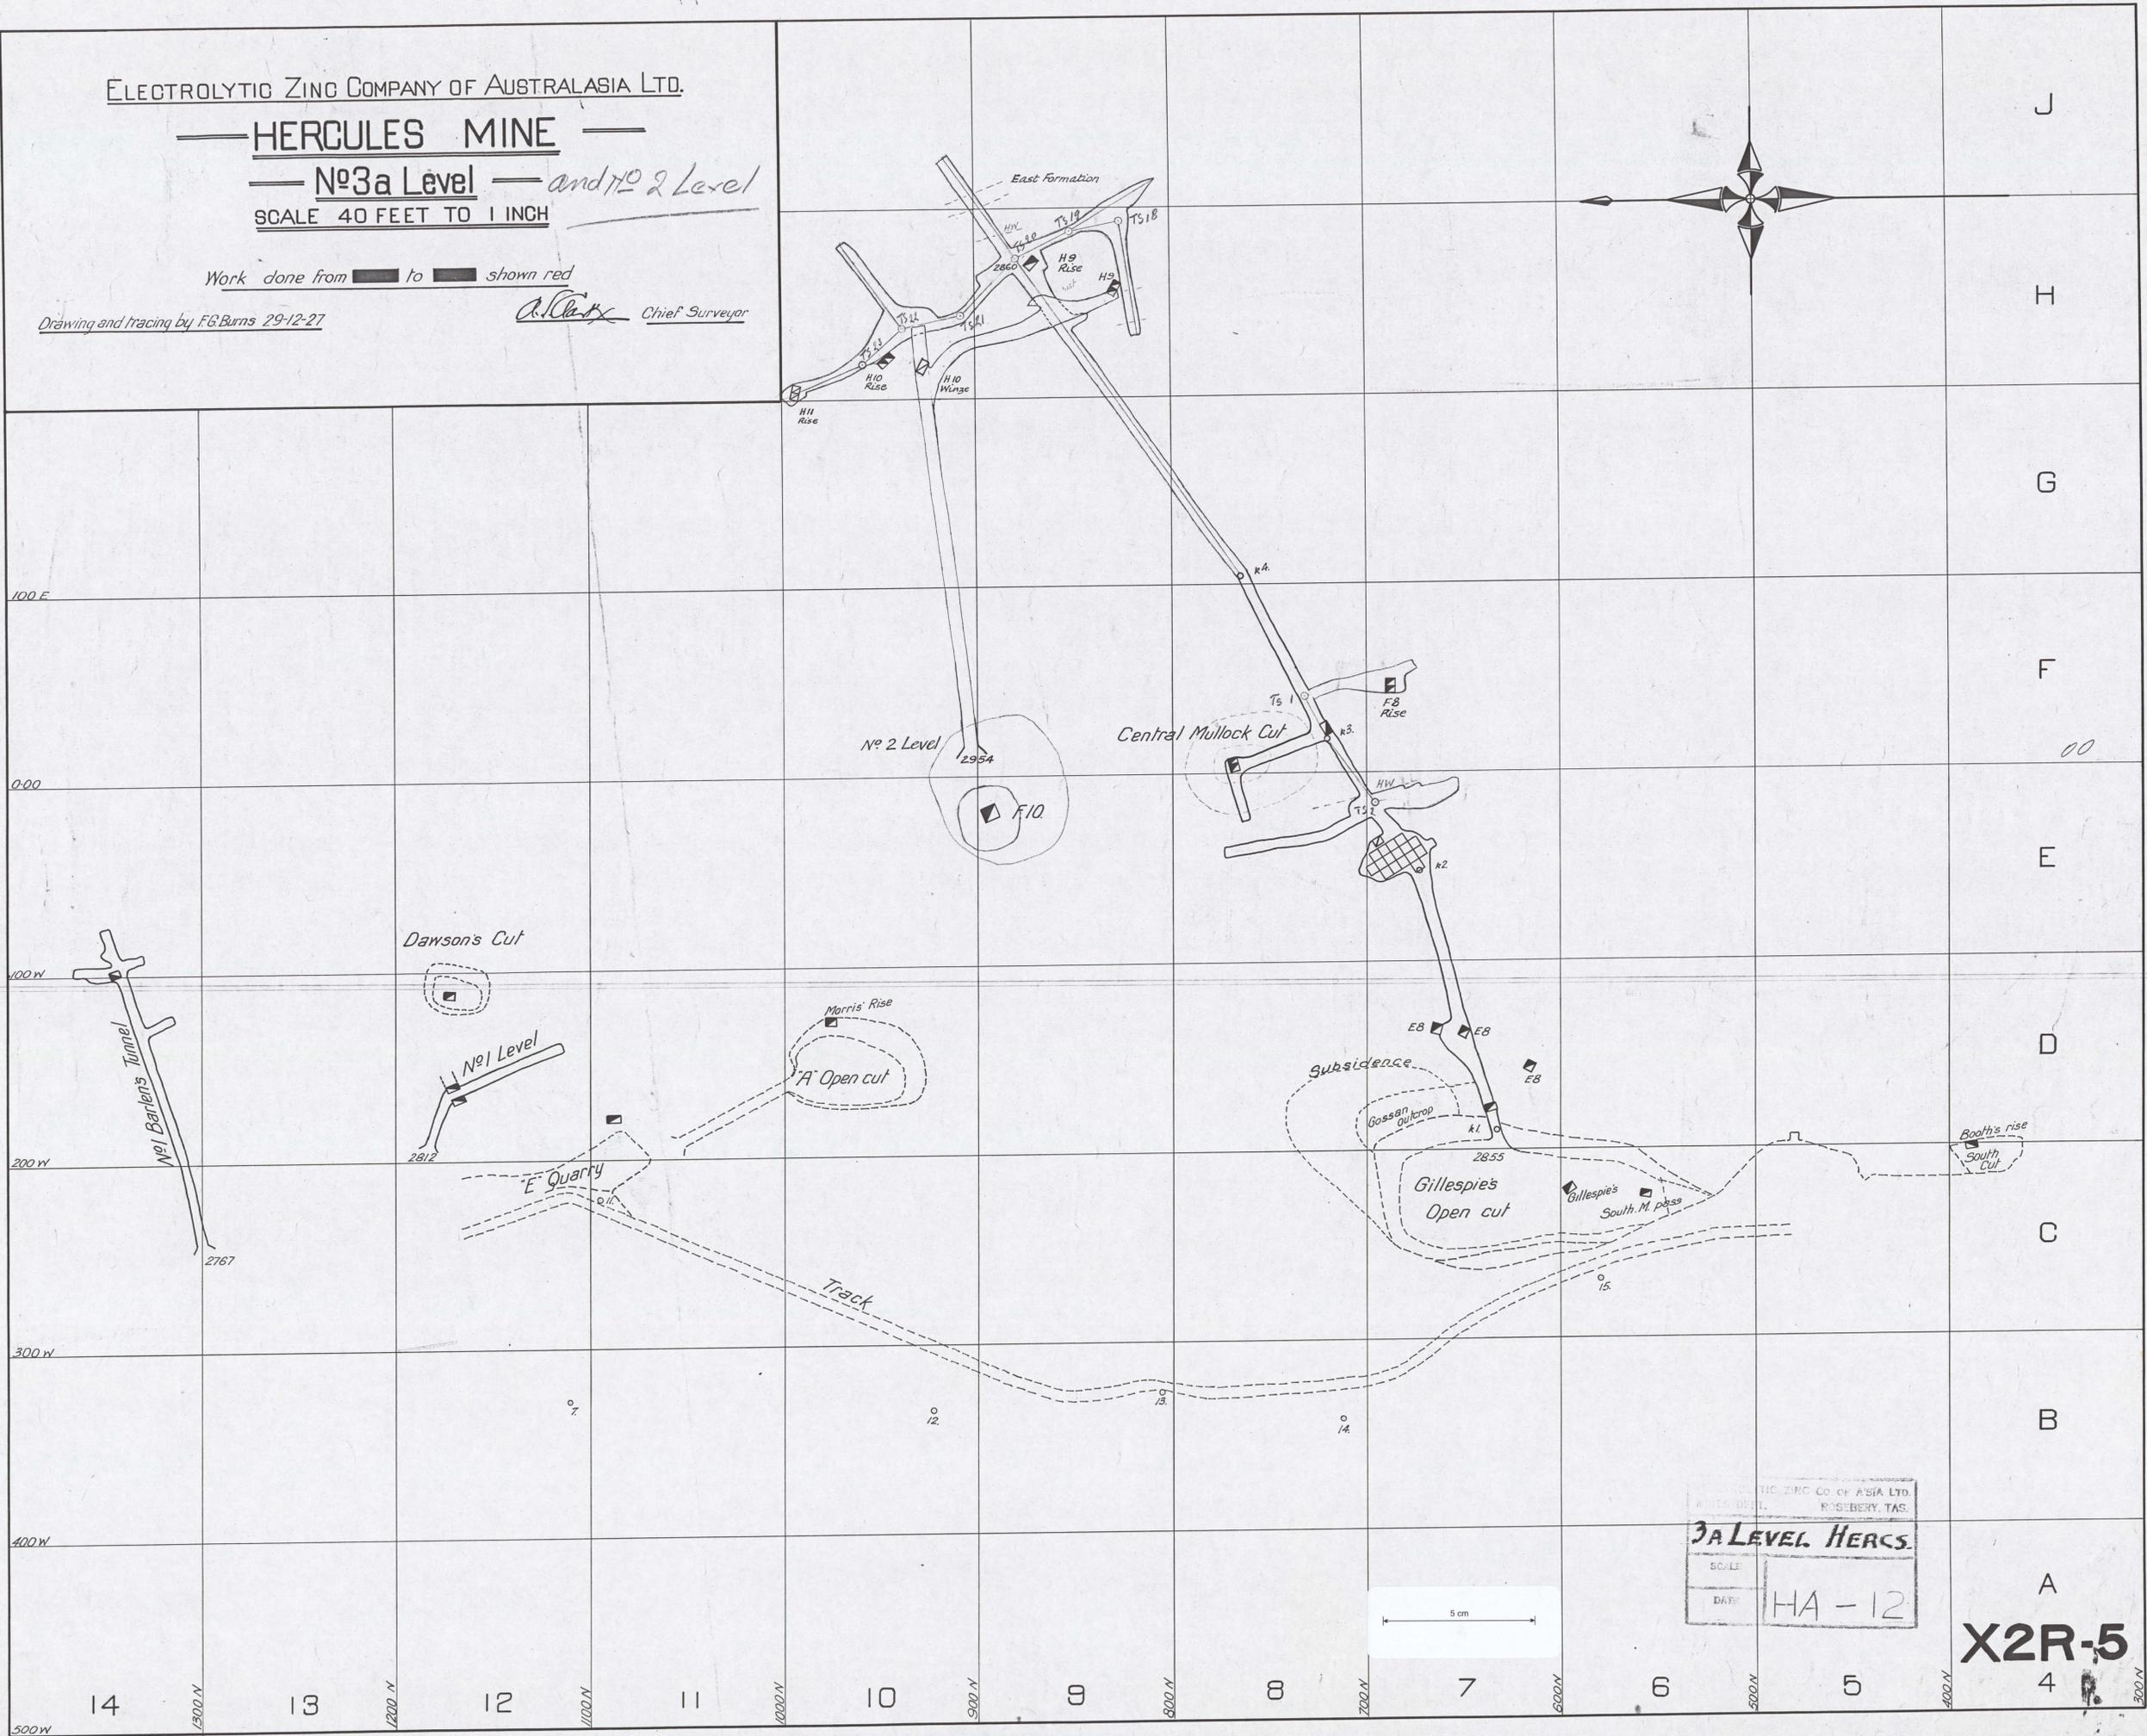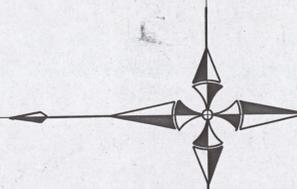

3A Level Development

0055 - 857

ELECTROLYTIC ZINC CO OF ASIA LTD.
ROSEBERY, TAS.
3A LEVEL HERCS
SCALE
DATE HA-12

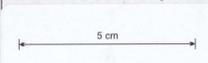

A
X2R-5
4