


E.C. + D. Lodes
3-5 Level

X Sections
0055 - 858

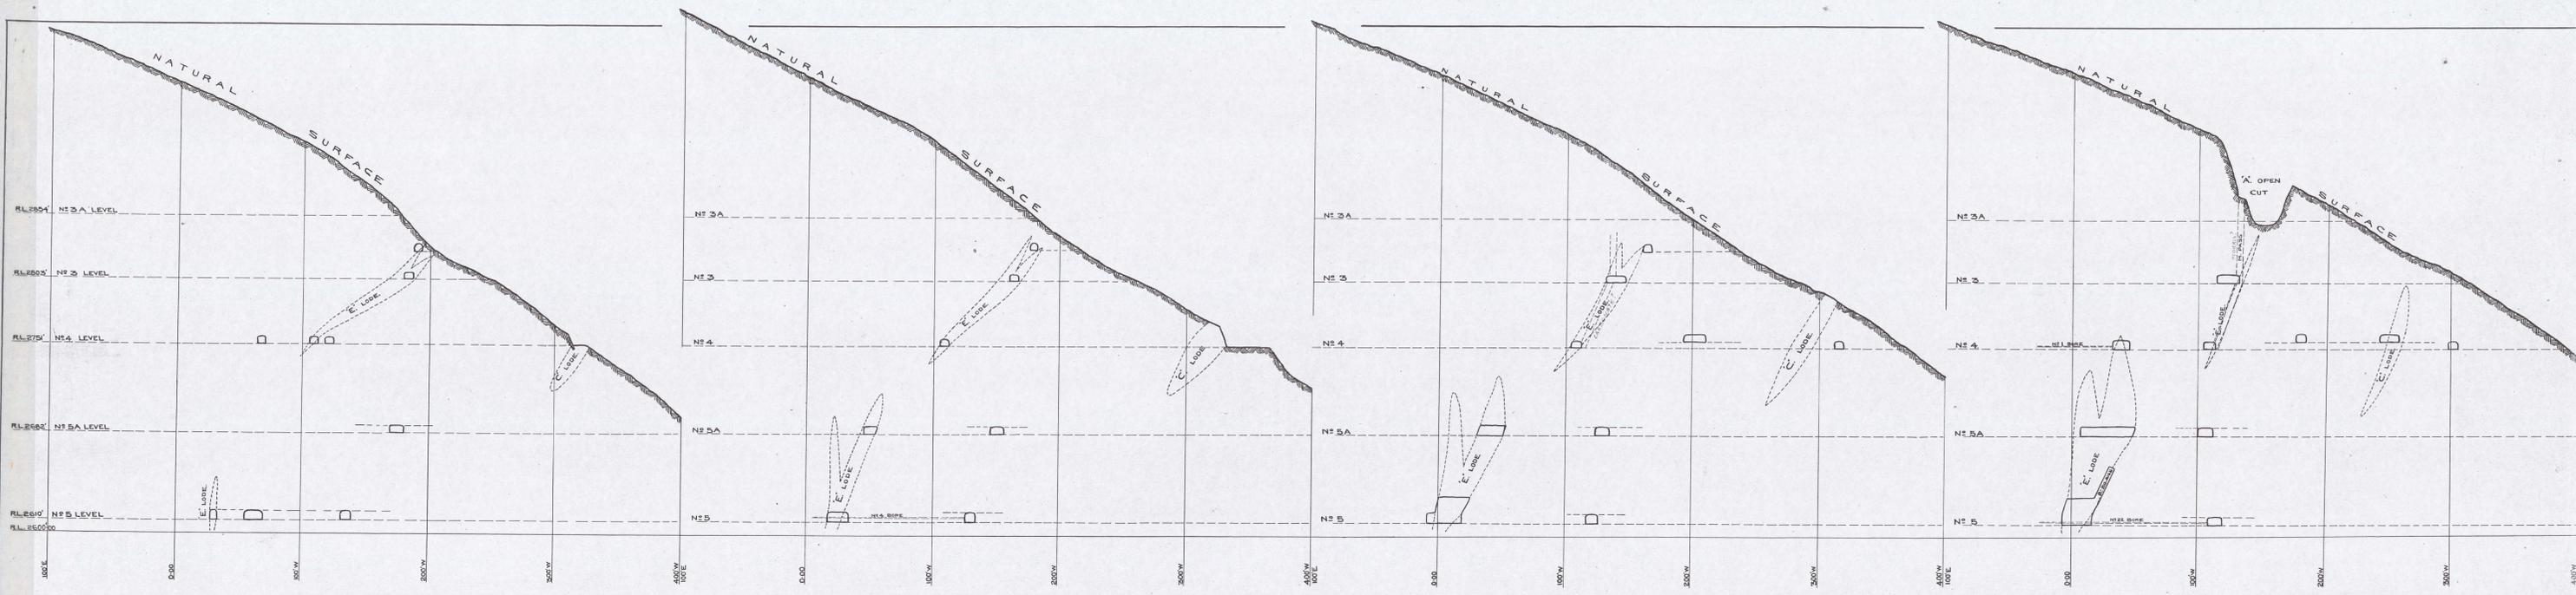


SECTION AT 1050'N

SECTION AT 1025'N

SECTION AT 1000'N

SECTION AT 975'N

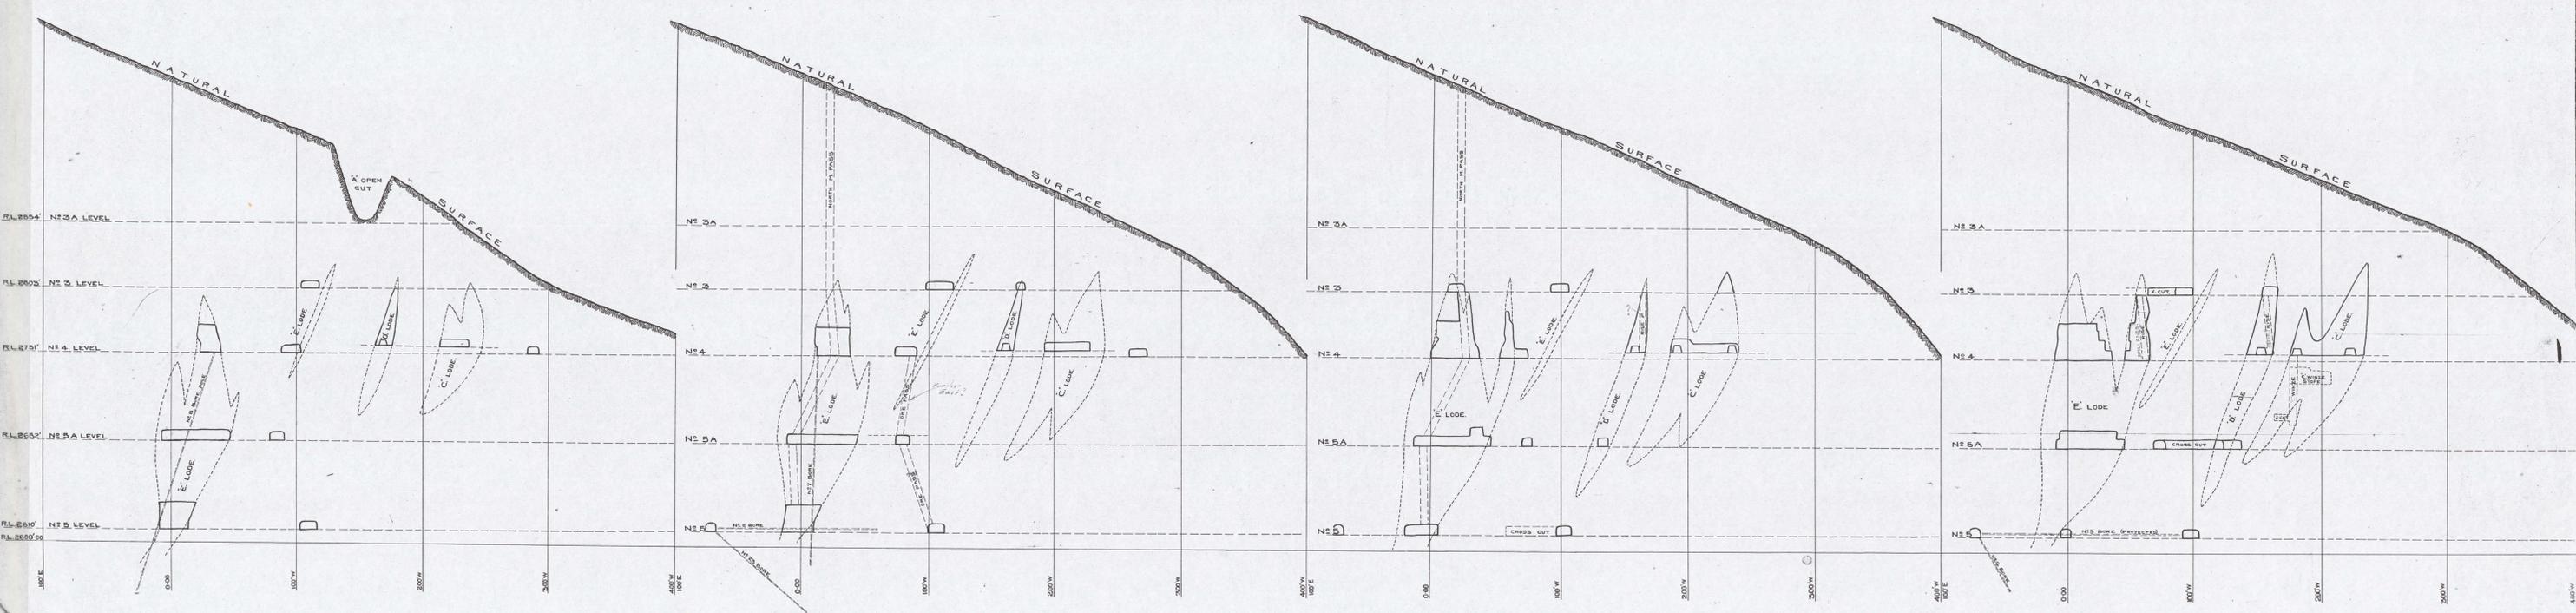

SECTION AT 950'N

SECTION AT 925'N

SECTION AT 900'N

SECTION AT 875'N HG 2



WORK DONE FROM [] TO [] SHOWN IN RED

APPROVED BY	DATE	DATE	NOTE - SECTIONS ABOVE N2 4 LEVEL TAKEN FROM M2 LYELL M&R CO. DRAWINGS
		8/3/25	WEST COAST DEPARTMENT MINES HERCULES MINE SECTIONS THROUGH OREBODIES FROM 975' NORTH TO 1050' NORTH
		8/3/25	
			ELECTROLYTIC ZINC CO. OF AUSTRALASIA LTD. HOBART TASMANIA
			SCALE 1" INCH = 50' FEET
			X2-61