



Section along South side of Crosscut

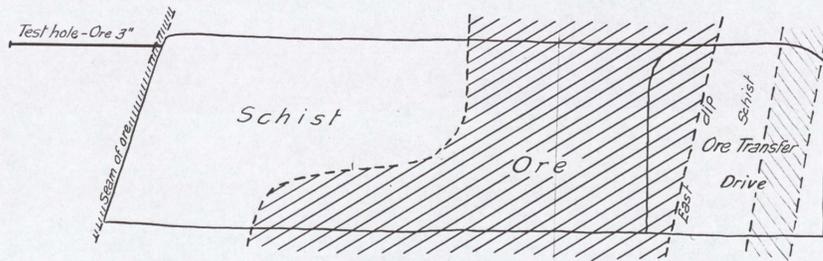

Section along North side of Crosscut

Note:-
Change of dip on north and south
sides of "head" also flat northerly pitch
of hangingwall side of ore

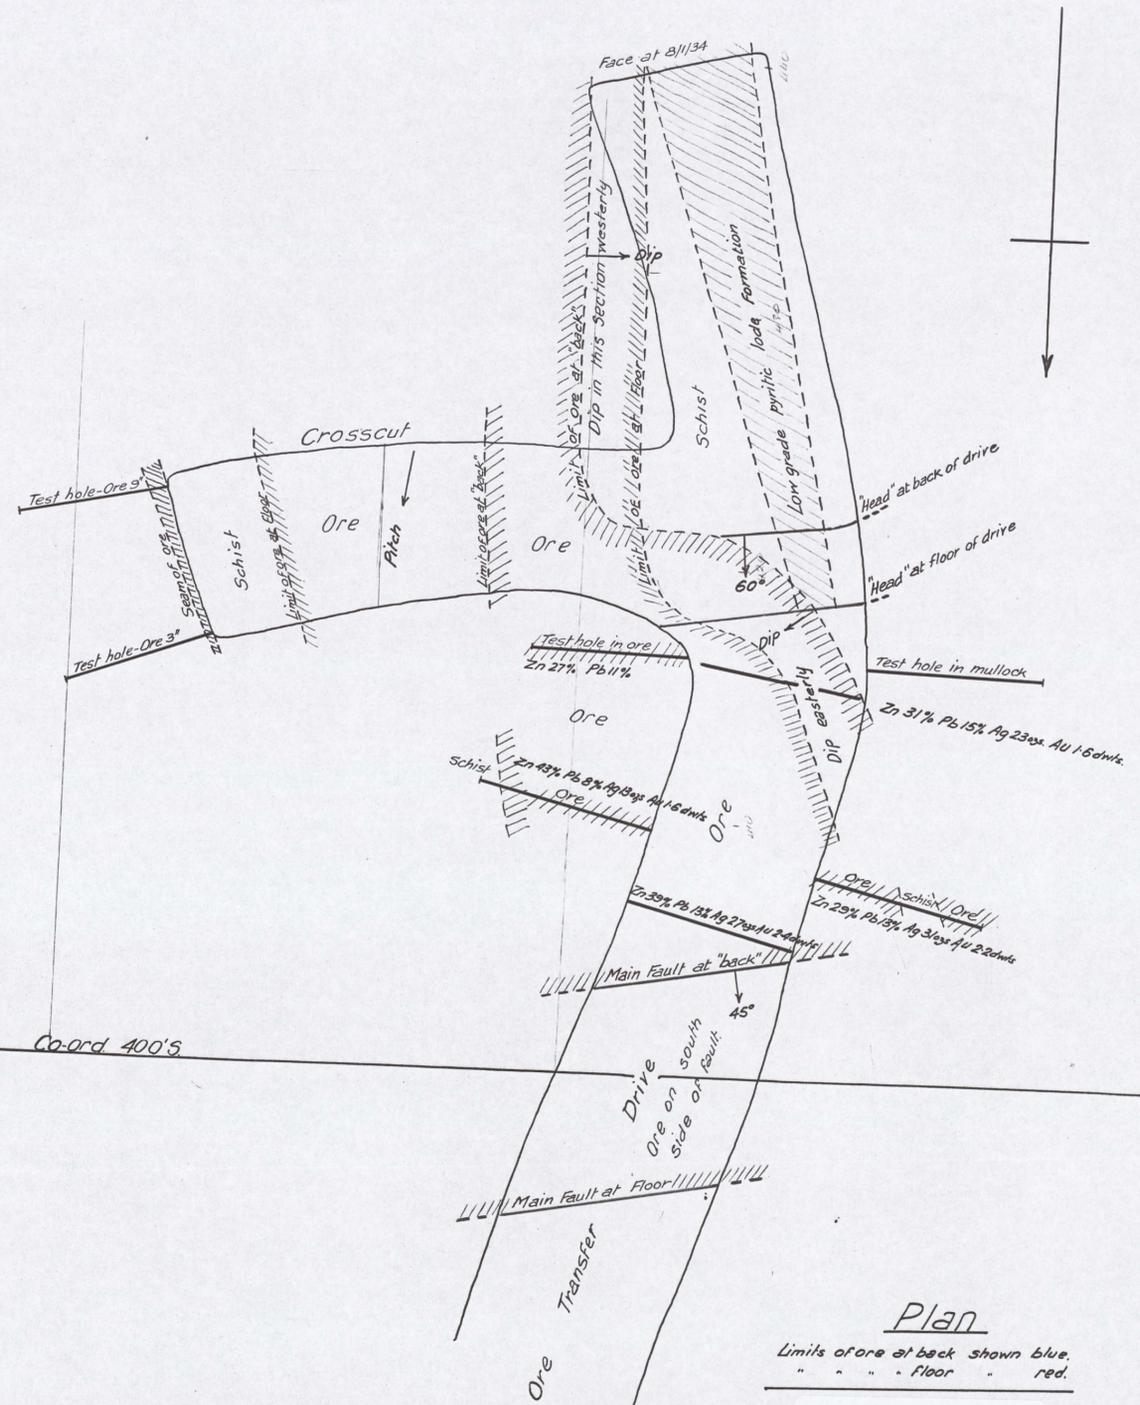

Hercules Mine - Ore Transfer Drive
Plan and Sections of East Crosscut at co-ord. 420'S

— Scale 1in.=4ft. —

0055 - 862

Ore Transfer Drive?