



0055 -
868

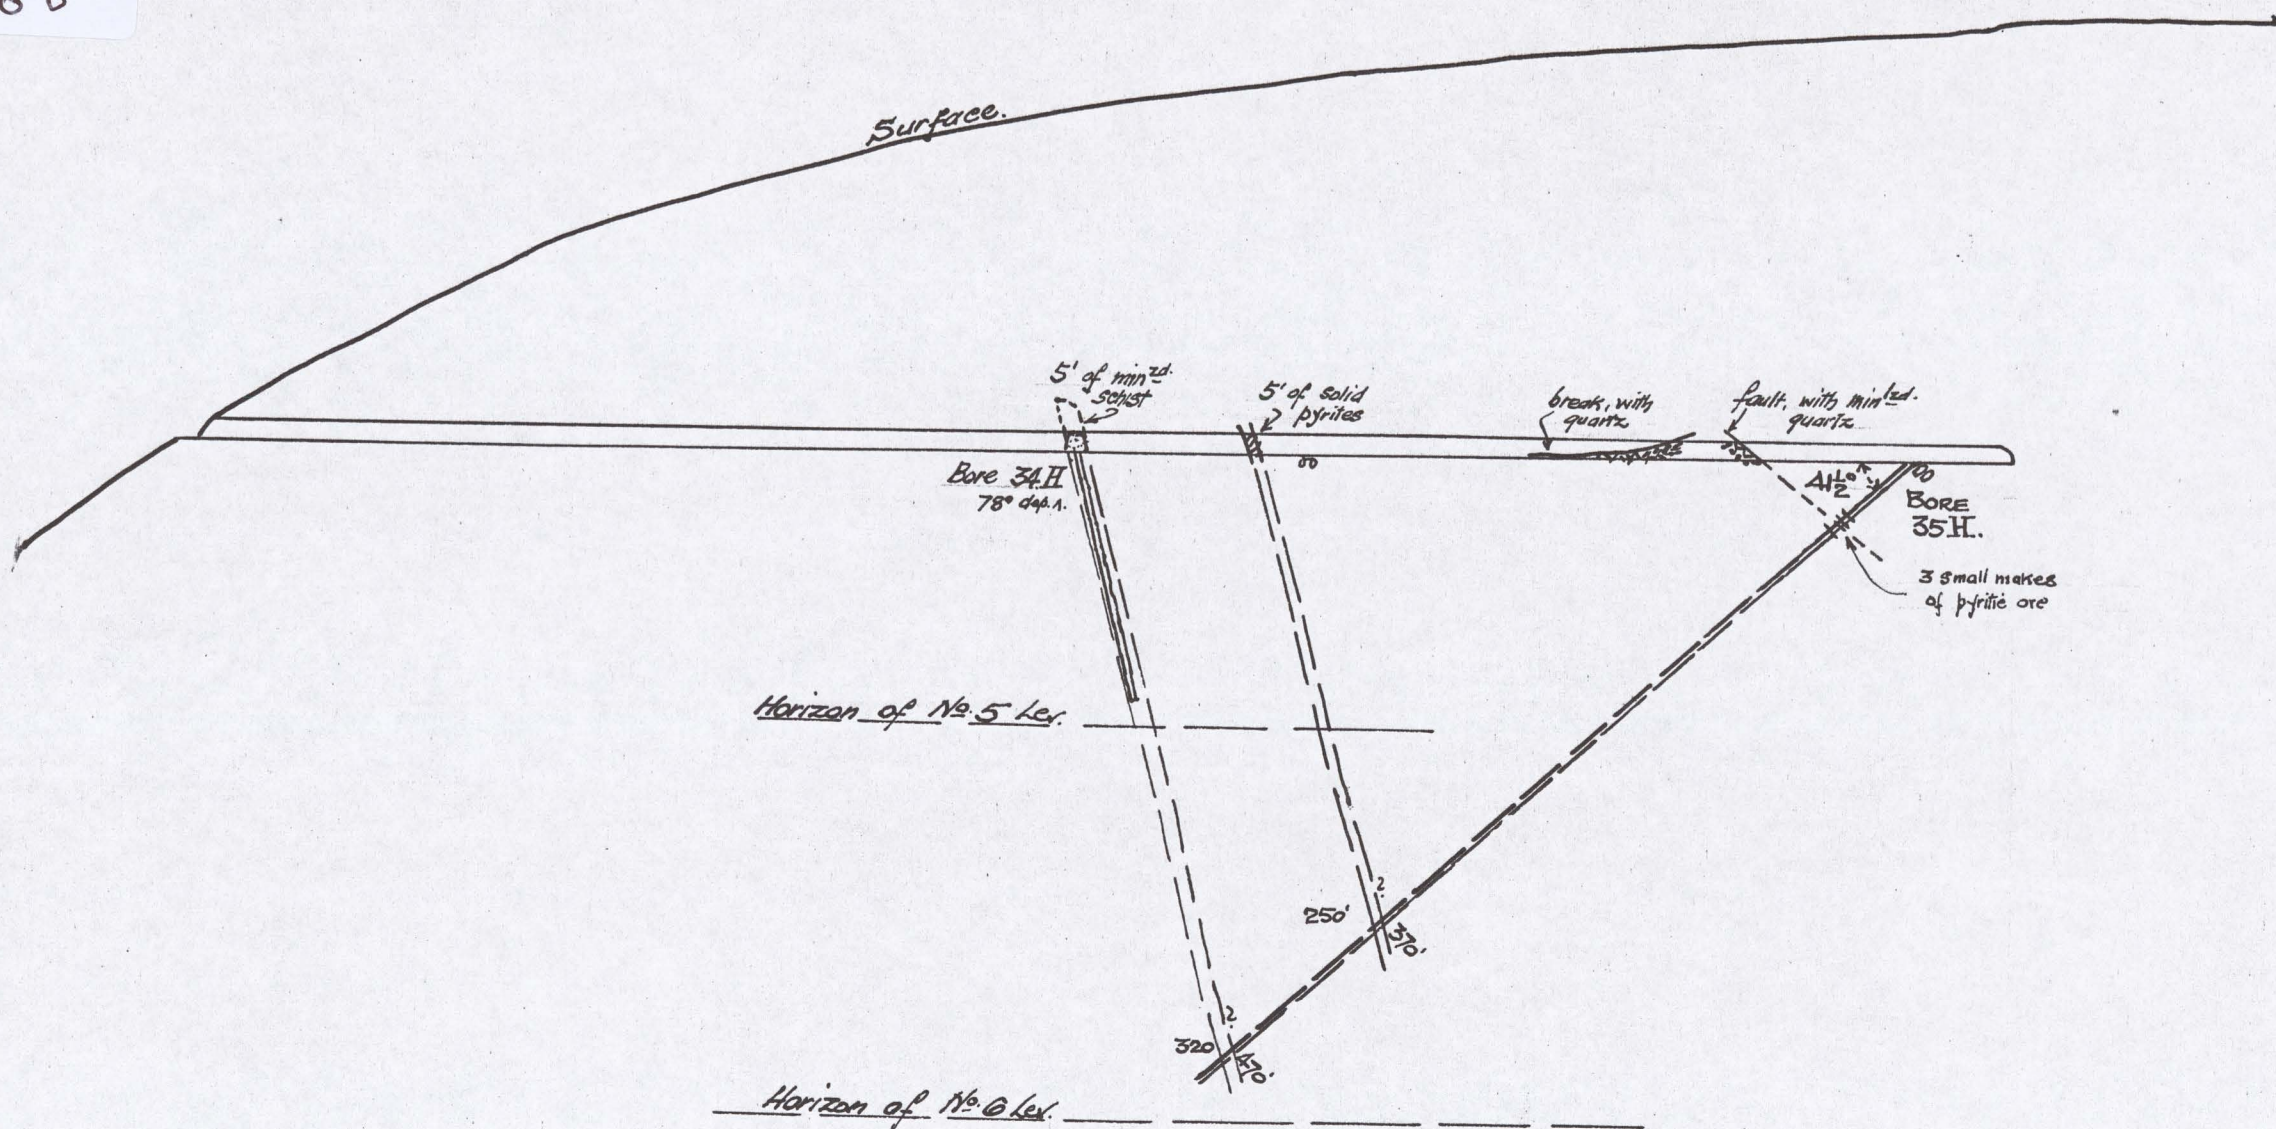

LONGITUDINAL SECTION.

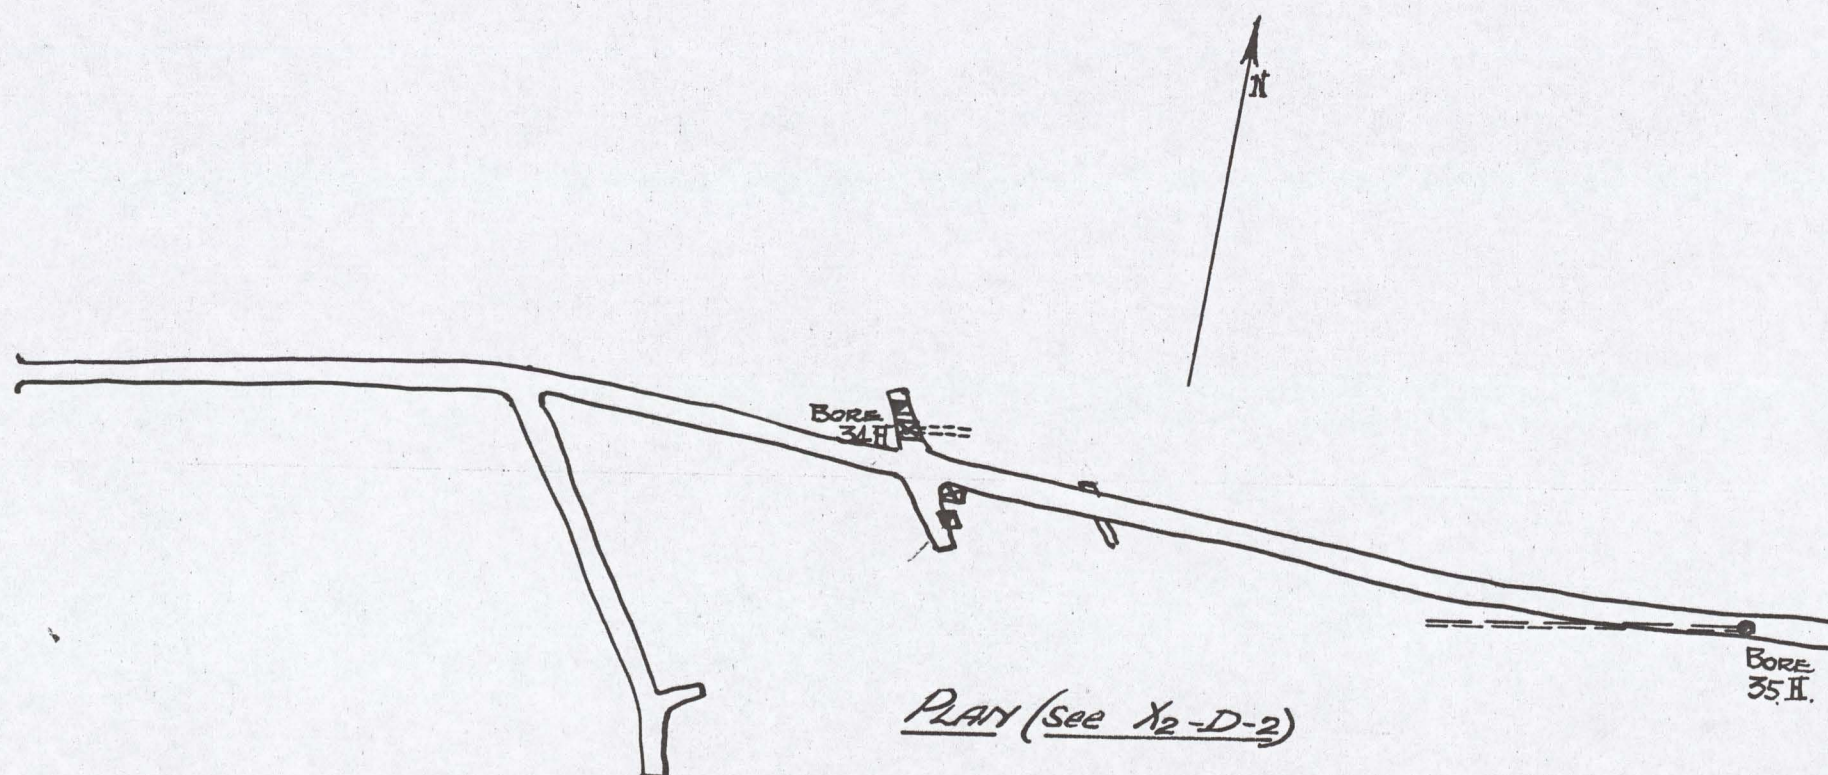

E. Z. C.
PLAN to show BORES 34H & 35H.
in 5th HERCULES EAST ADIT

SCALE: 100 ft. to inch.

K.V.
20/9/26.

5 cm

X20-4