


9d
w

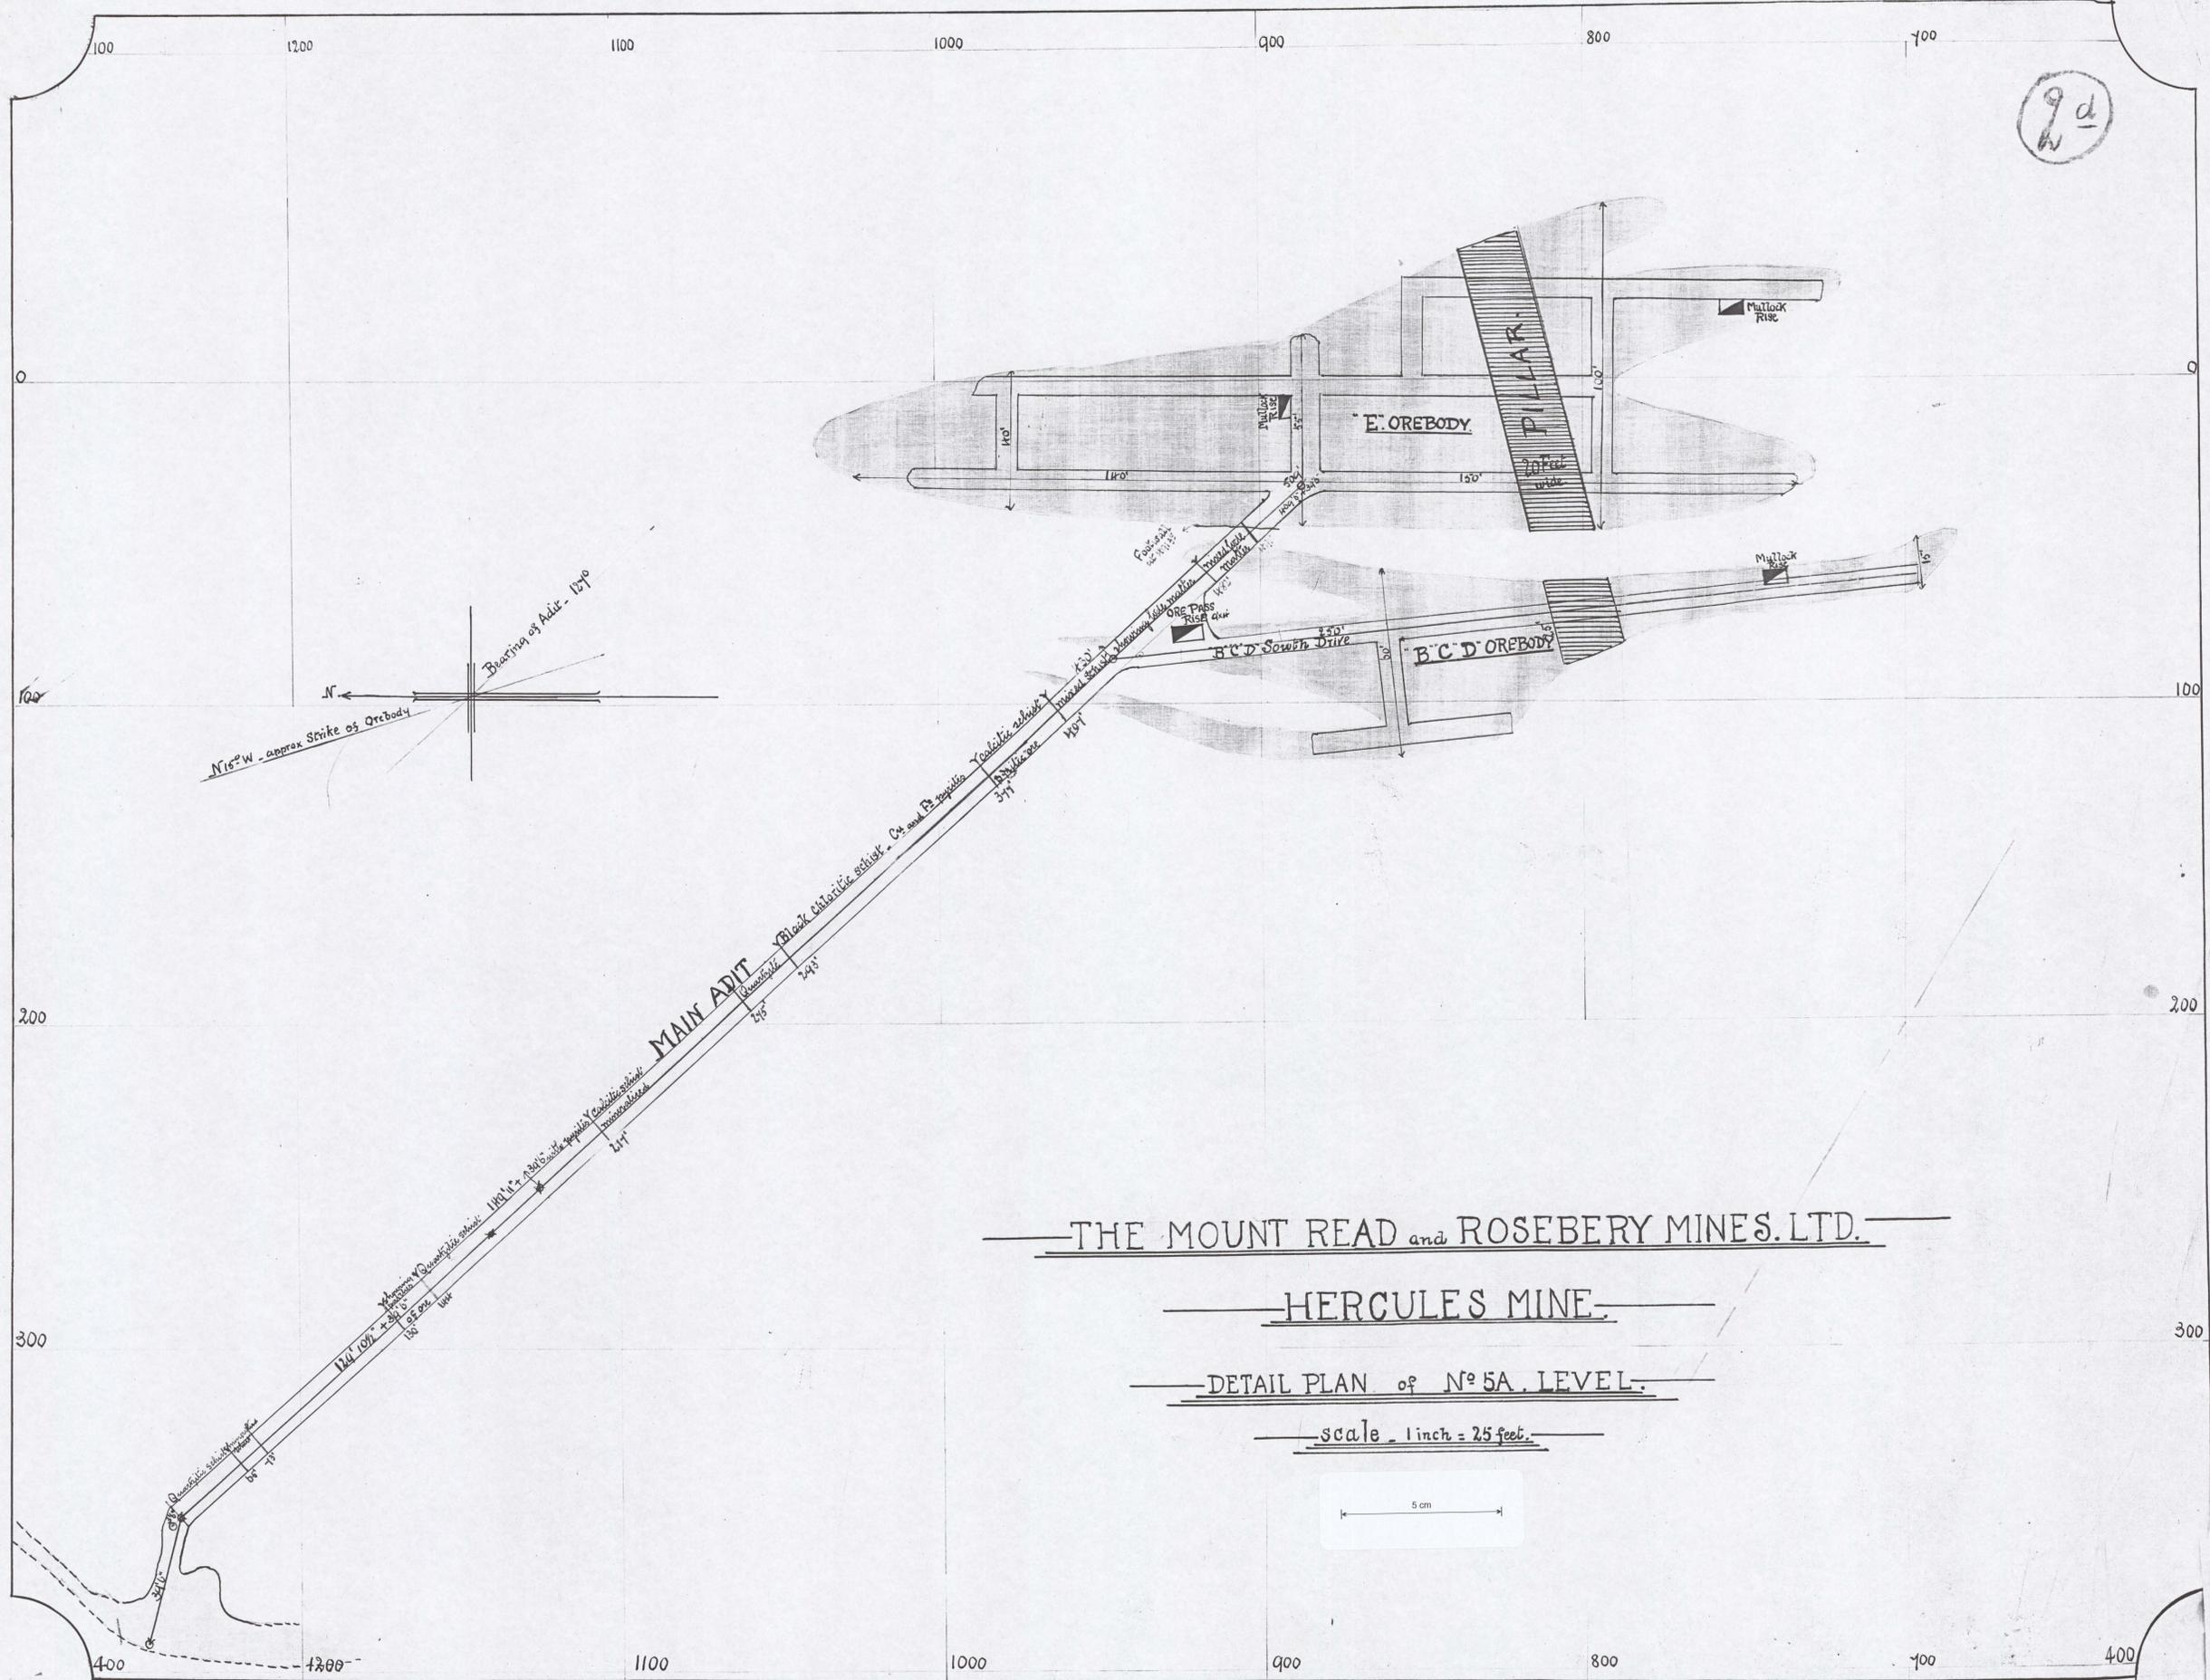


THE MOUNT READ and ROSEBERY MINES. LTD.

HERCULES MINE.

DETAIL PLAN of N° 5A. LEVEL.

scale - 1 inch = 25 feet.

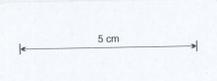

SA Level
Plan
0655 -
873