


X2-52

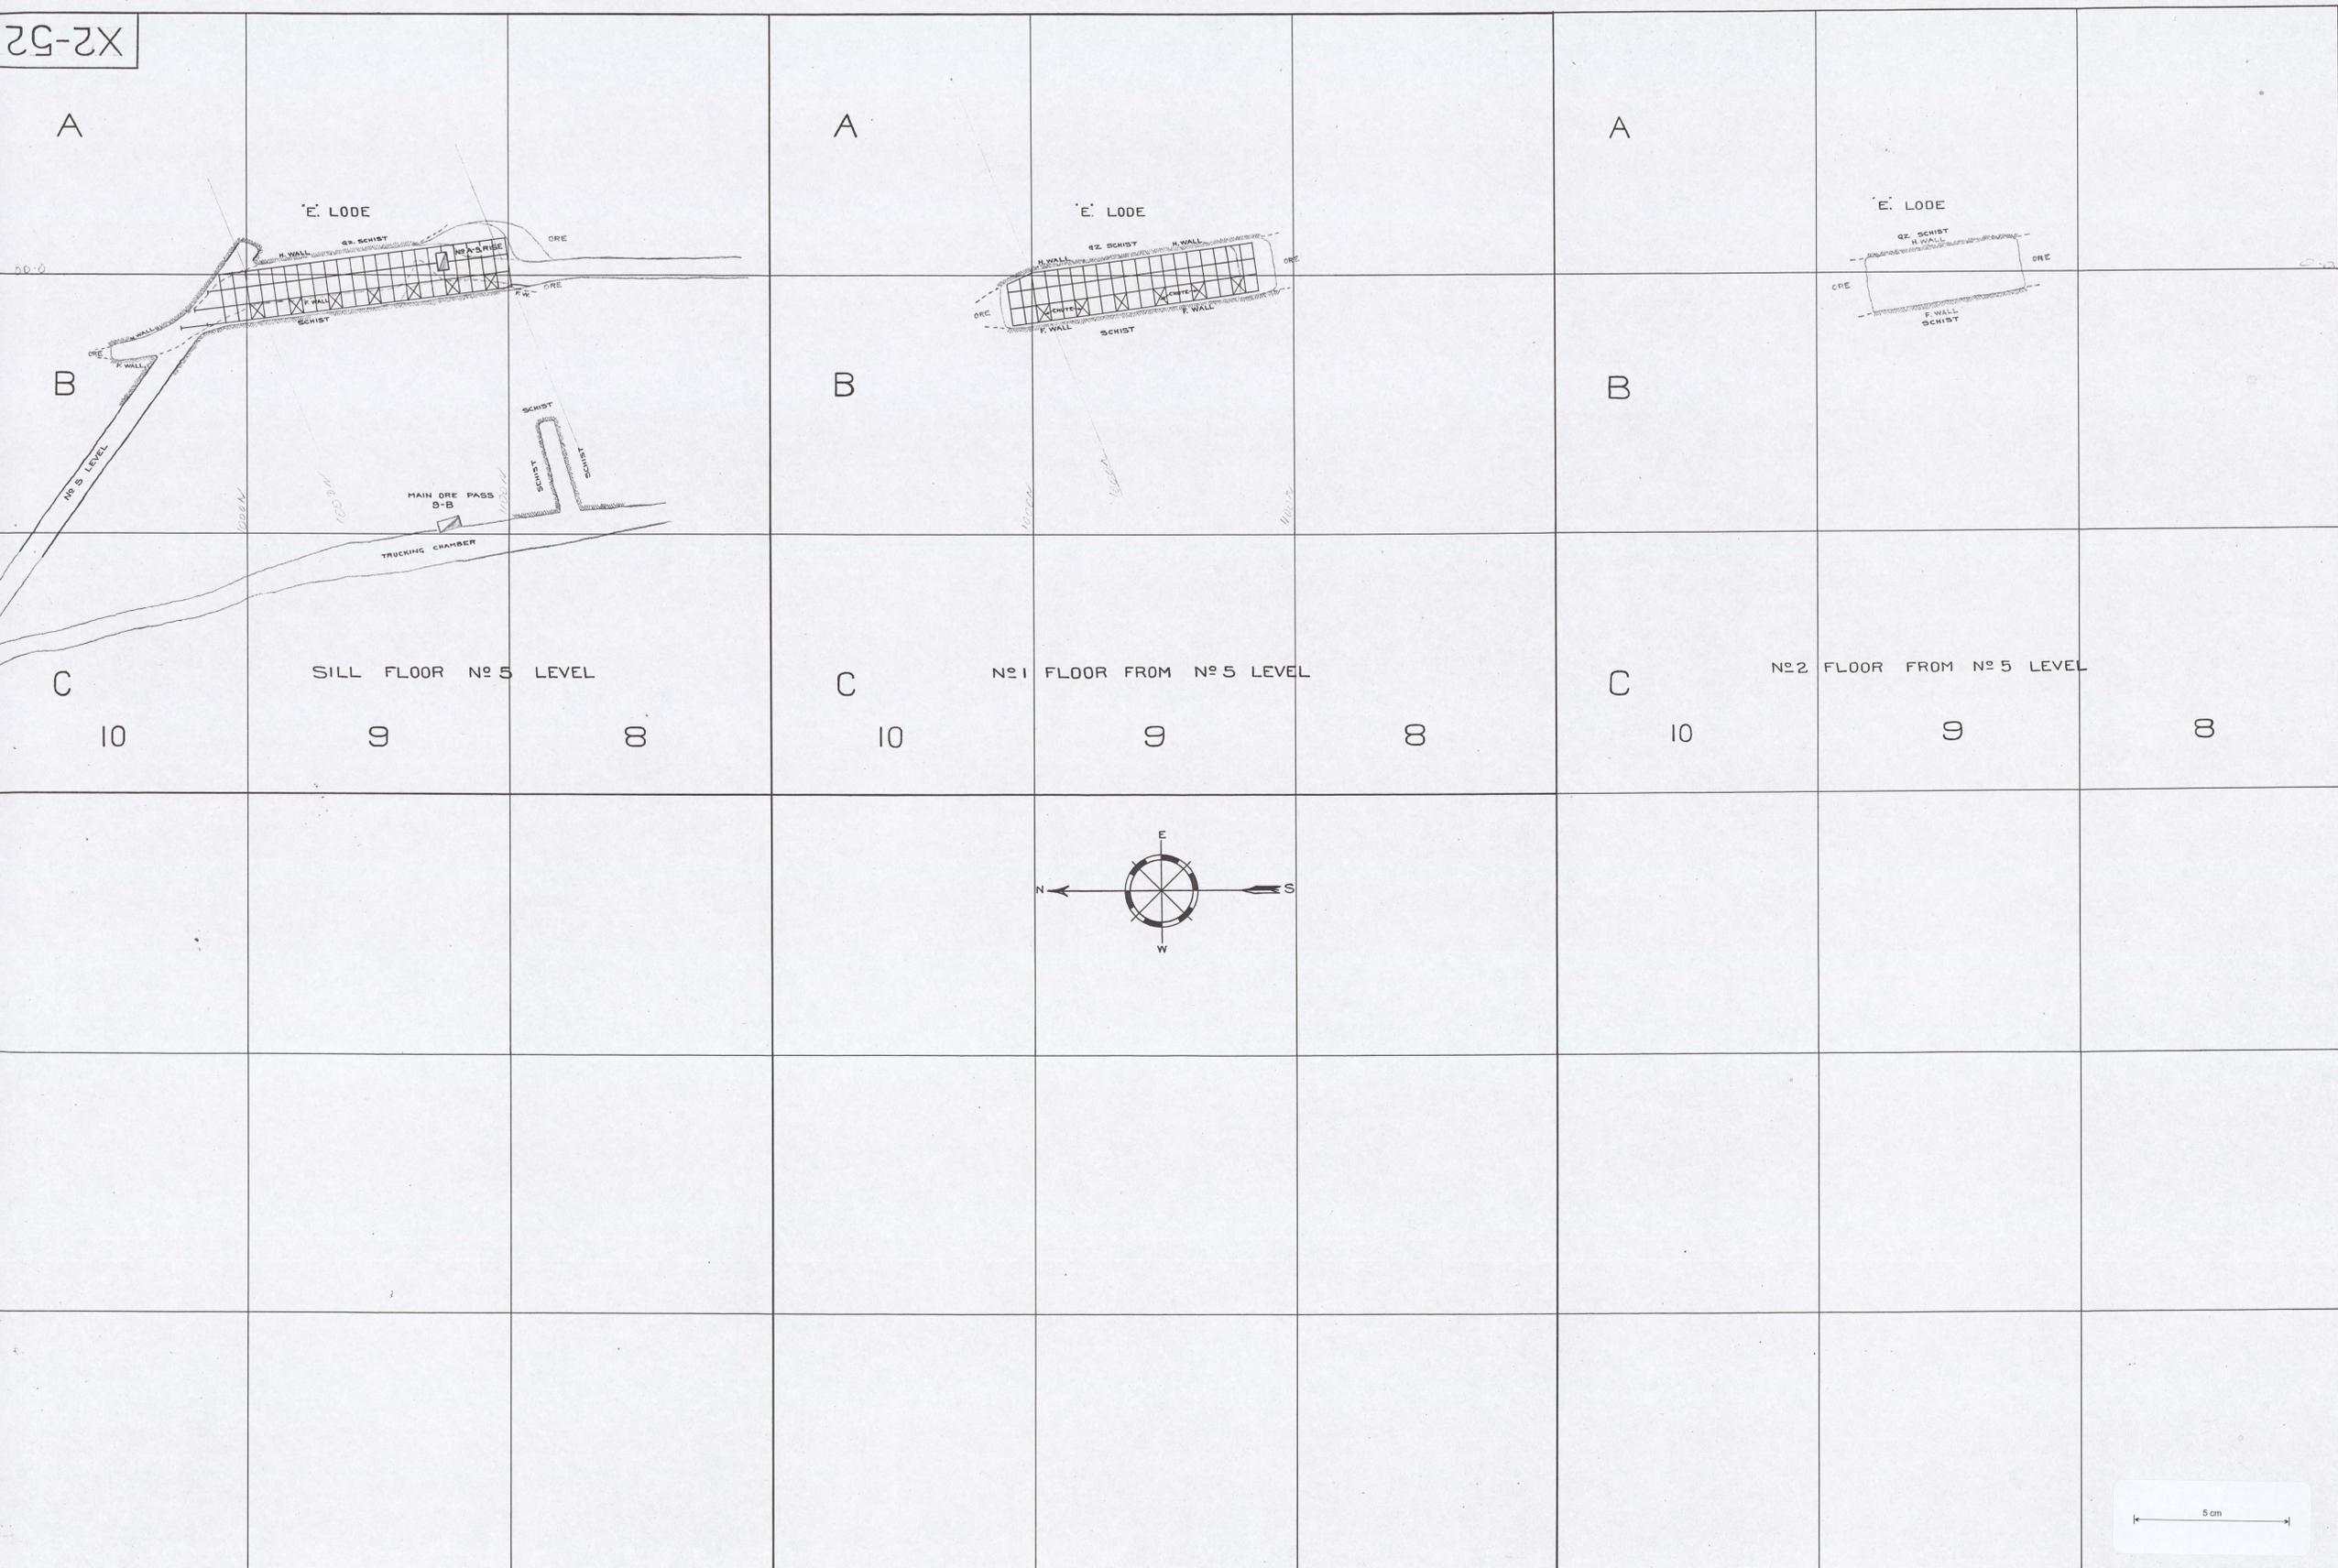

928-5500

Plan of Floors S-5A

ELECTROLYTIC ZINC CO OF AUSTRALASIA LTD
 HOBART TASMANIA
 WEST COAST DEPARTMENT MINES
 HERCULES MINE
 PLAN OF FLOORS BETWEEN No 5 & No 5A LEVELS
 SCALE 1" = 30 FEET

WORK DONE FROM [] TO [] SHOWN IN RED

All relevant information transferred to new survey-plans Sept 1966
 This tracing is not required to be kept by survey-office. P.V.A.

SCALE 1" = 30 FEET

X2-5