


X2-54

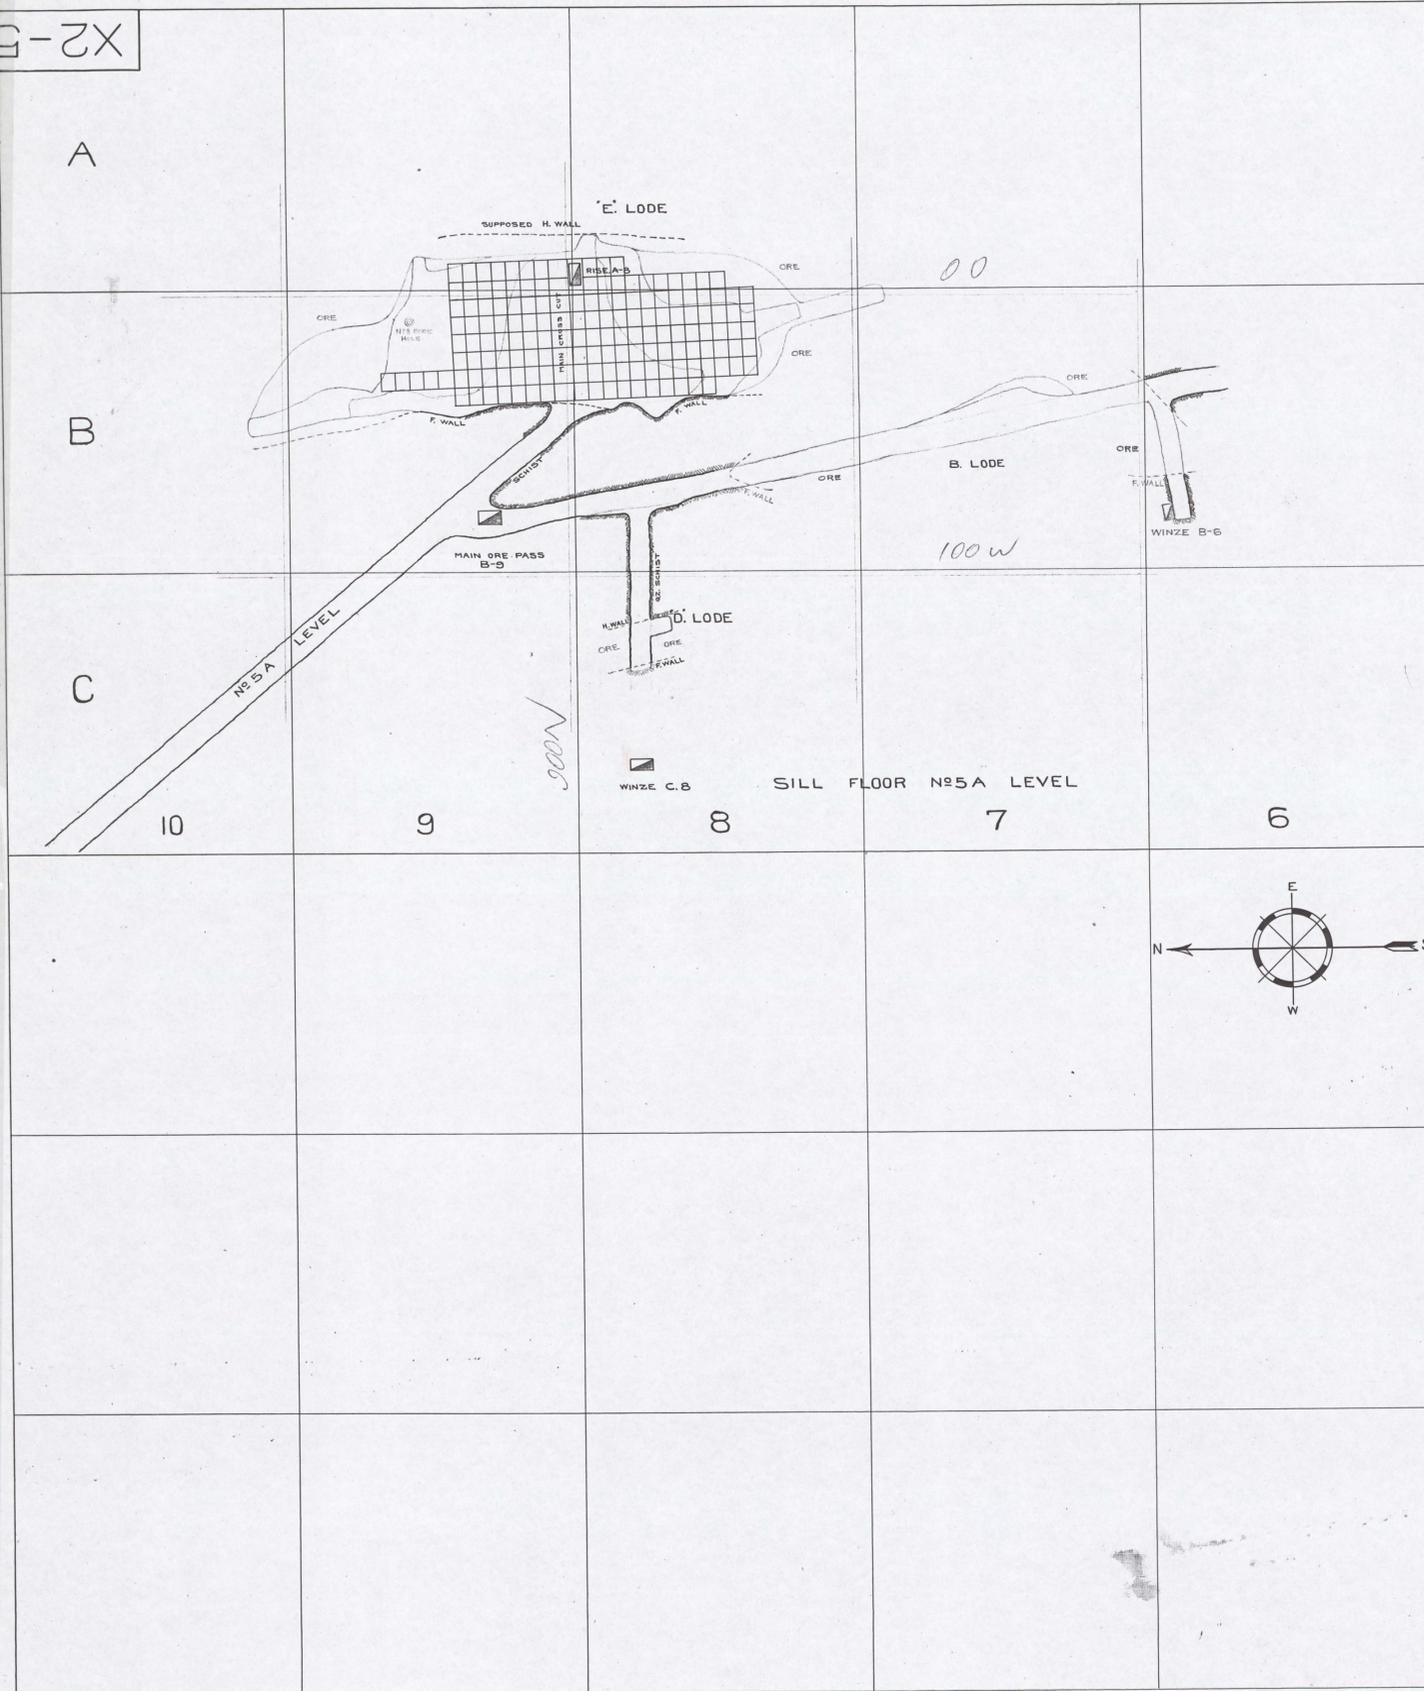

ELECTROLYTIC ZINC CO OF AUSTRALASIA LTD
 HOBART TASMANIA
 WEST COAST DEPARTMENT MINES
HERCULES MINE
 PLAN OF FLOORS BETWEEN No 5A & No 4 LEVELS
 SCALE 1" = 30'

WORK DONE FROM [] TO [] SHOWN IN RED

ELECTROLYTIC ZINC CO. OF AUSA LTD. MINES DEPT. ROSEBURY, TAS.	
SCALE	
DATE	14/2

All relevant information
 to new survey - pl
 this tracing is to
 be kept by survey

SCALE 1" = 1
X2-54

0055-877

SA Level Plan.