


Sheet Survey Plan

0055-878

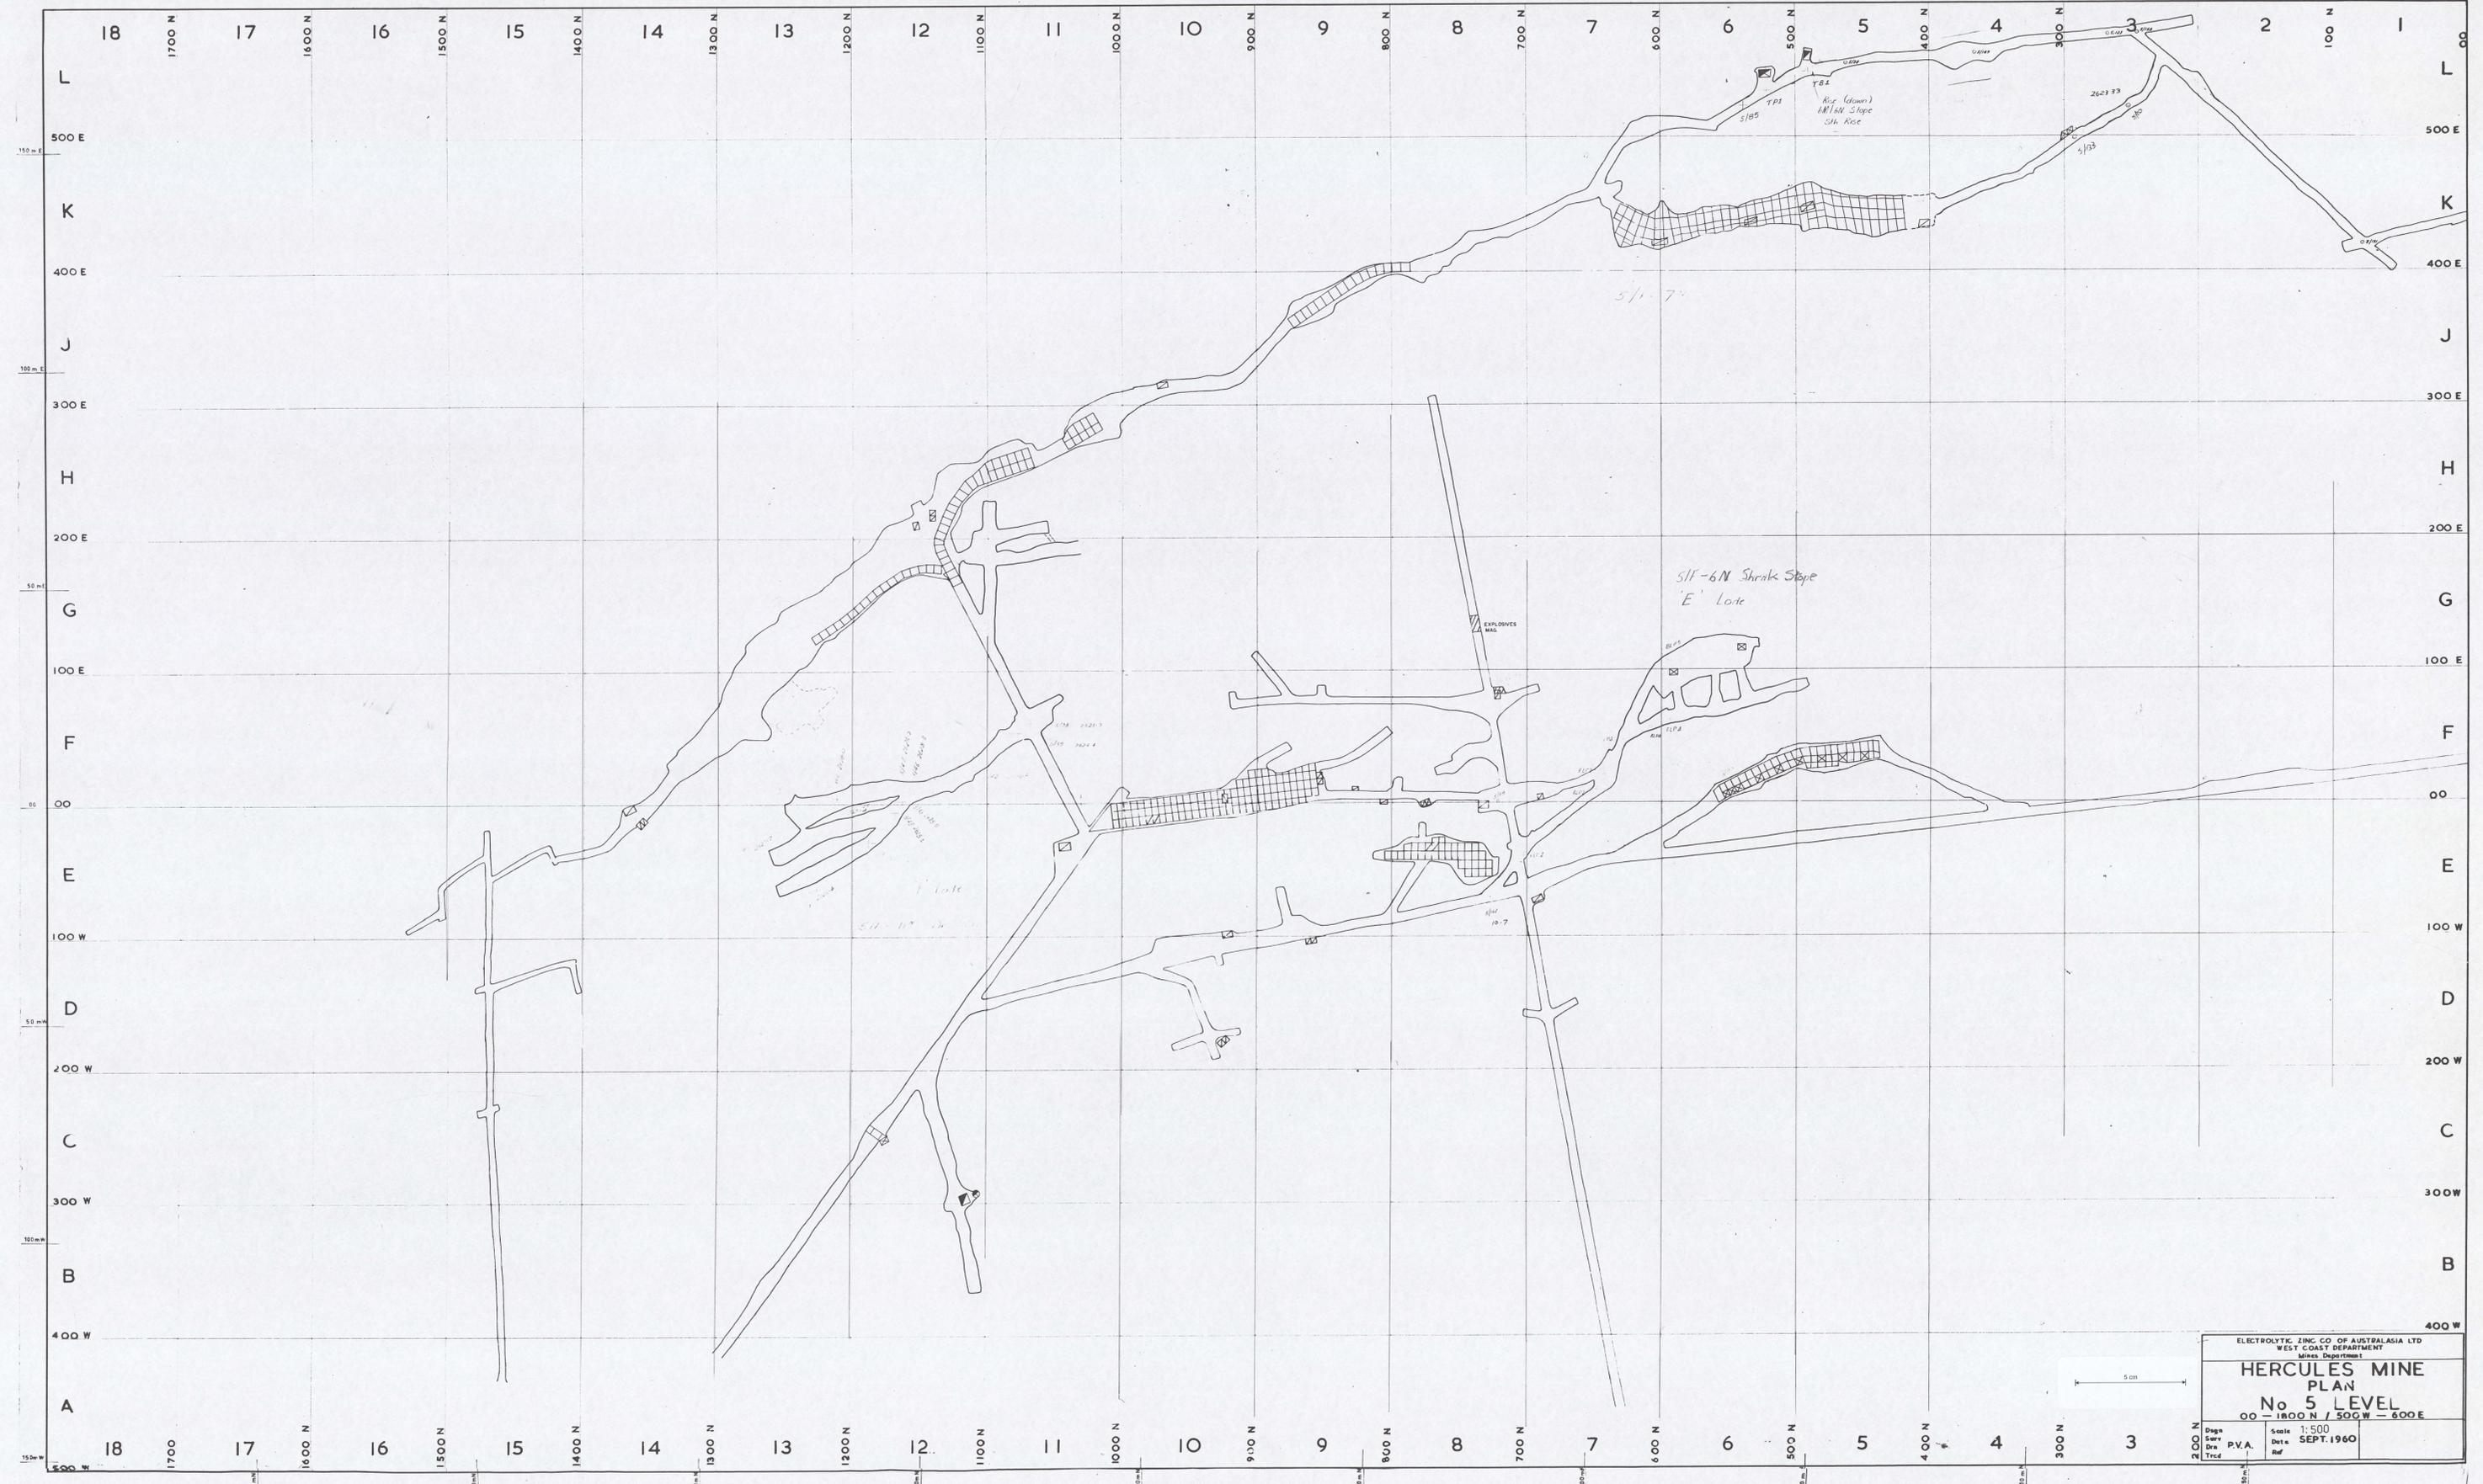

ELECTROLYTIC ZINC CO OF AUSTRALASIA LTD WEST COAST DEPARTMENT Mines Department	
<b>HERCULES MINE PLAN No 5 LEVEL</b>	
00 - 1800 N / 500 E - 600 E	
Drawn 2000 N	Scale 1:500
Surv P.V.A.	Date SEPT. 1960
Trcd	Ref