


Surface + Old  
Up Level Workings

0055 -  
880

5 cm

2B

N

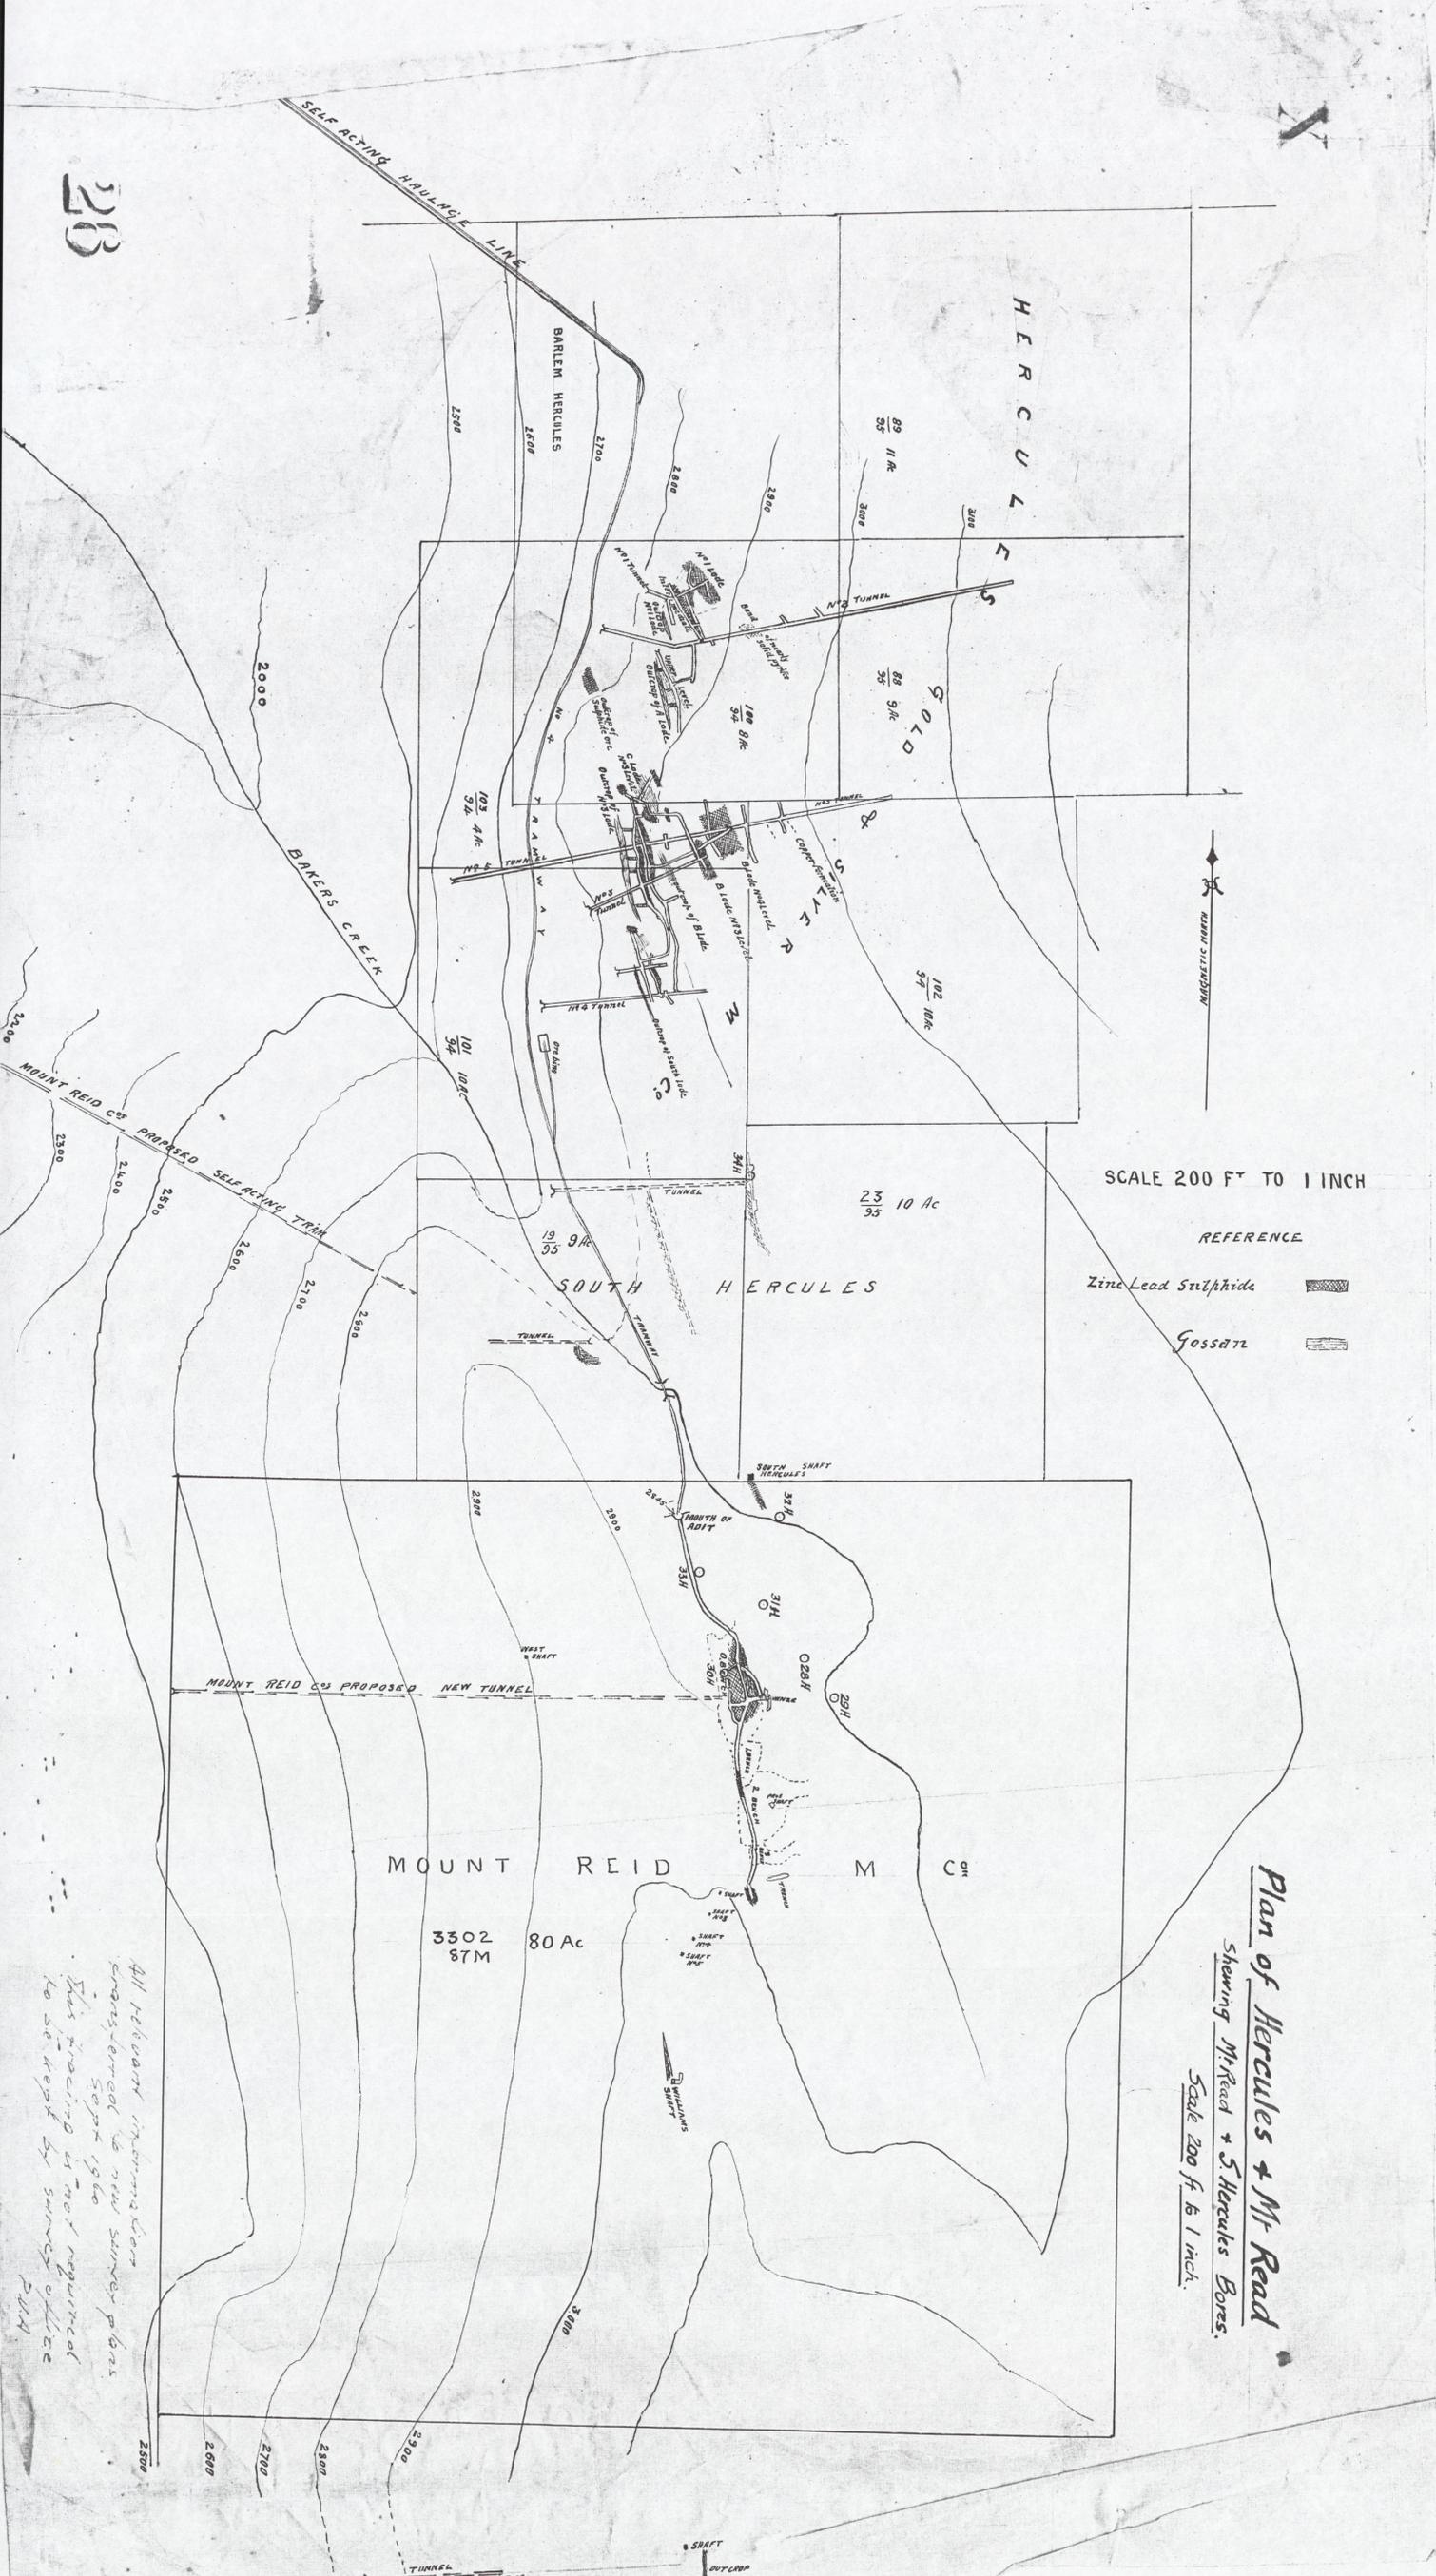

SCALE 200 FT TO 1 INCH

REFERENCE

Zinc-Lead Sulfide 

Gossan 

*Plan of Hercules + Mt Reid*  
*Showing Mt Reid + S. Hercules Bases.*  
*Scale 200 ft to 1 inch.*

All relevant information  
 transferred to new survey plans  
 Sept 1960  
 This tracing is not required  
 to be kept by survey office  
 P.M.