

56-01

5 cm

SOUTH LYELL.

CENTRAL LYELL.


RESERVOIR.

RESERVOIR.

172
91

27
90

1435
1314
121

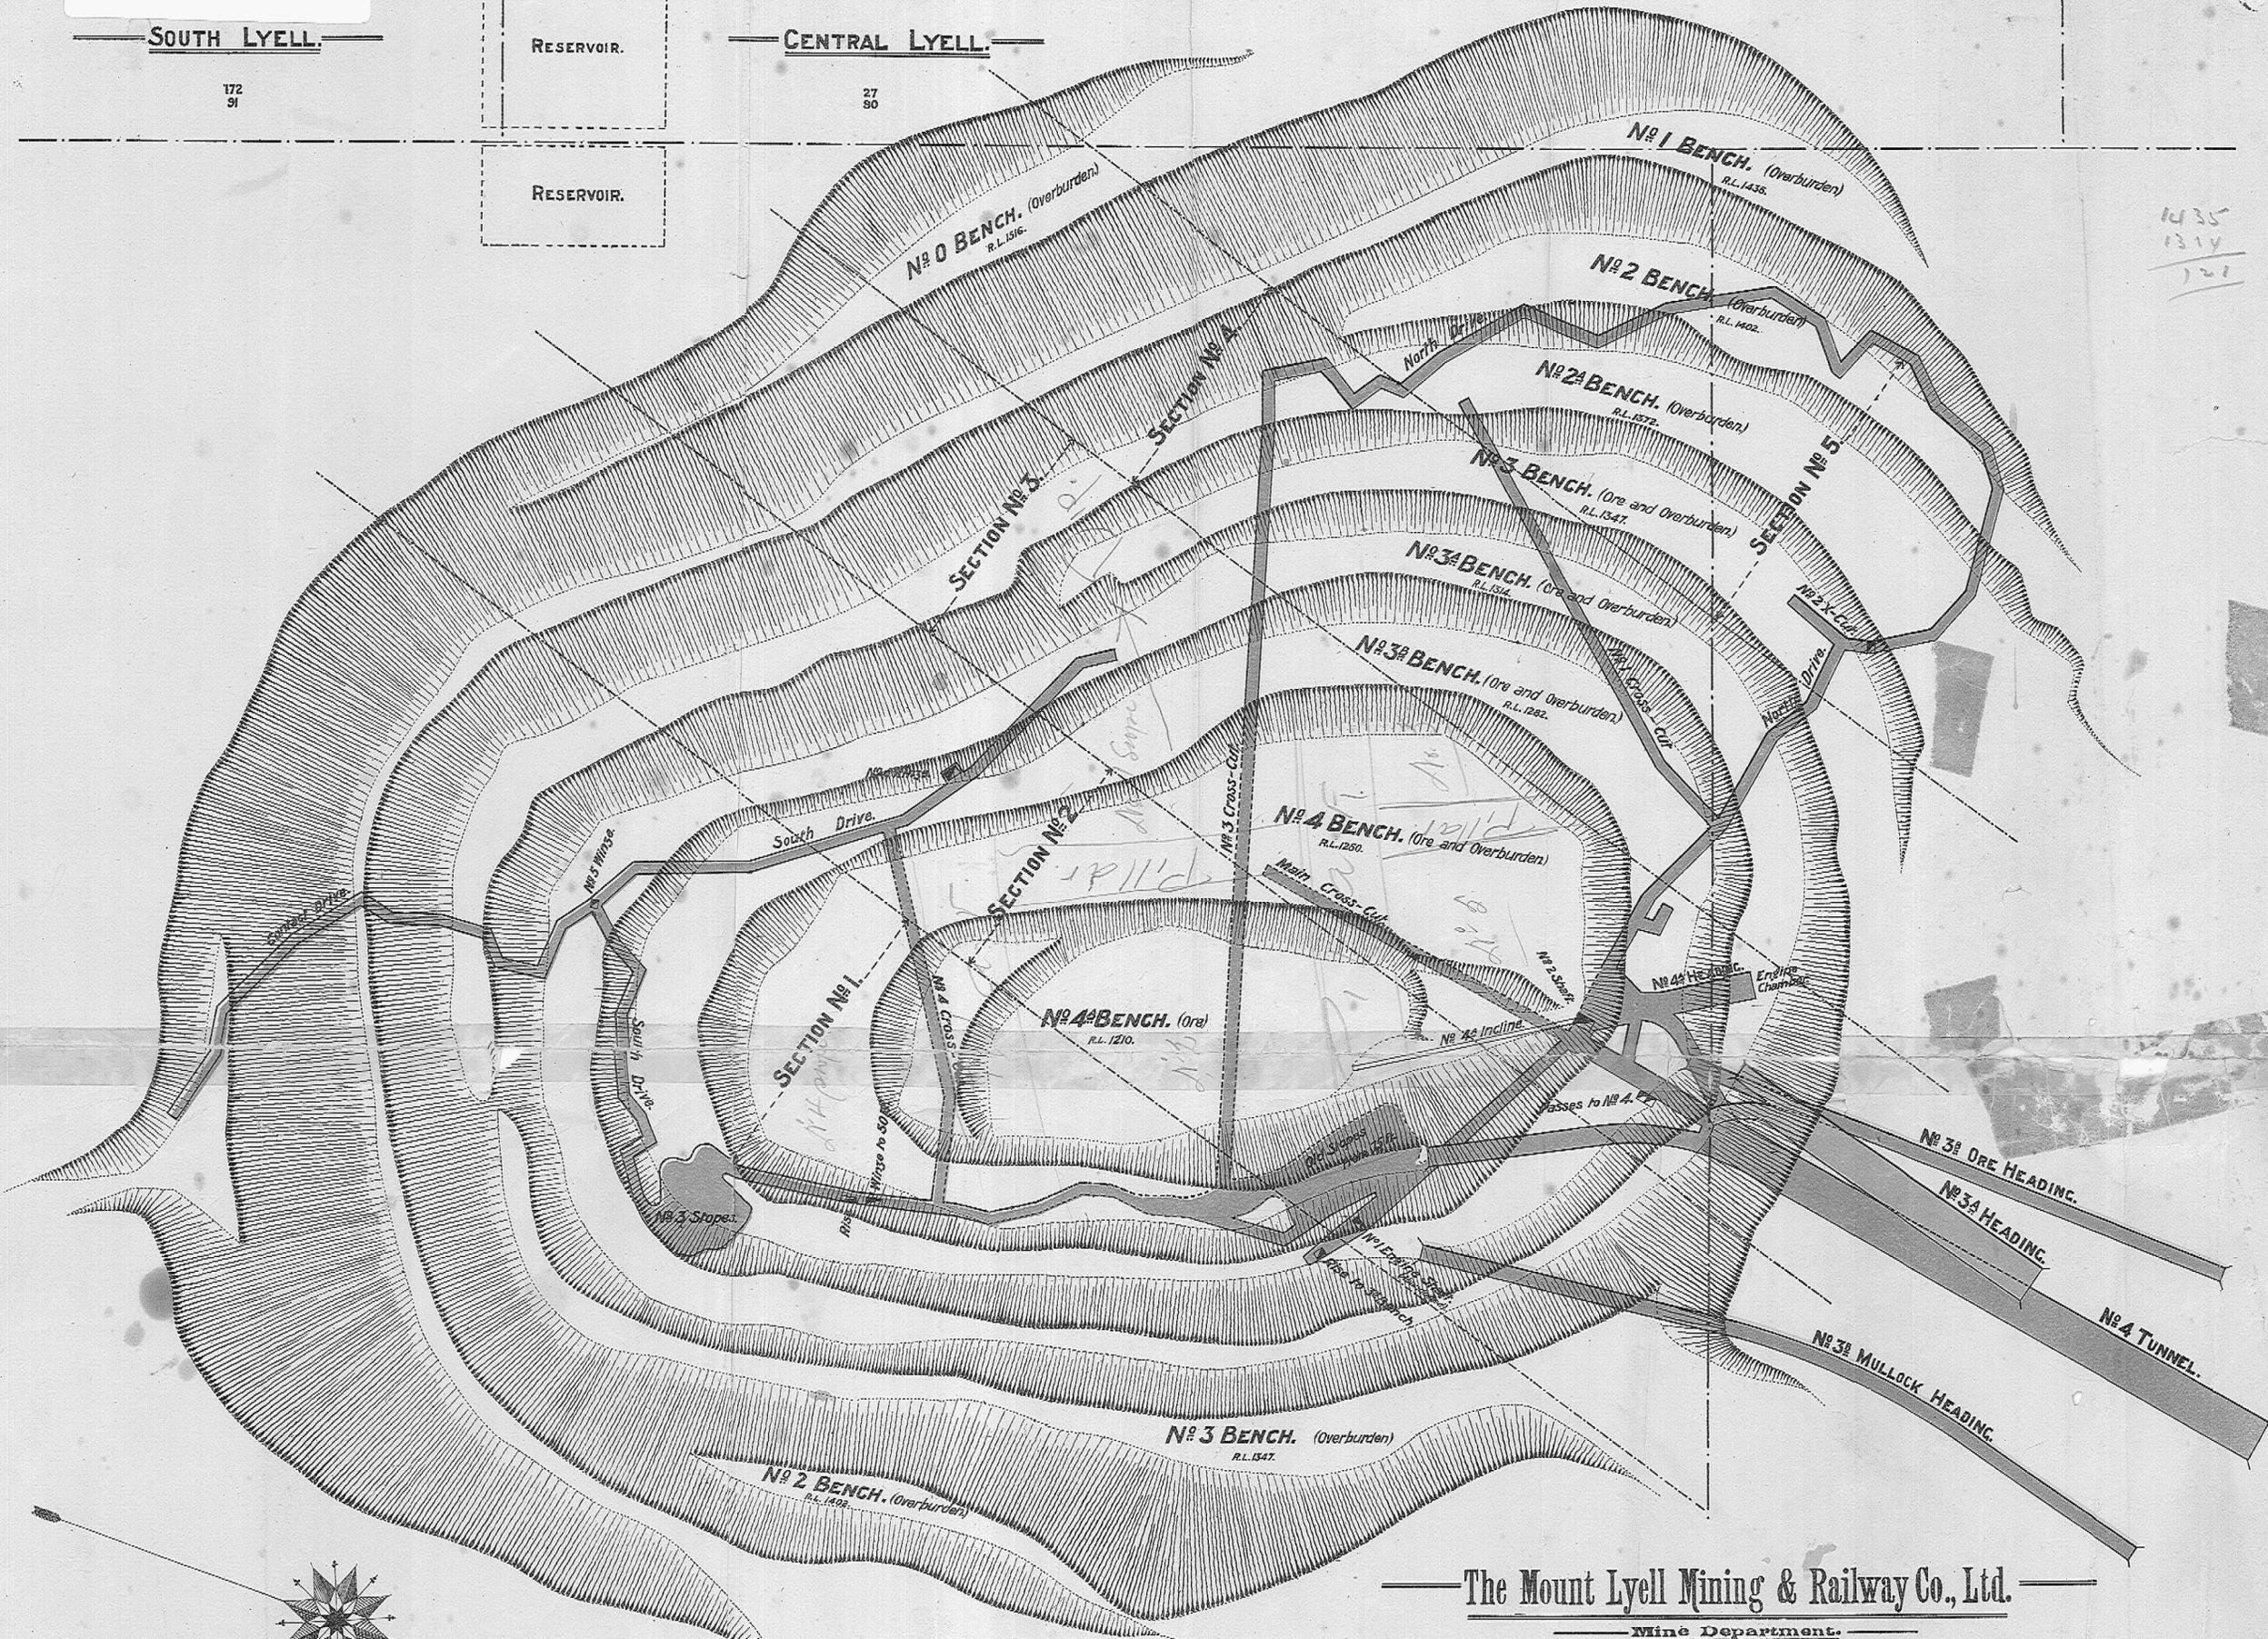

The Mount Lyell Mining & Railway Co., Ltd.

Mine Department.

PLAN OF
MOUNT LYELL OPEN CUT.

SCALE 1 INCH=50 FEET.

Brought up to 30th Sept 1905.

Robt. Smith

14
86

13
86