
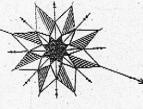
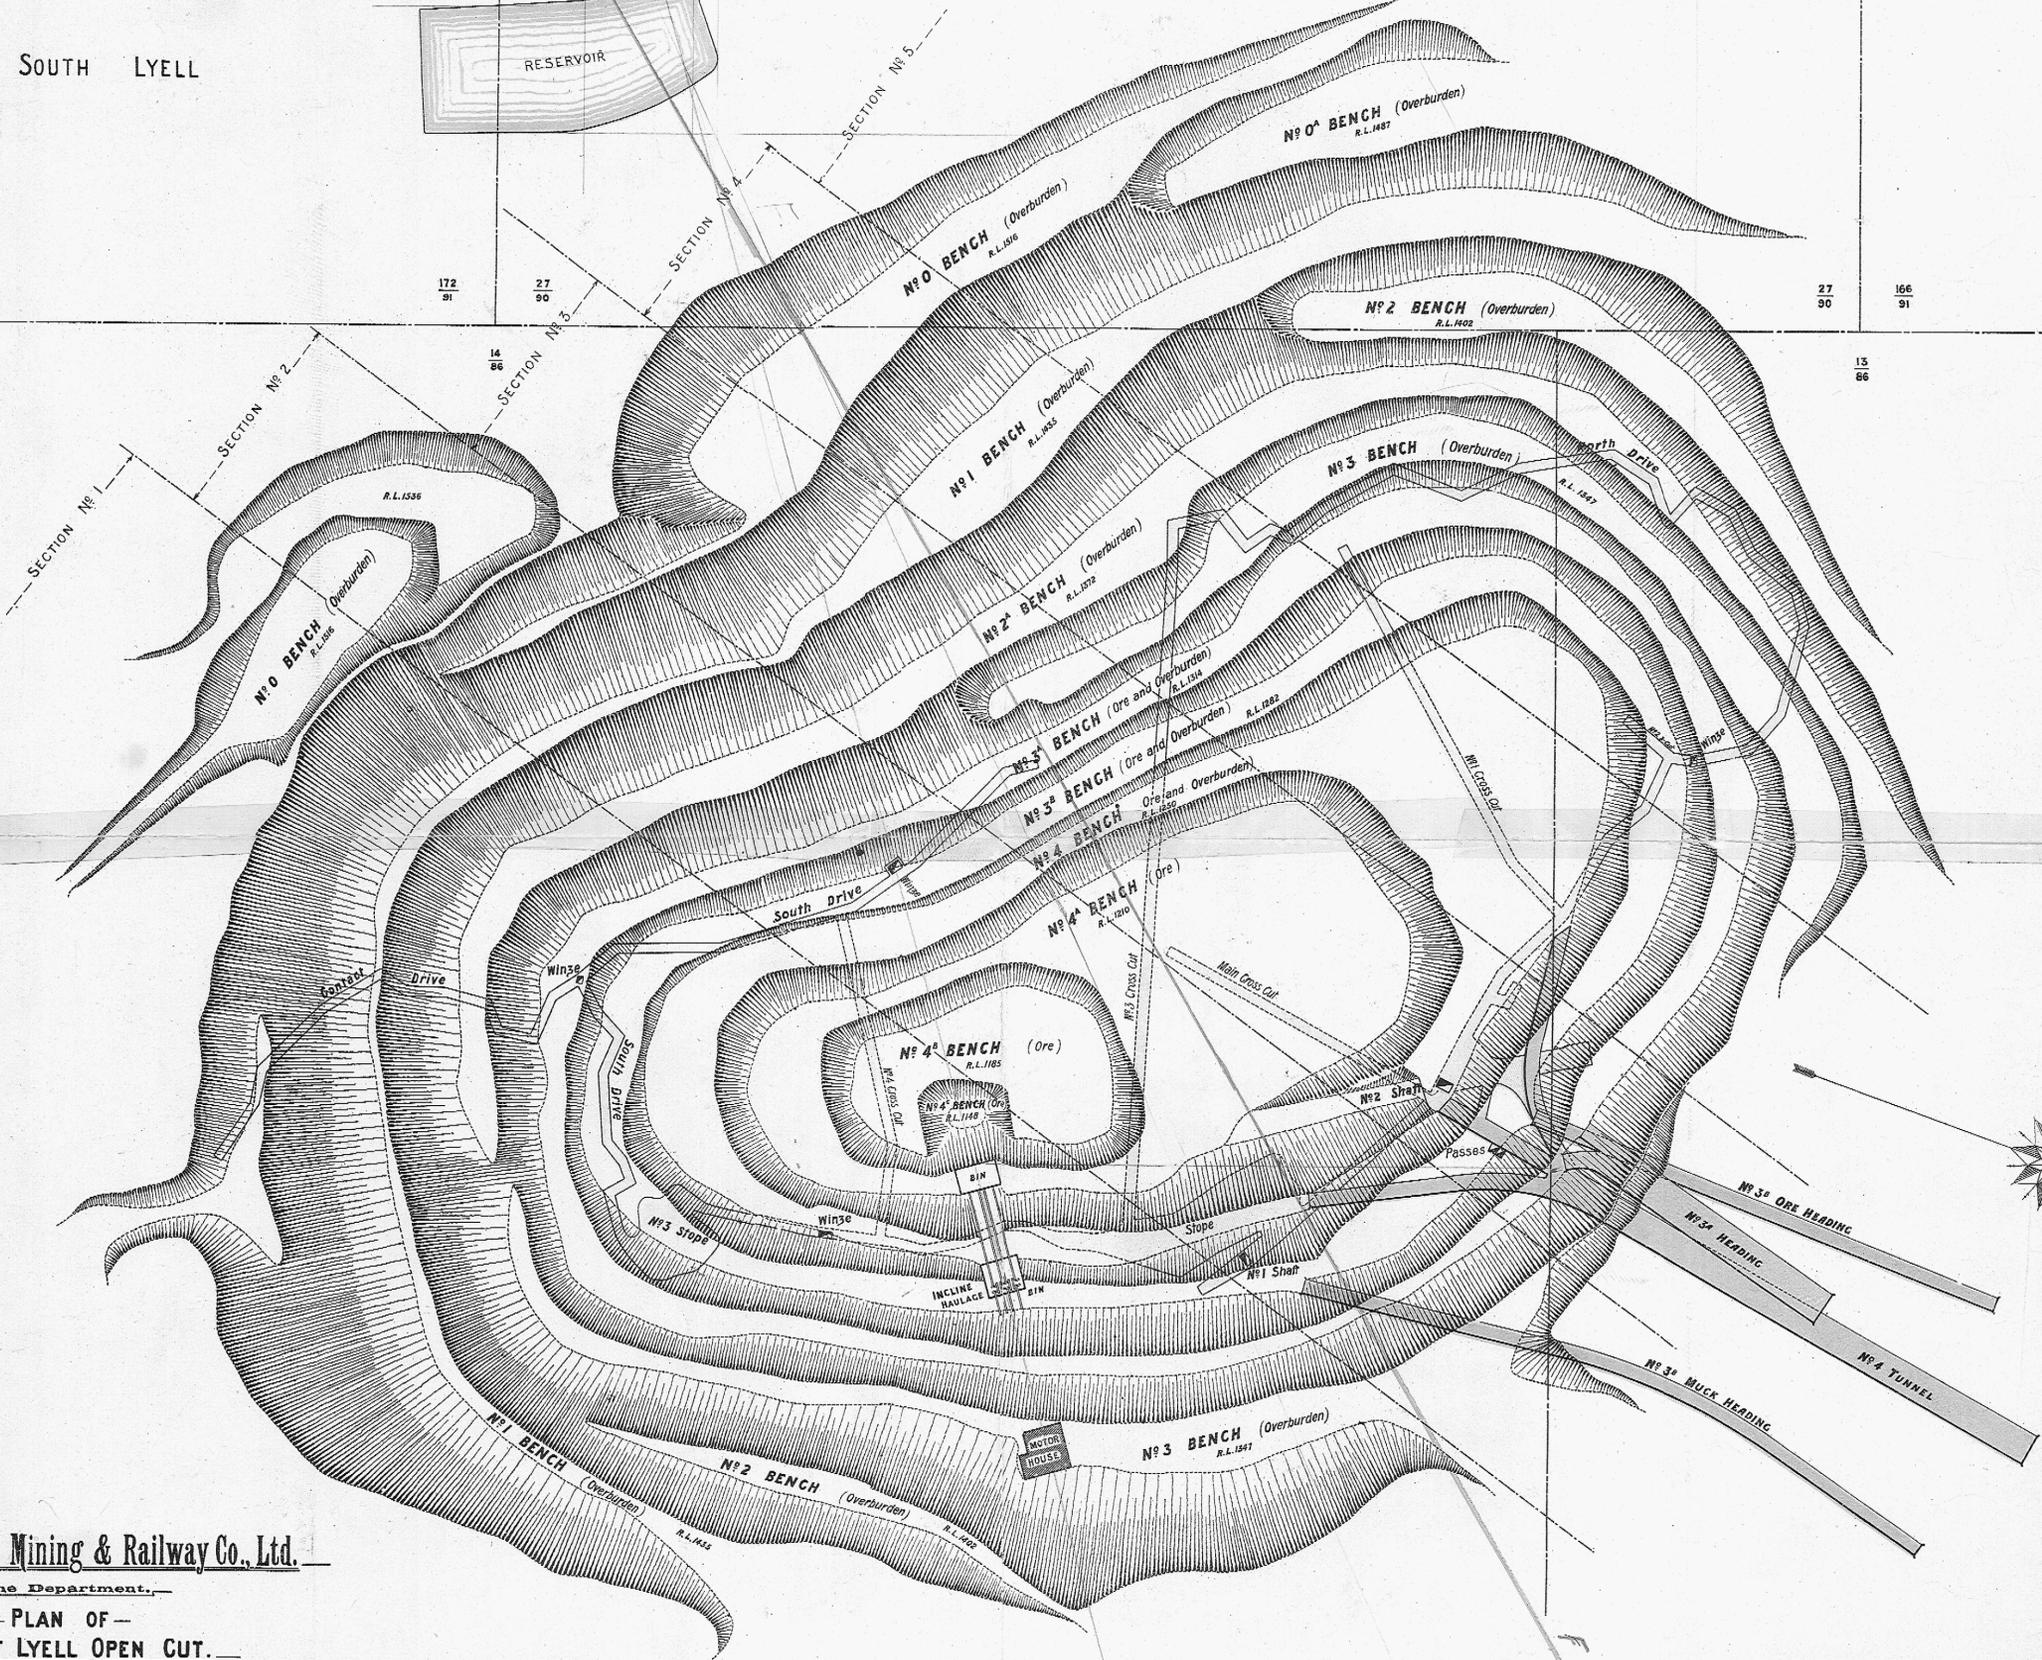


5 cm

SOUTH LYELL

CENTRAL LYELL

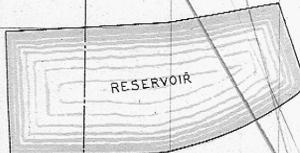

The Mount Lyell Mining & Railway Co., Ltd.

Mine Department.

PLAN OF MOUNT LYELL OPEN CUT.

Brought up to 31st Mar. 1907.

SCALE. 1 INCH = 50 FEET.

NOTE: The Drives show Outline the Ore-body at No 4 Level.