
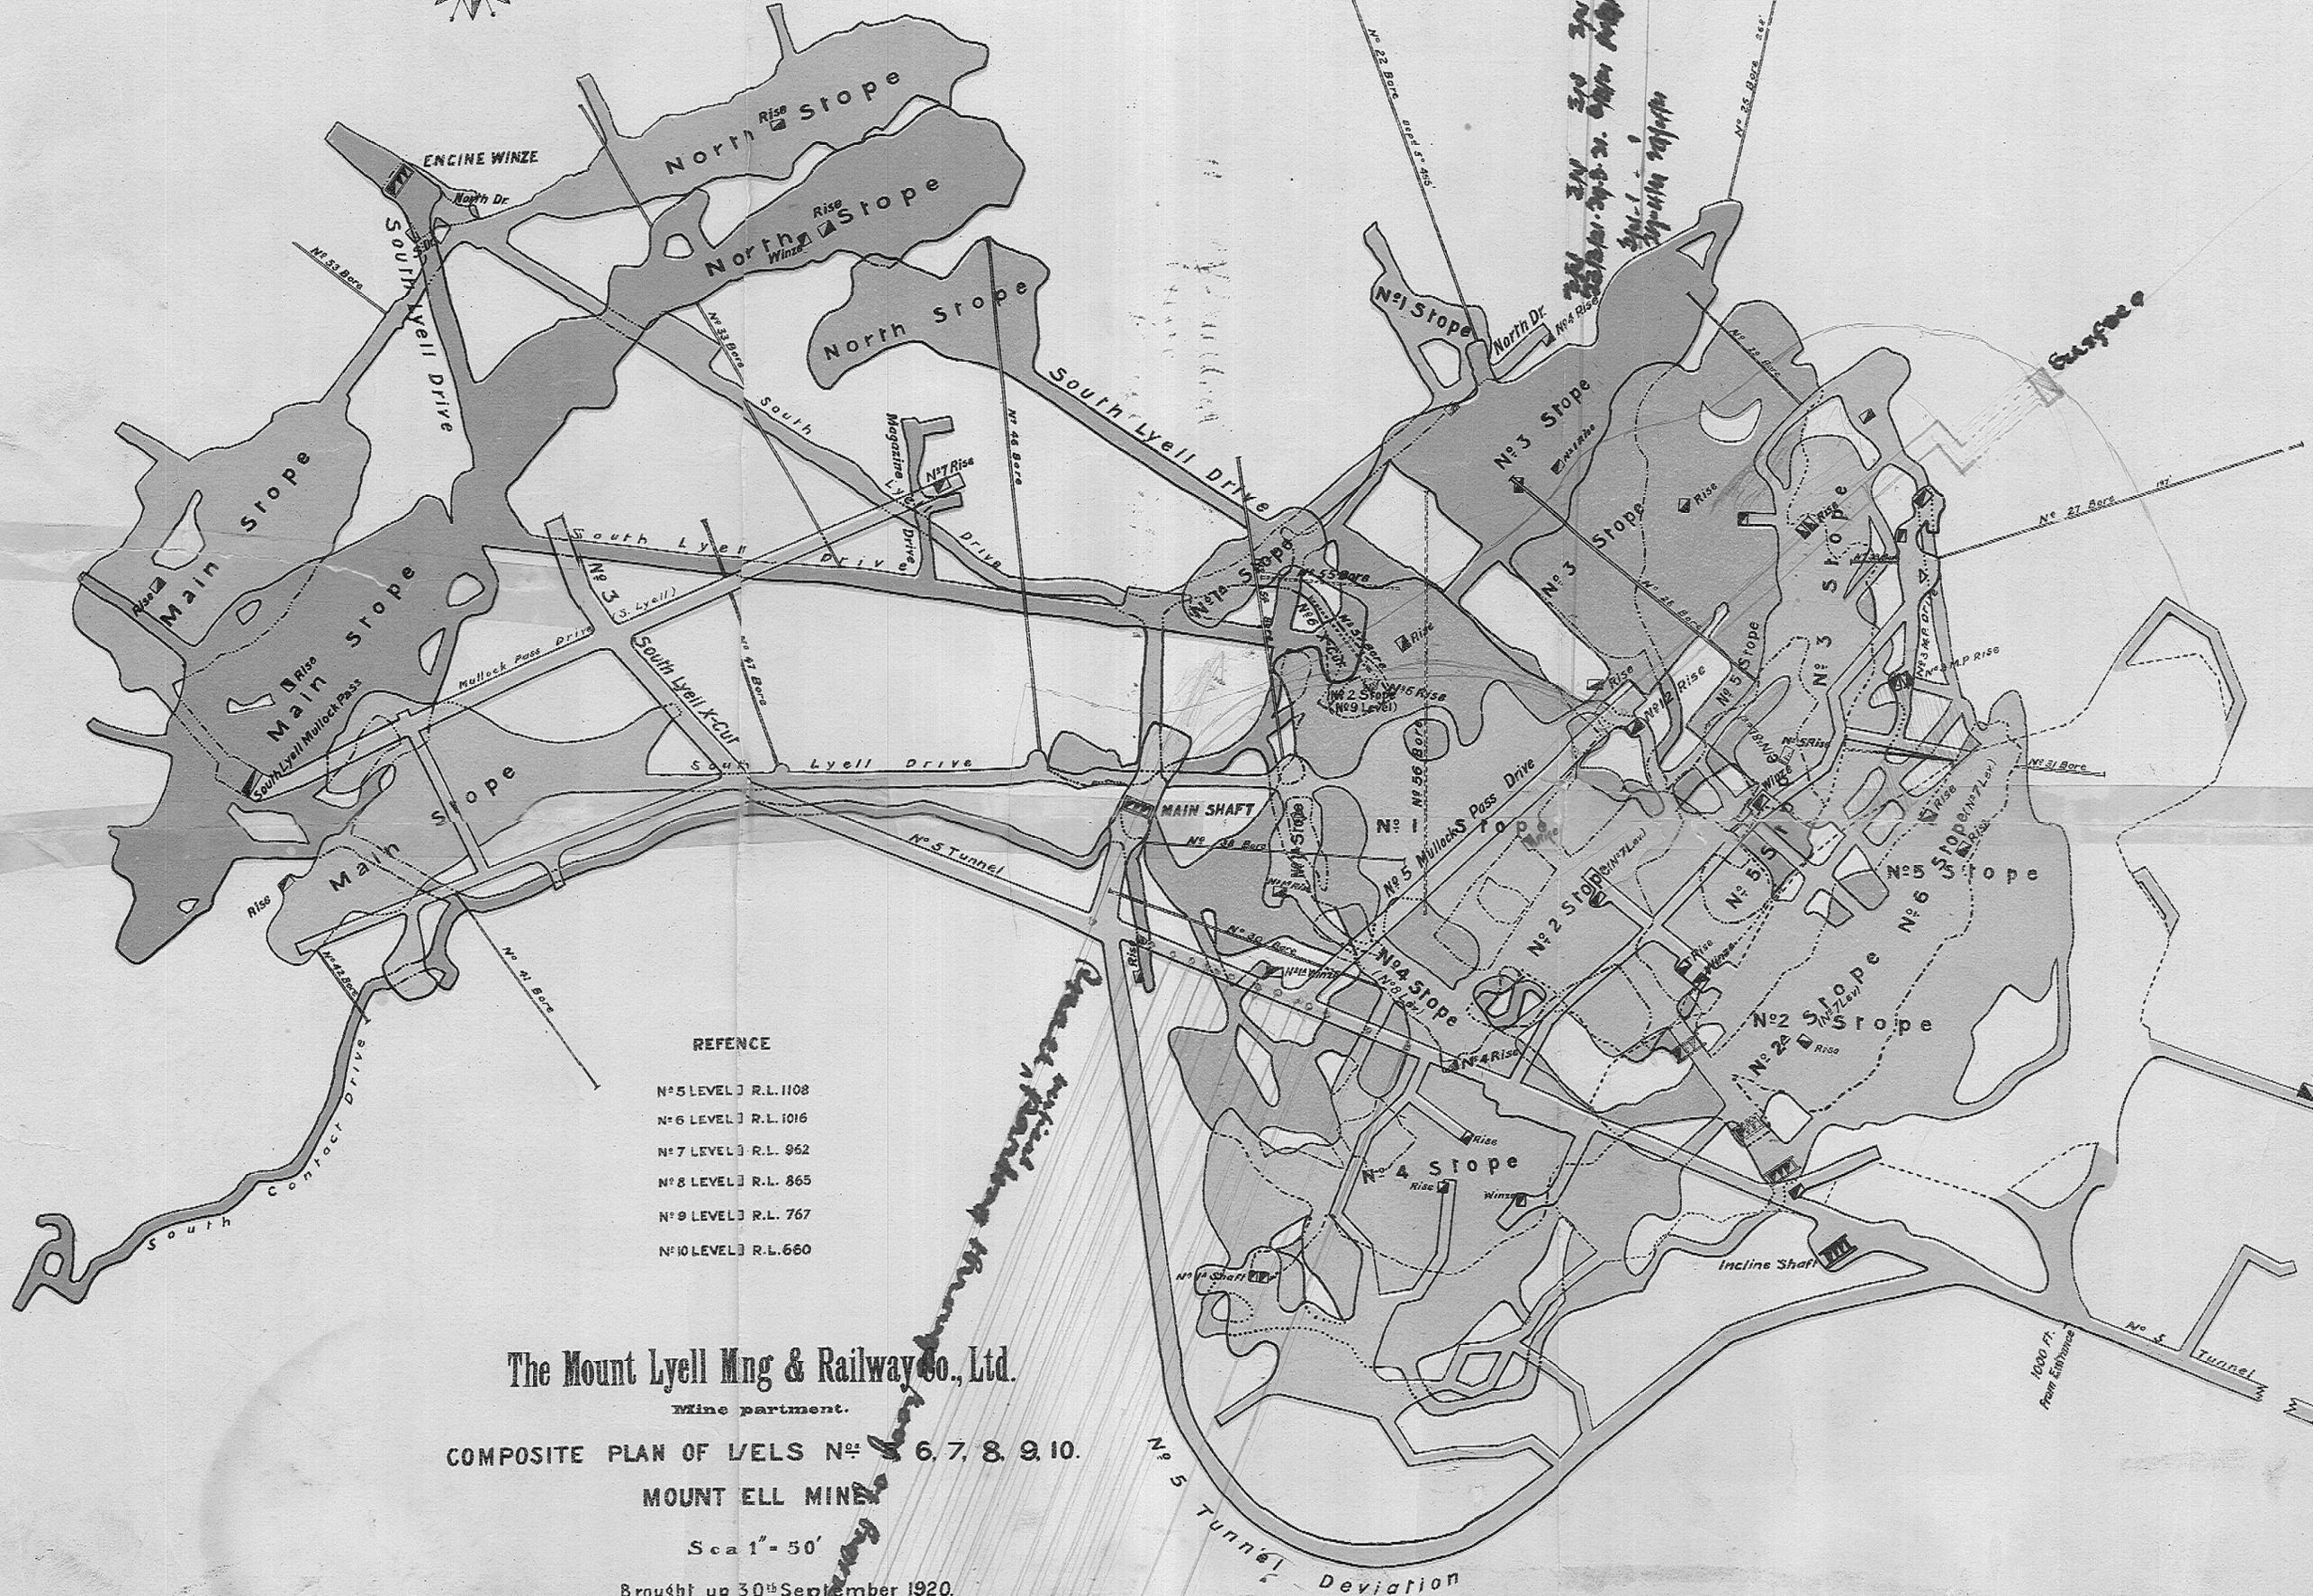


56-03

5 cm

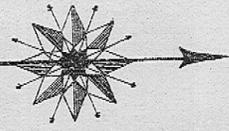

REFERENCE

- No. 5 LEVEL R.L. 1108
- No. 6 LEVEL R.L. 1016
- No. 7 LEVEL R.L. 962
- No. 8 LEVEL R.L. 865
- No. 9 LEVEL R.L. 767
- No. 10 LEVEL R.L. 660

The Mount Lyell Mng & Railway Co., Ltd.

Mine partment.

COMPOSITE PLAN OF LEVELS No. 6, 7, 8, 9, 10.
MOUNT ELL MINE

Scale 1" = 50'

Brought up 30th September 1920.

Robt. Steicht
E.M.