




No 1 Level

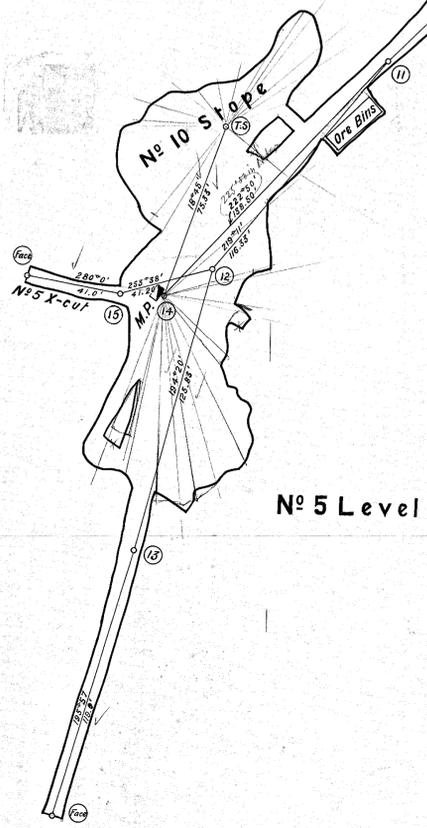

No 5 Level

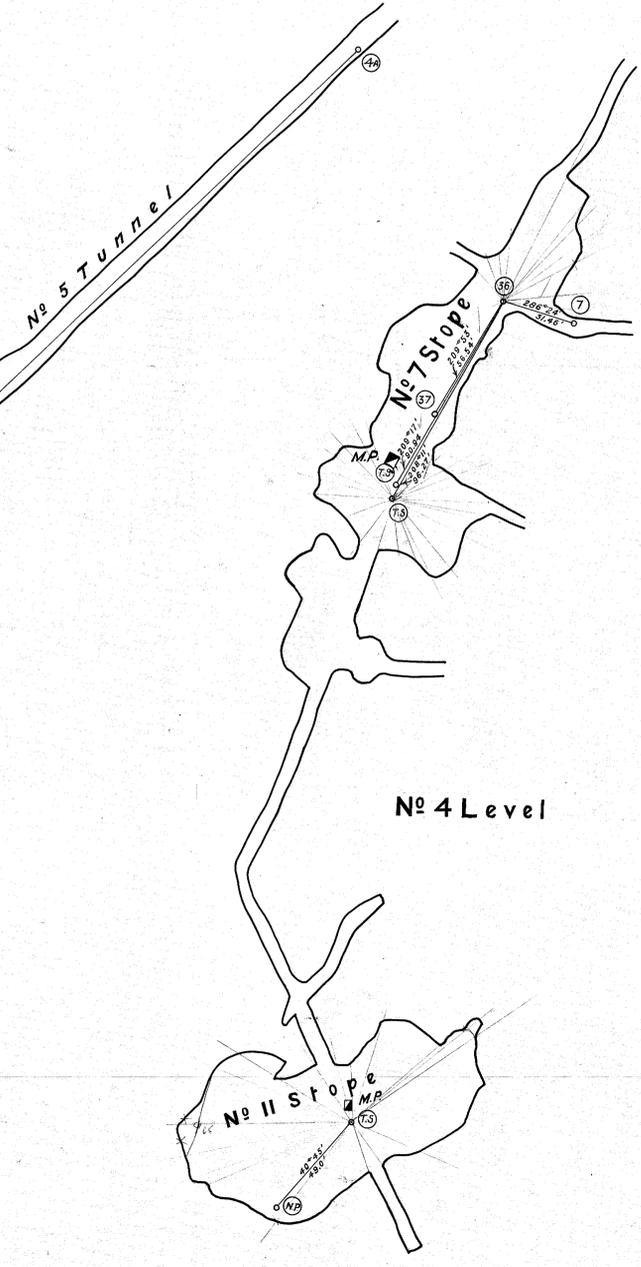

No 4 Level

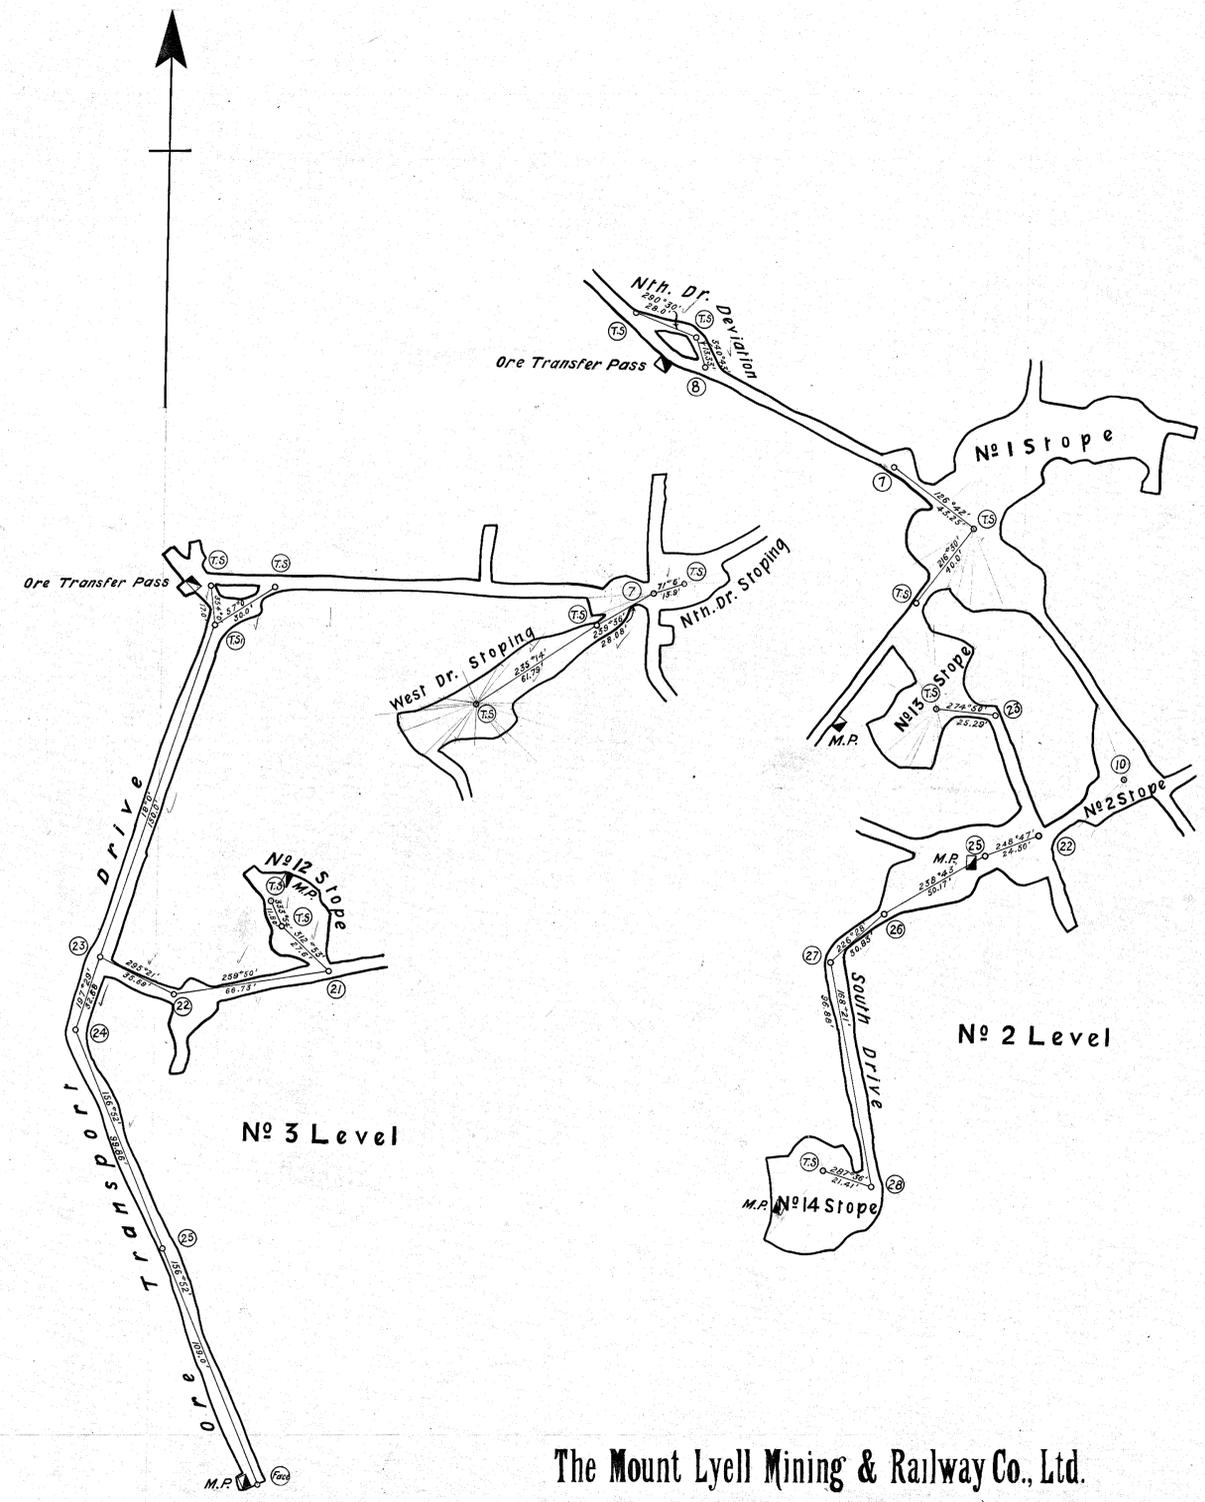

No 3 Level

No 2 Level

The Mount Lyell Mining & Railway Co., Ltd.

Mine Department.
 LYELL COMSTOCK MINE
 UNDERGROUND WORKINGS 1929
 SCALE : 1 INCH = 30 FEET

R. J. Murray General Manager
S. J. Schuchman Mine Superintendent