


56-08

56-08

5 cm

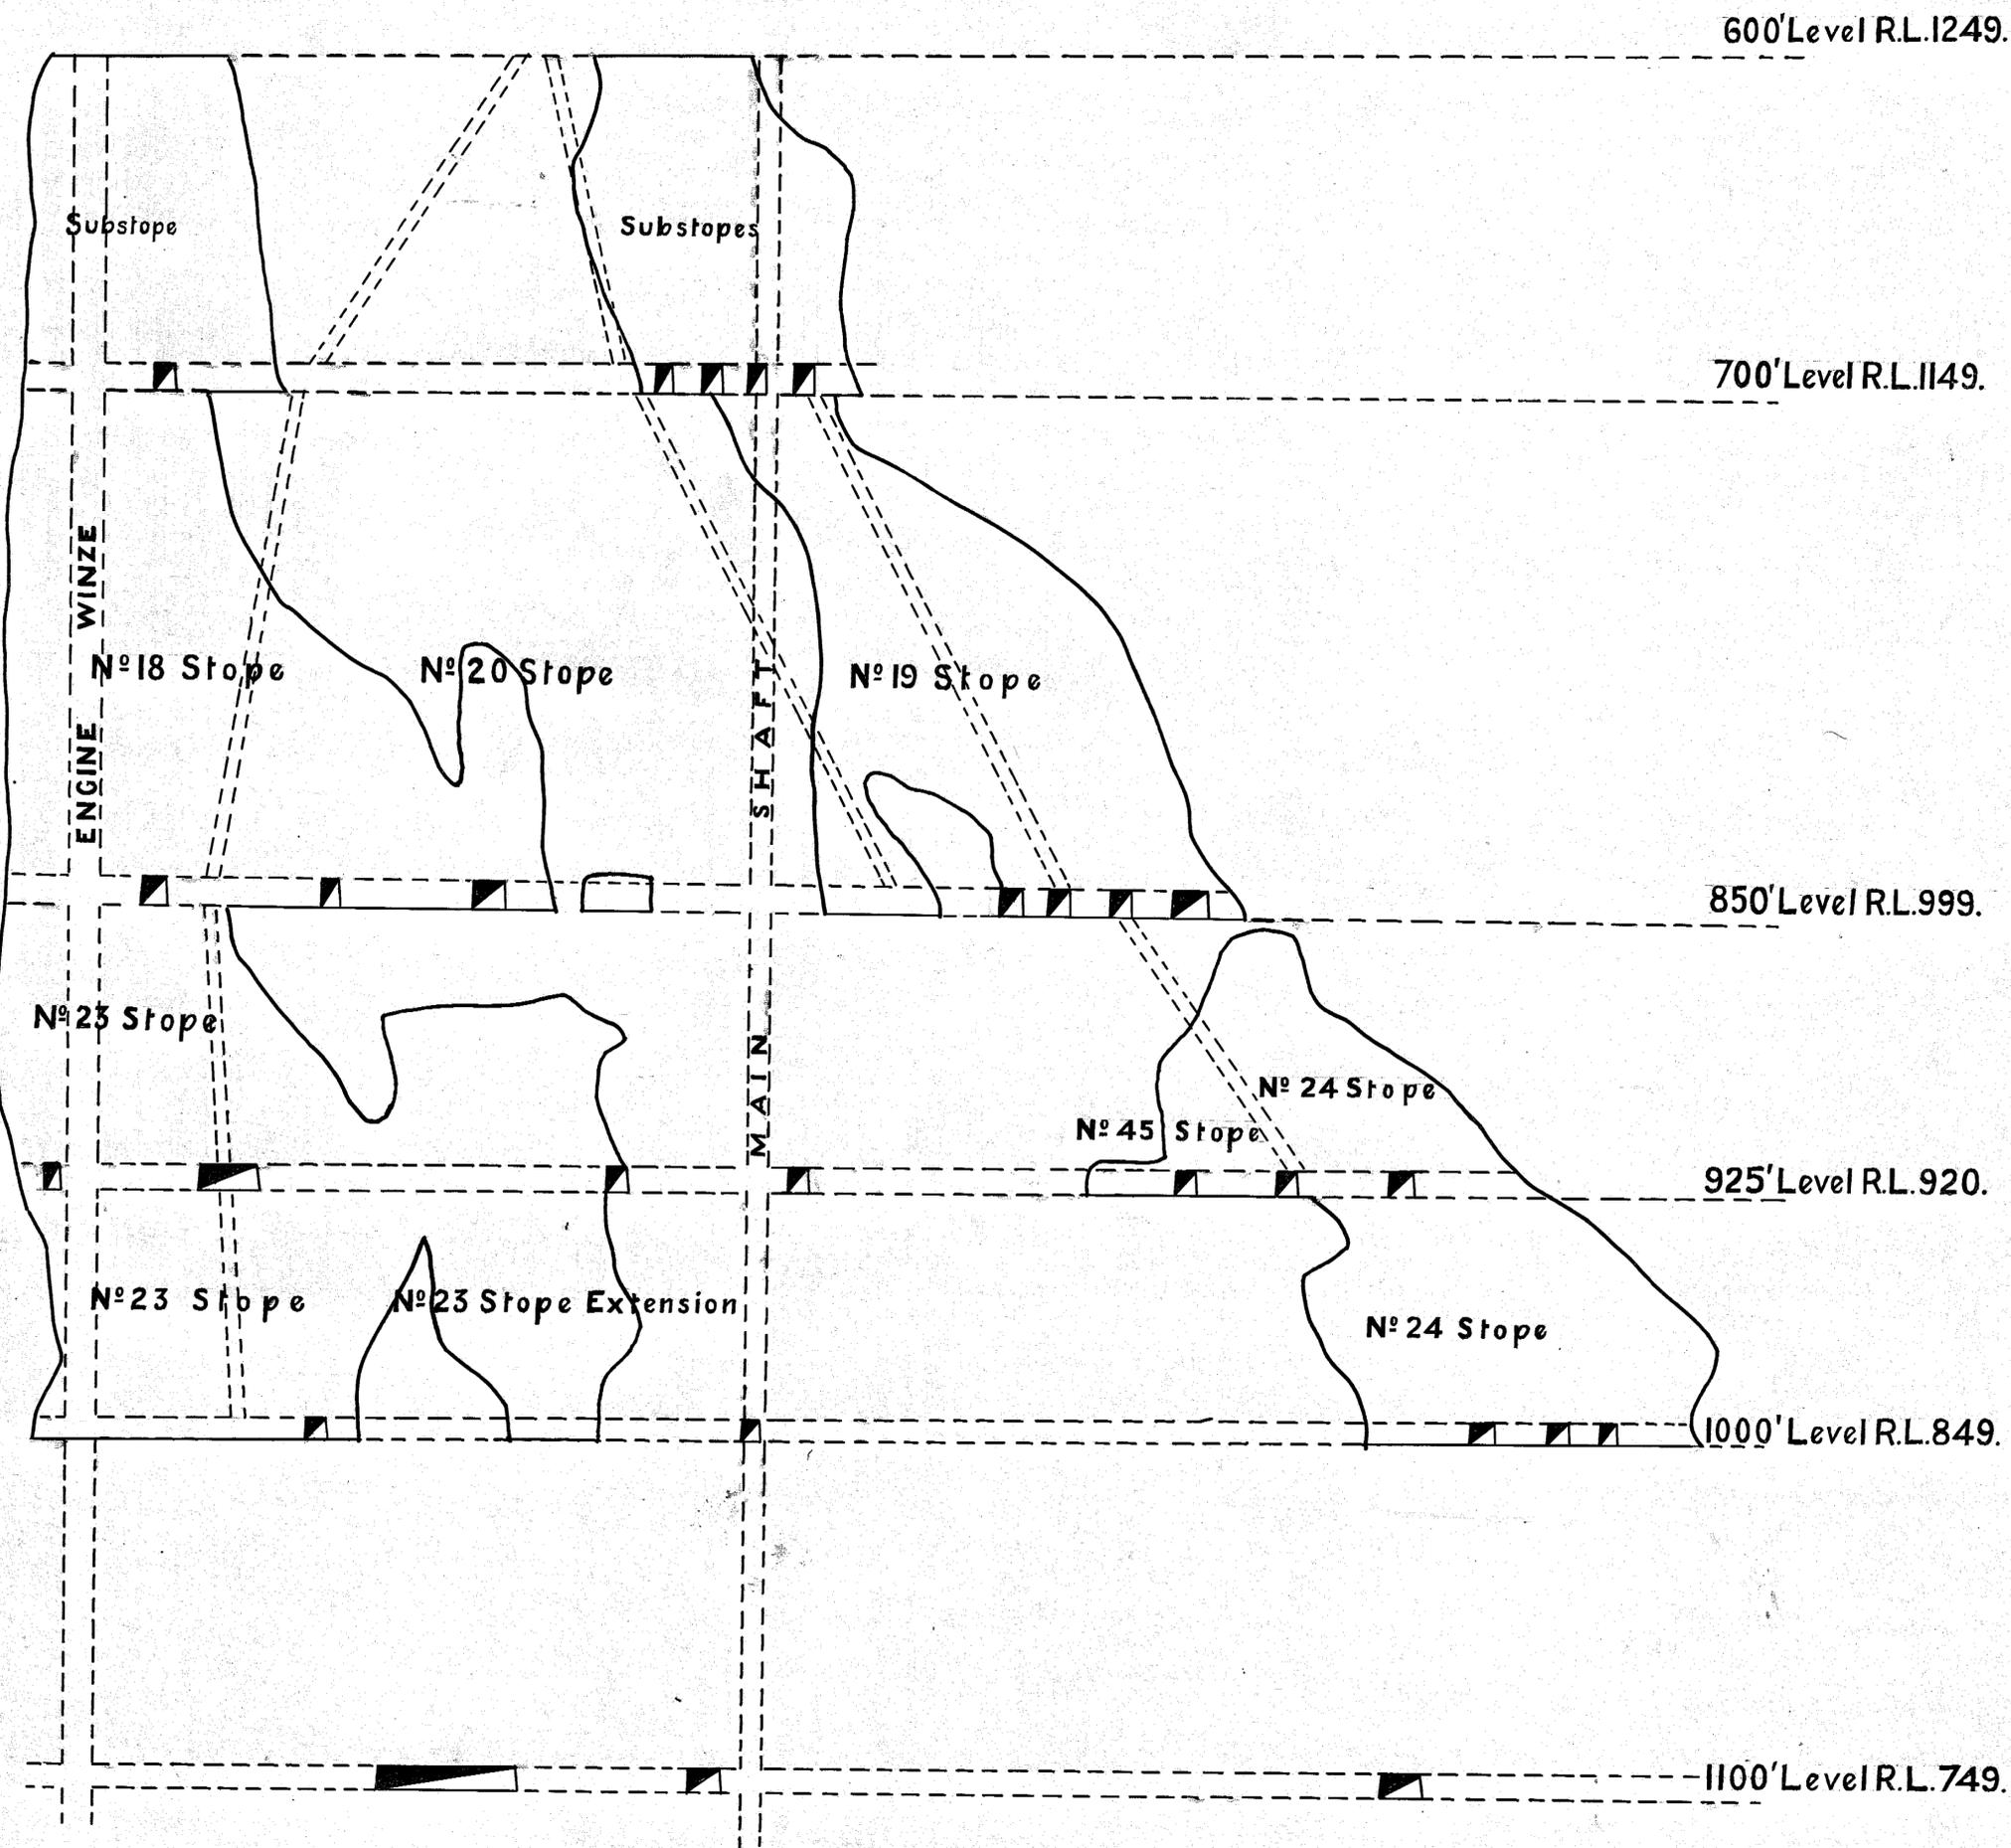

The Mount Lyell Mining & Railway Co., Ltd.

Mine Department.

NORTH LYELL MINE

Section on Line BB looking North

Brought up to Dec. 31st 1929

Scale 1" = 30'

R. H. Murray General Manager
E. H. Jackson Mine Superintendent