


55-10



ROYAL THARSIS MINE
1100' Level

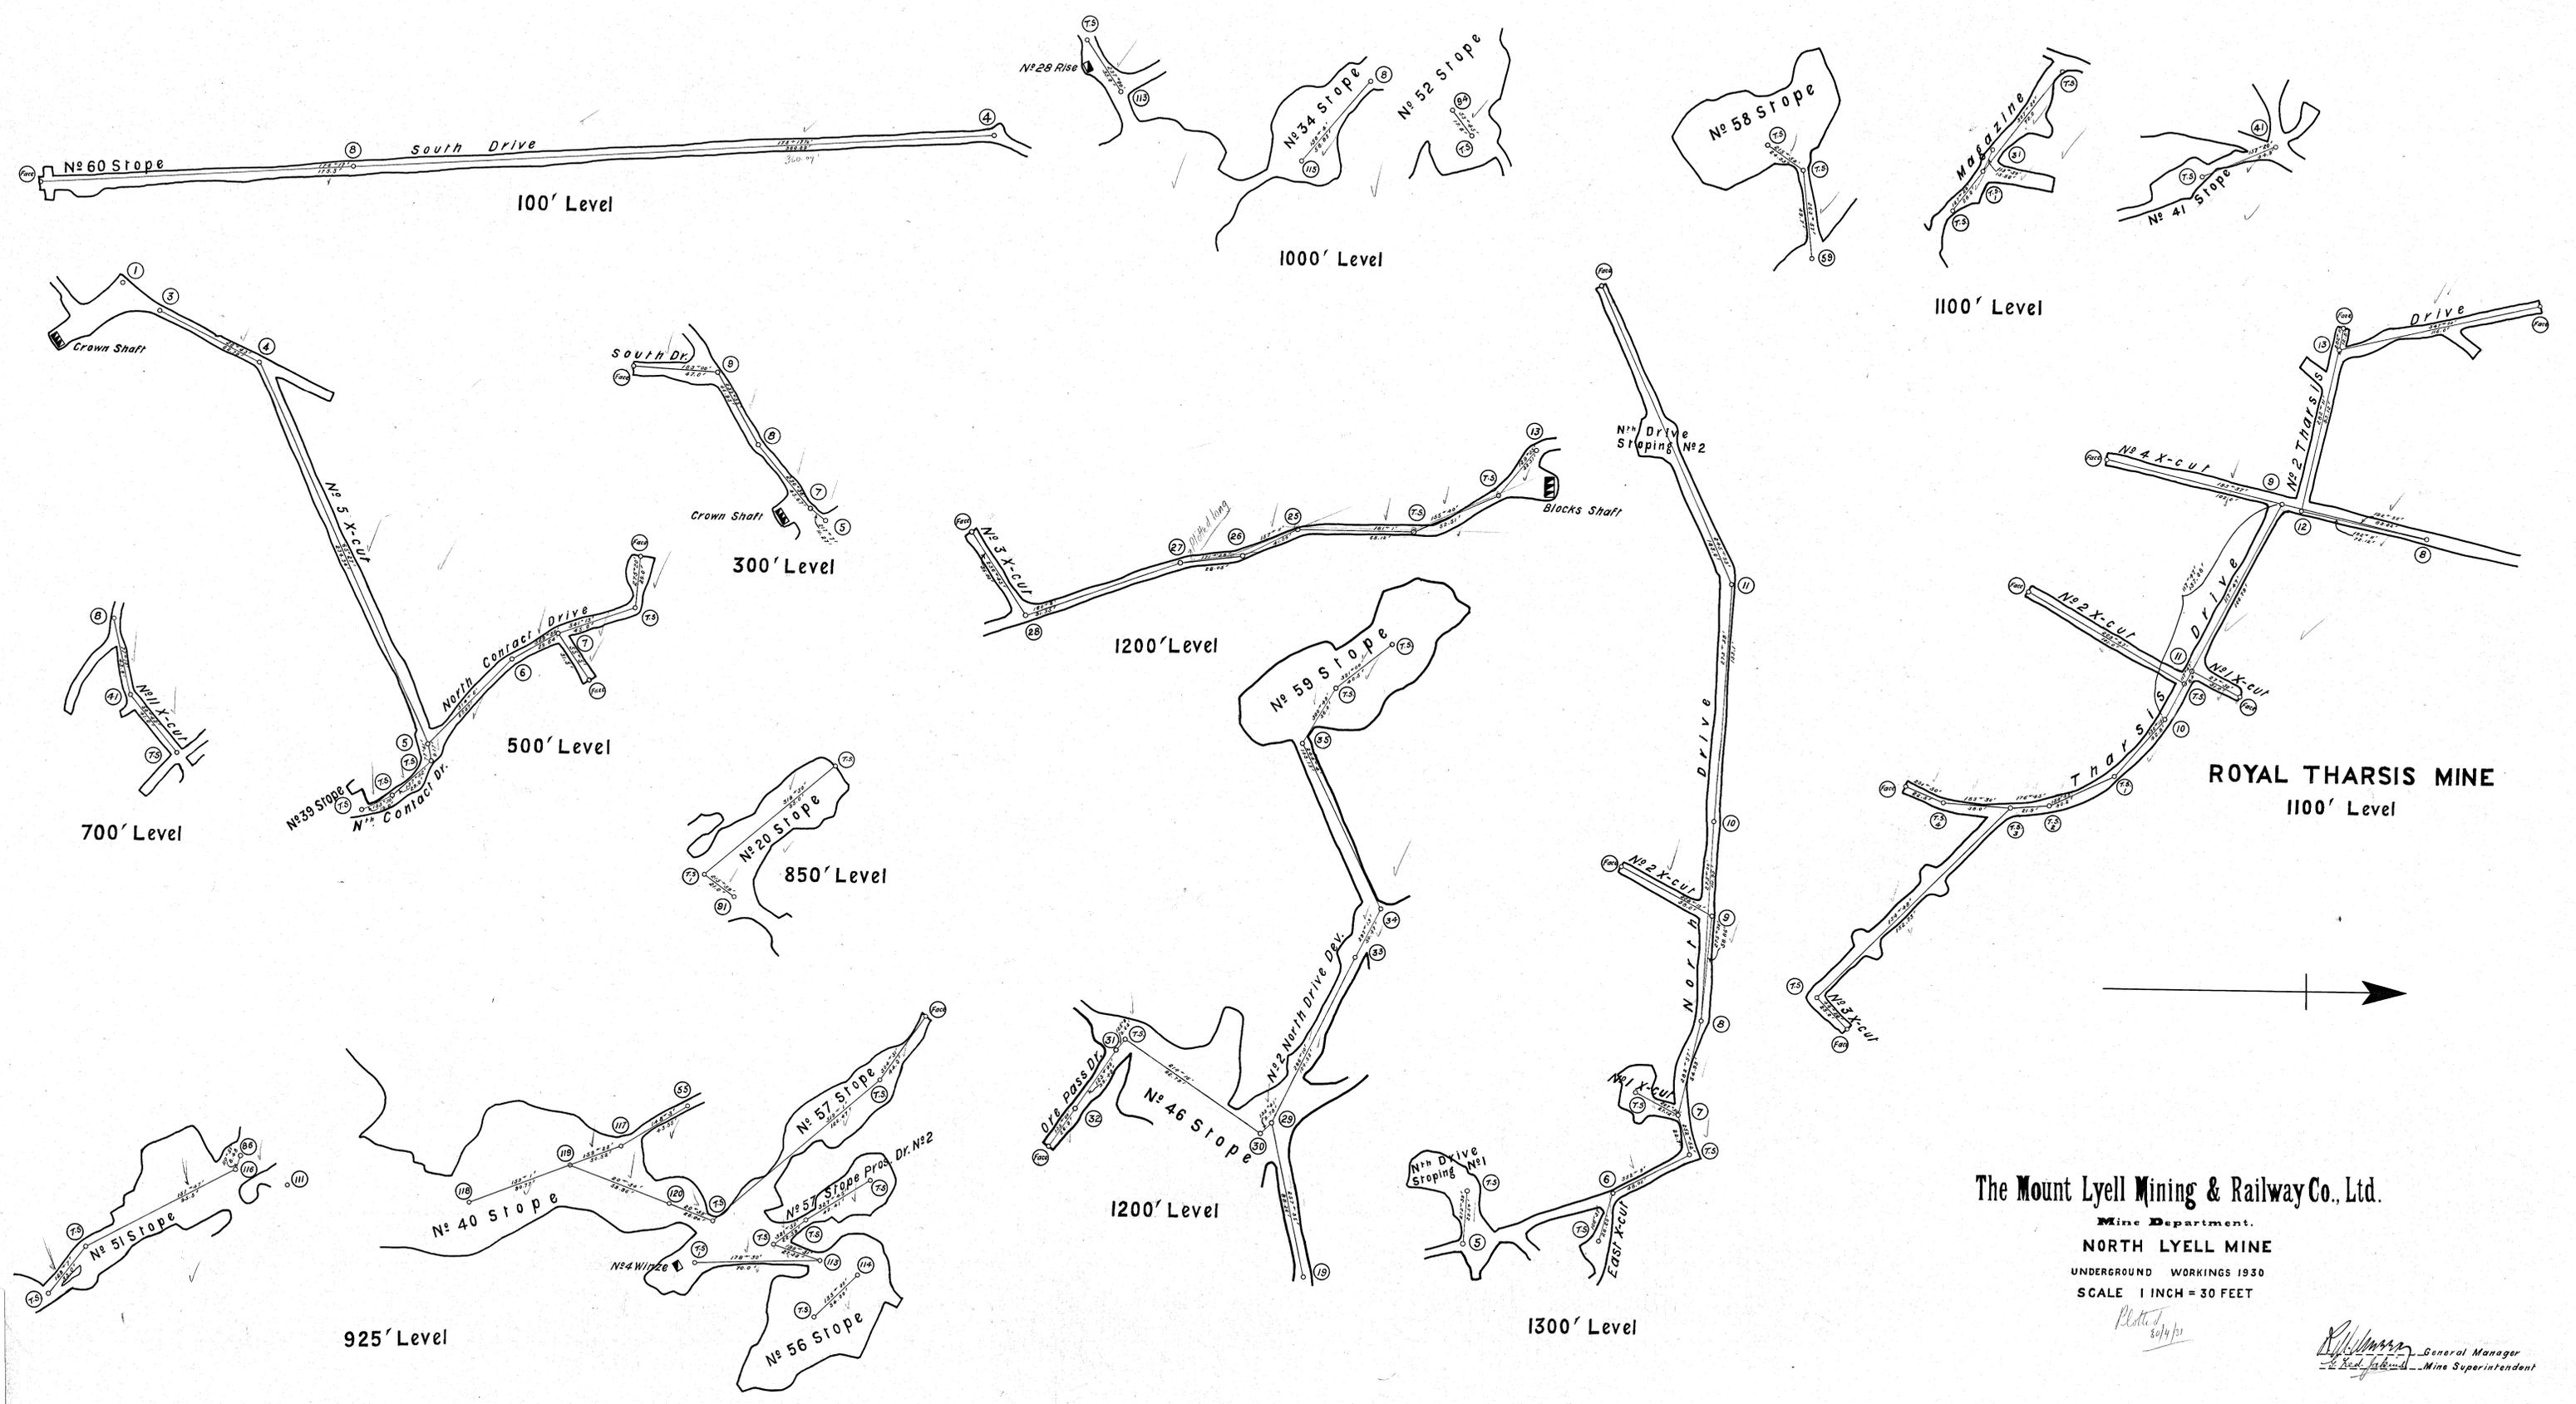

The Mount Lyell Mining & Railway Co., Ltd.

Mine Department.
NORTH LYELL MINE
UNDERGROUND WORKINGS 1930
SCALE 1 INCH = 30 FEET

Plotted 30/4/31

[Signature] General Manager
[Signature] Mine Superintendent



56-10