


5 cm

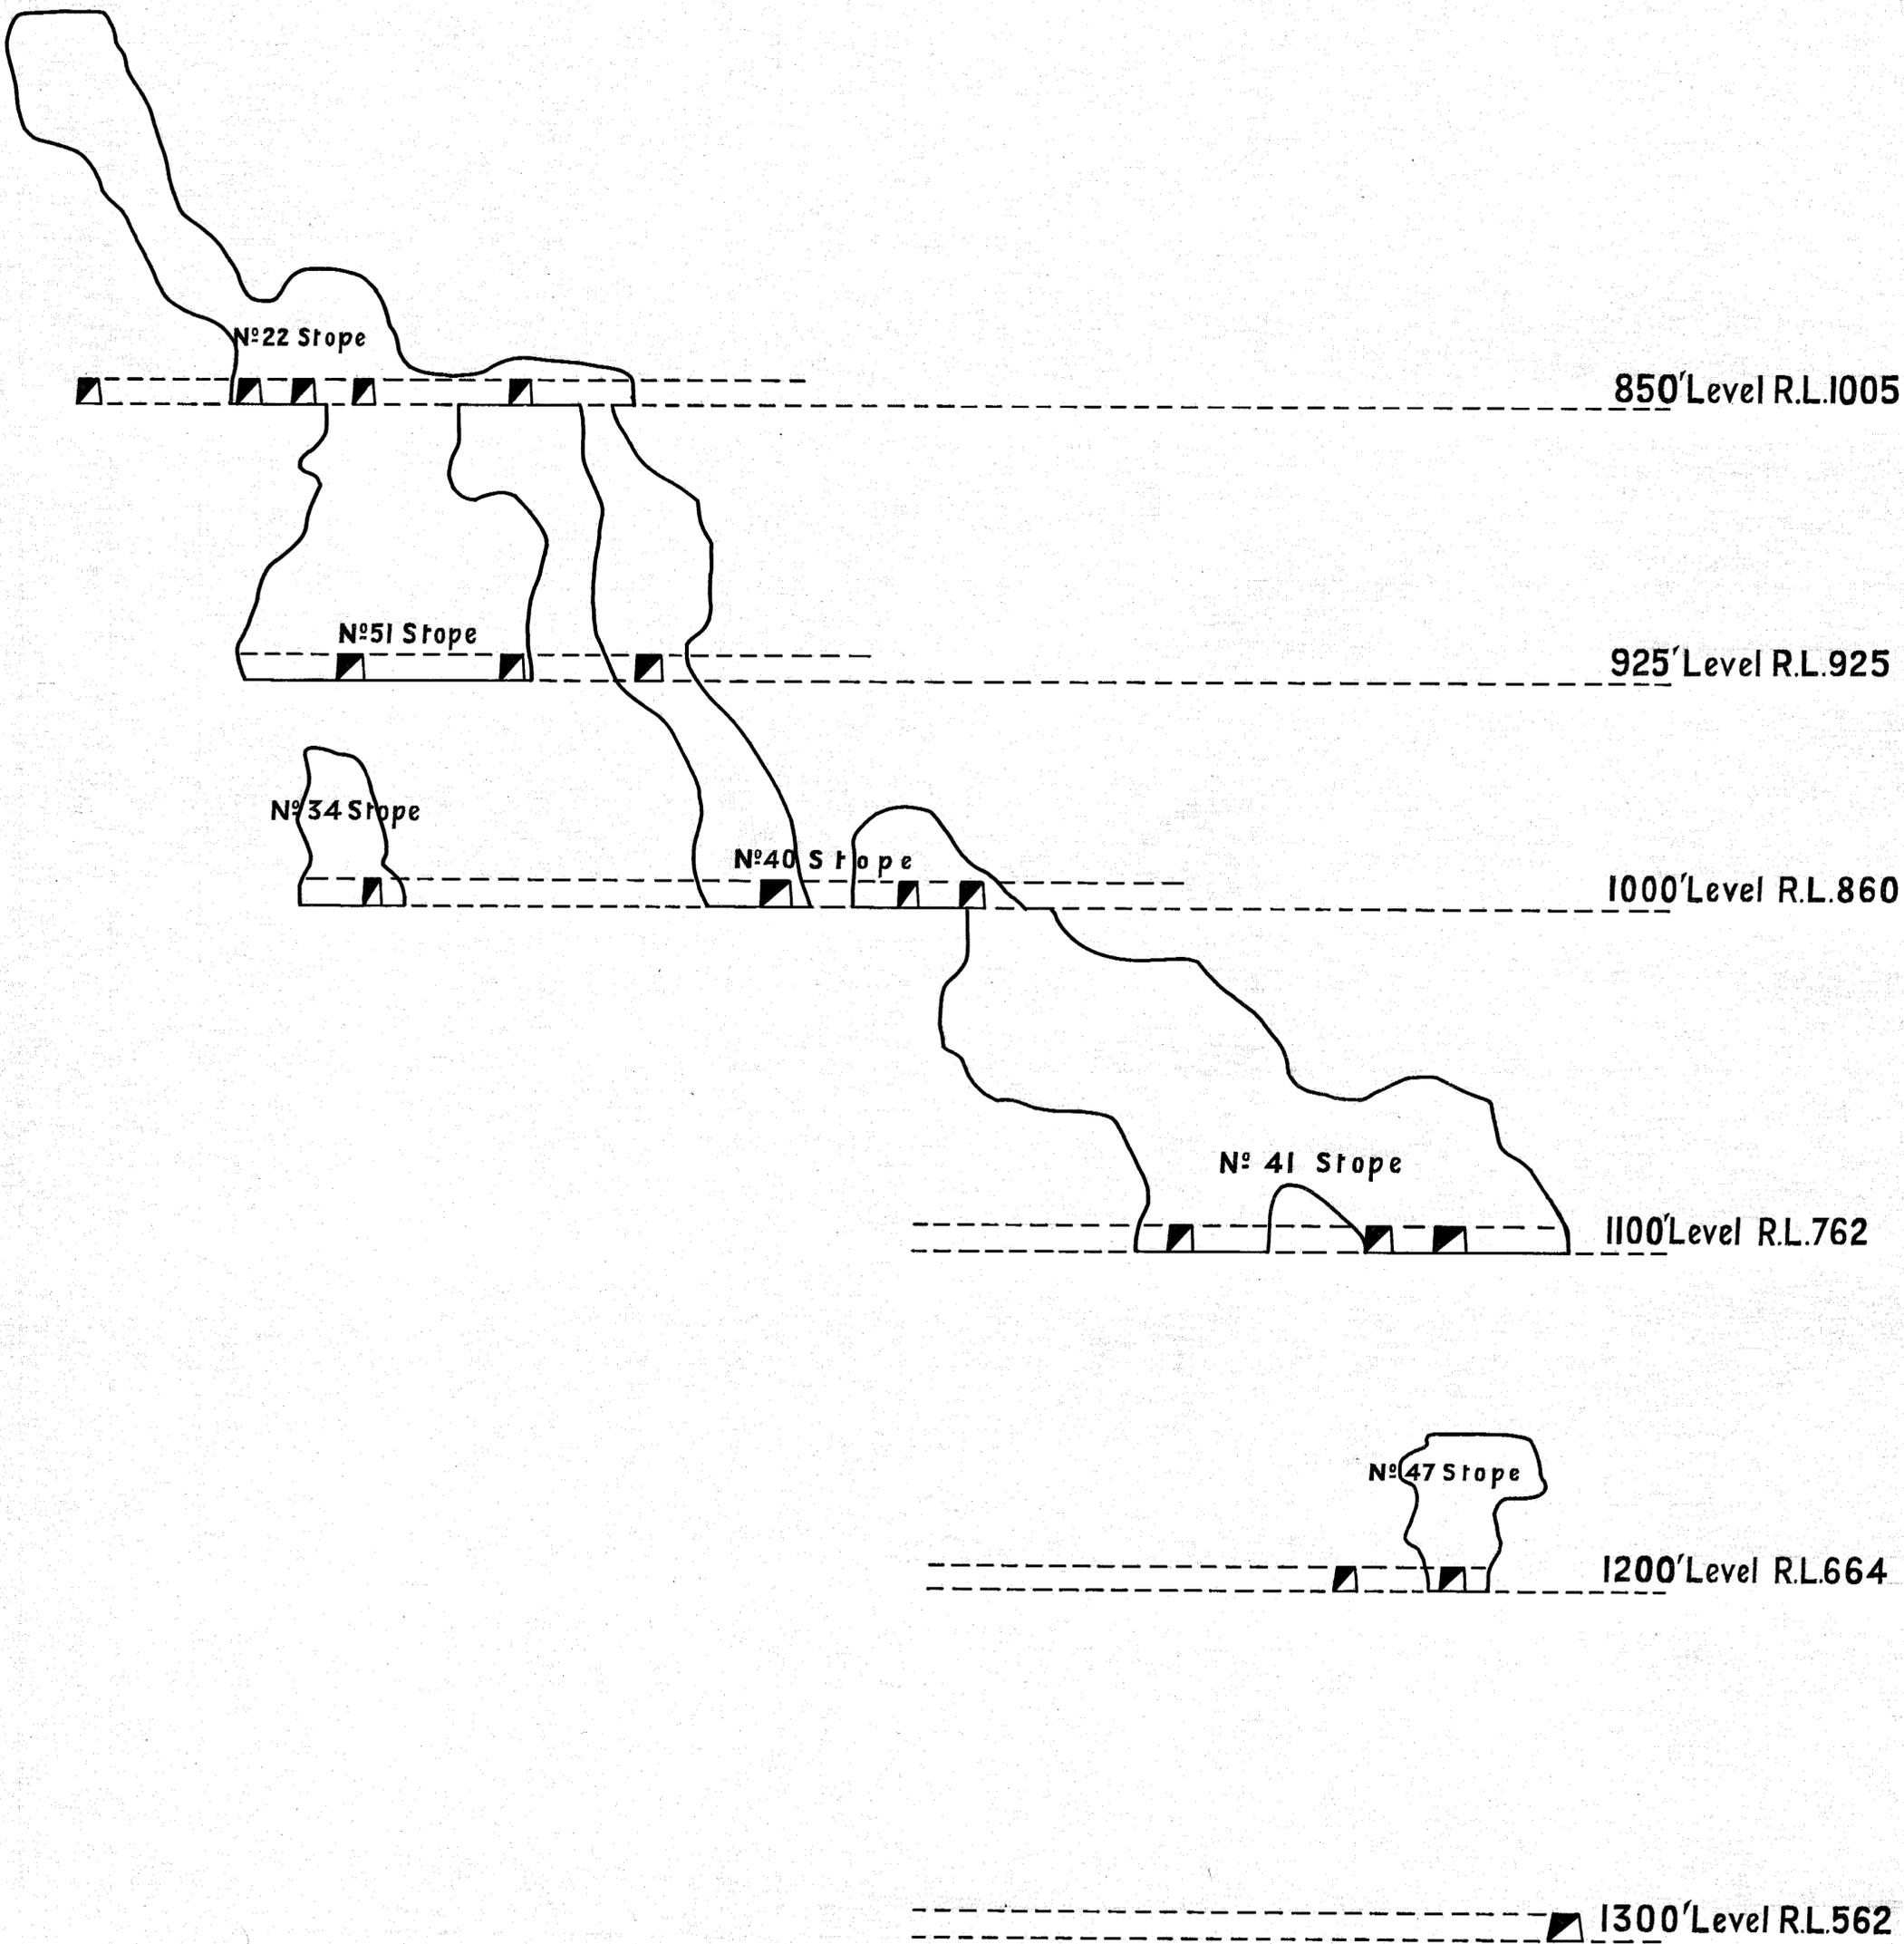

The Mount Lyell Mining & Railway Co., Ltd.

Mine Department

NORTH LYELL MINE

Section on Line DD looking North

Brought up to Dec. 31st 1930

Scale 1" = 30'

R. J. W. ... General Manager
E. Red ... Mine Superintendent