


56-14 100
56-15 LARGE
56-16

56-13

5 cm

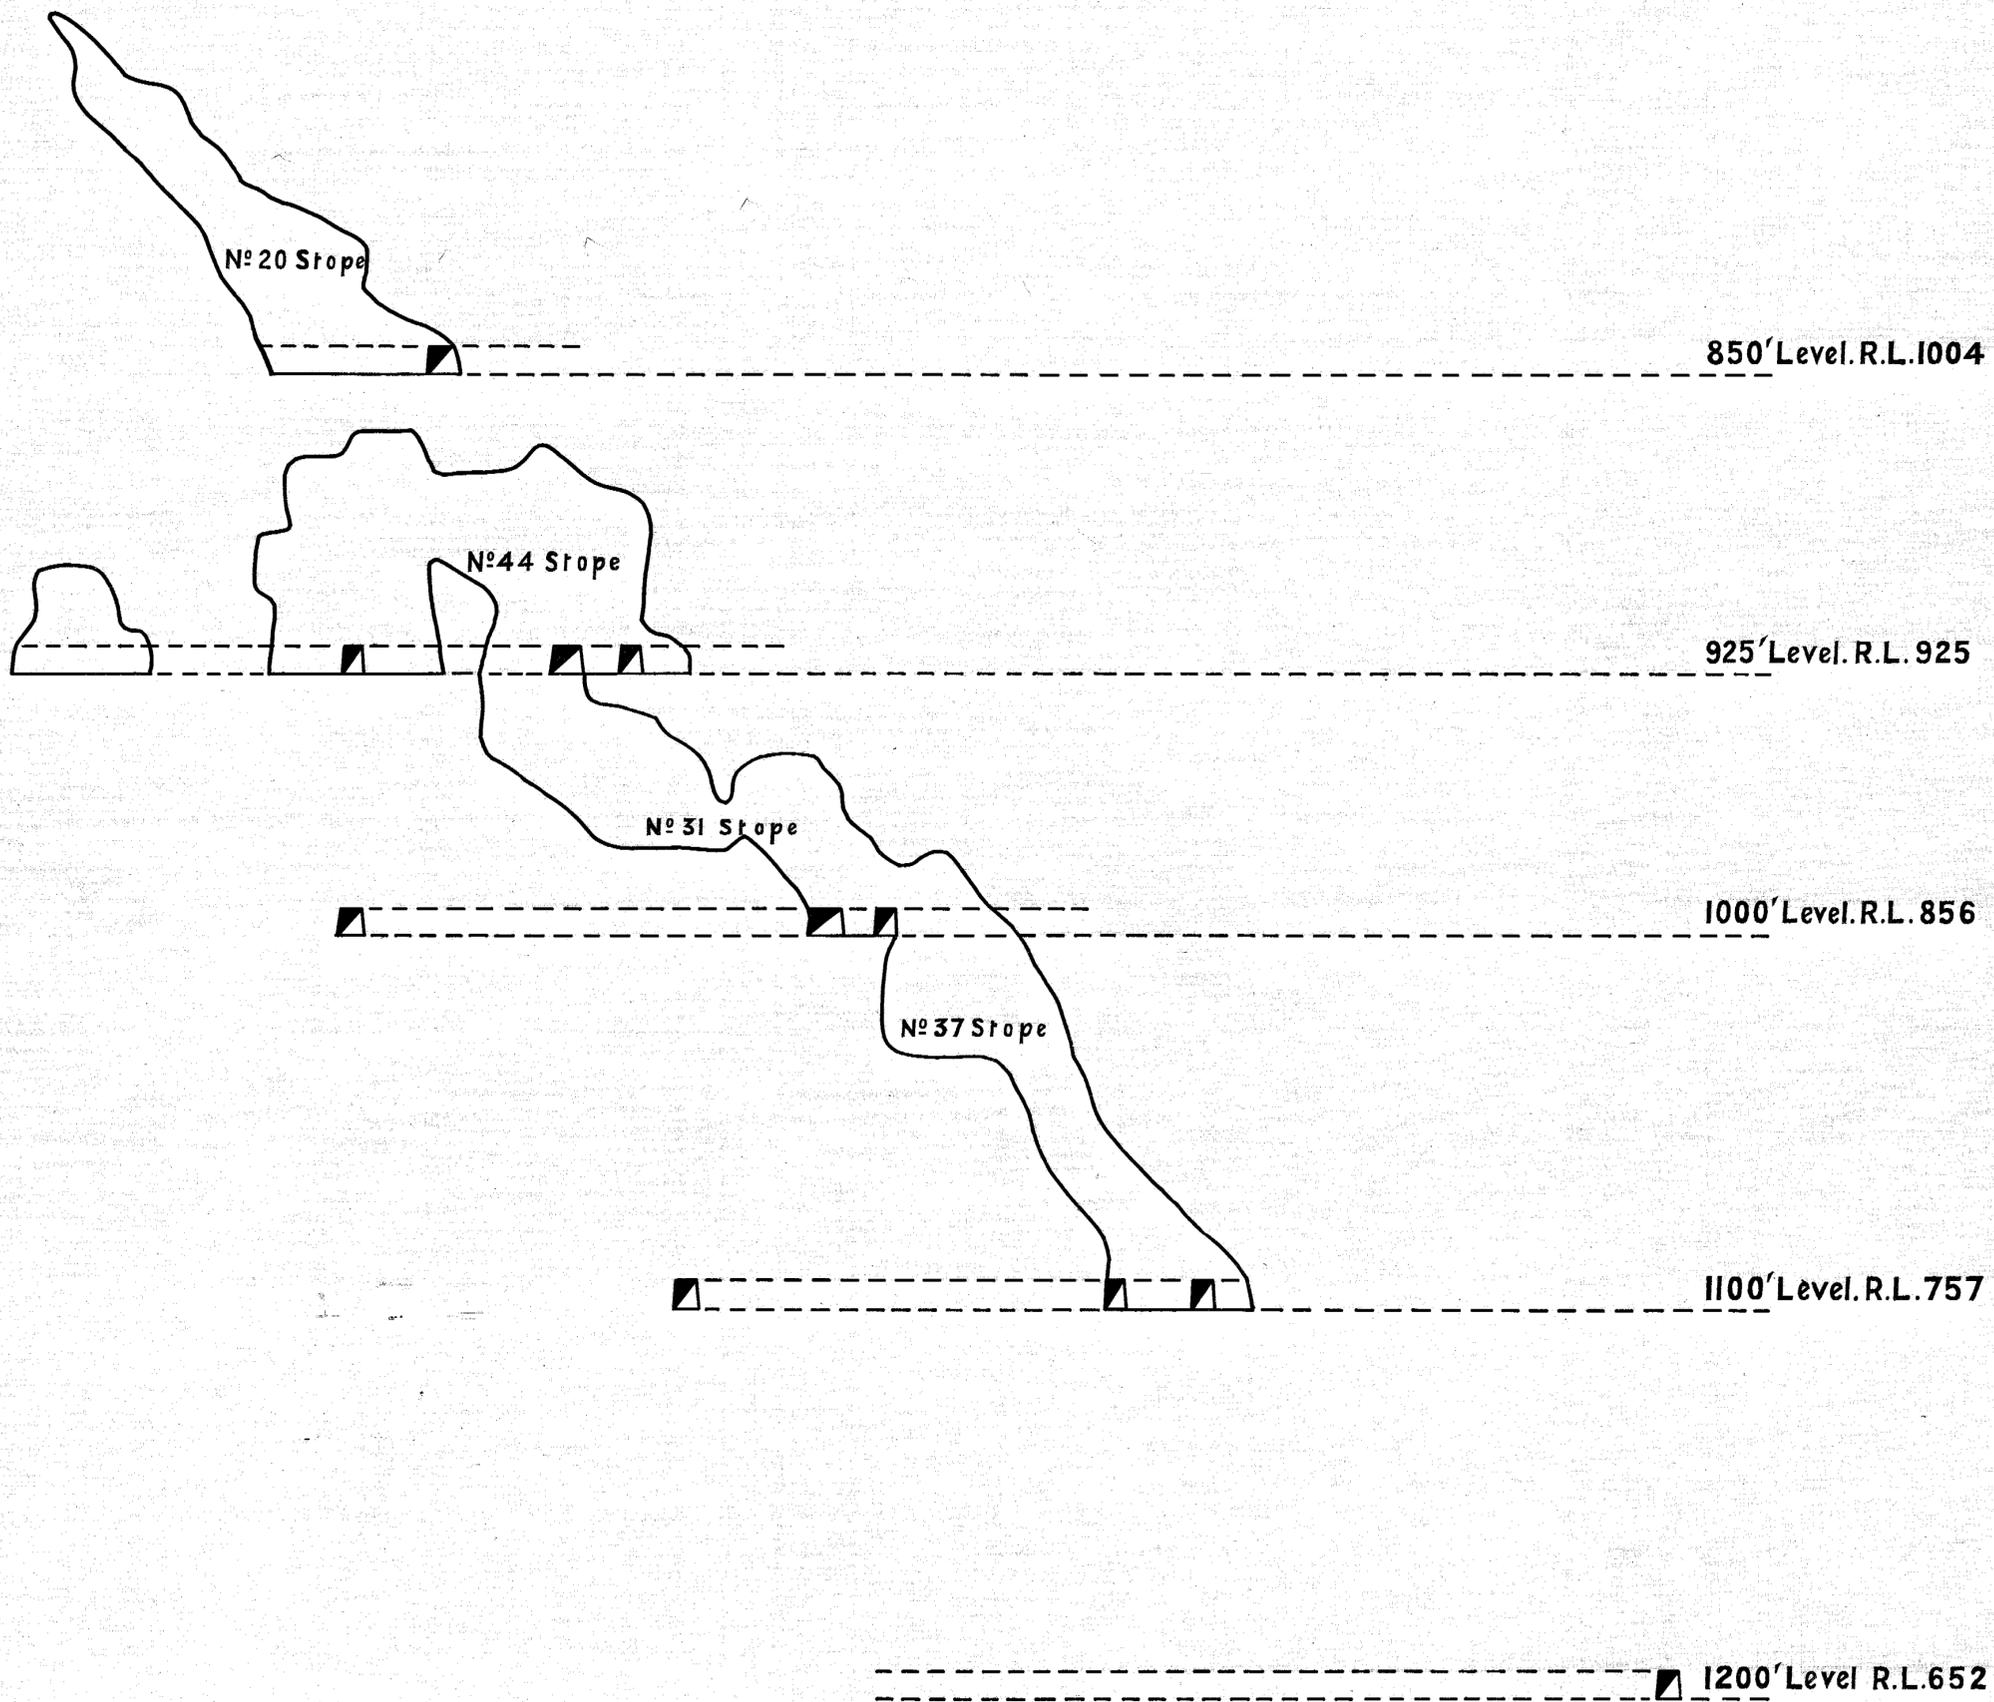

The Mount Lyell Mining & Railway Co., Ltd.

Mine Department.

NORTH LYELL MINE

Section on Line CC looking North

Brought up to Dec. 31ST 1930

Scale 1" = 30'

R. H. W. W. W. General Manager
E. Red. Jakus Mine Superintendent