
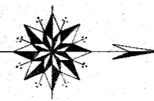


5 cm

56-18

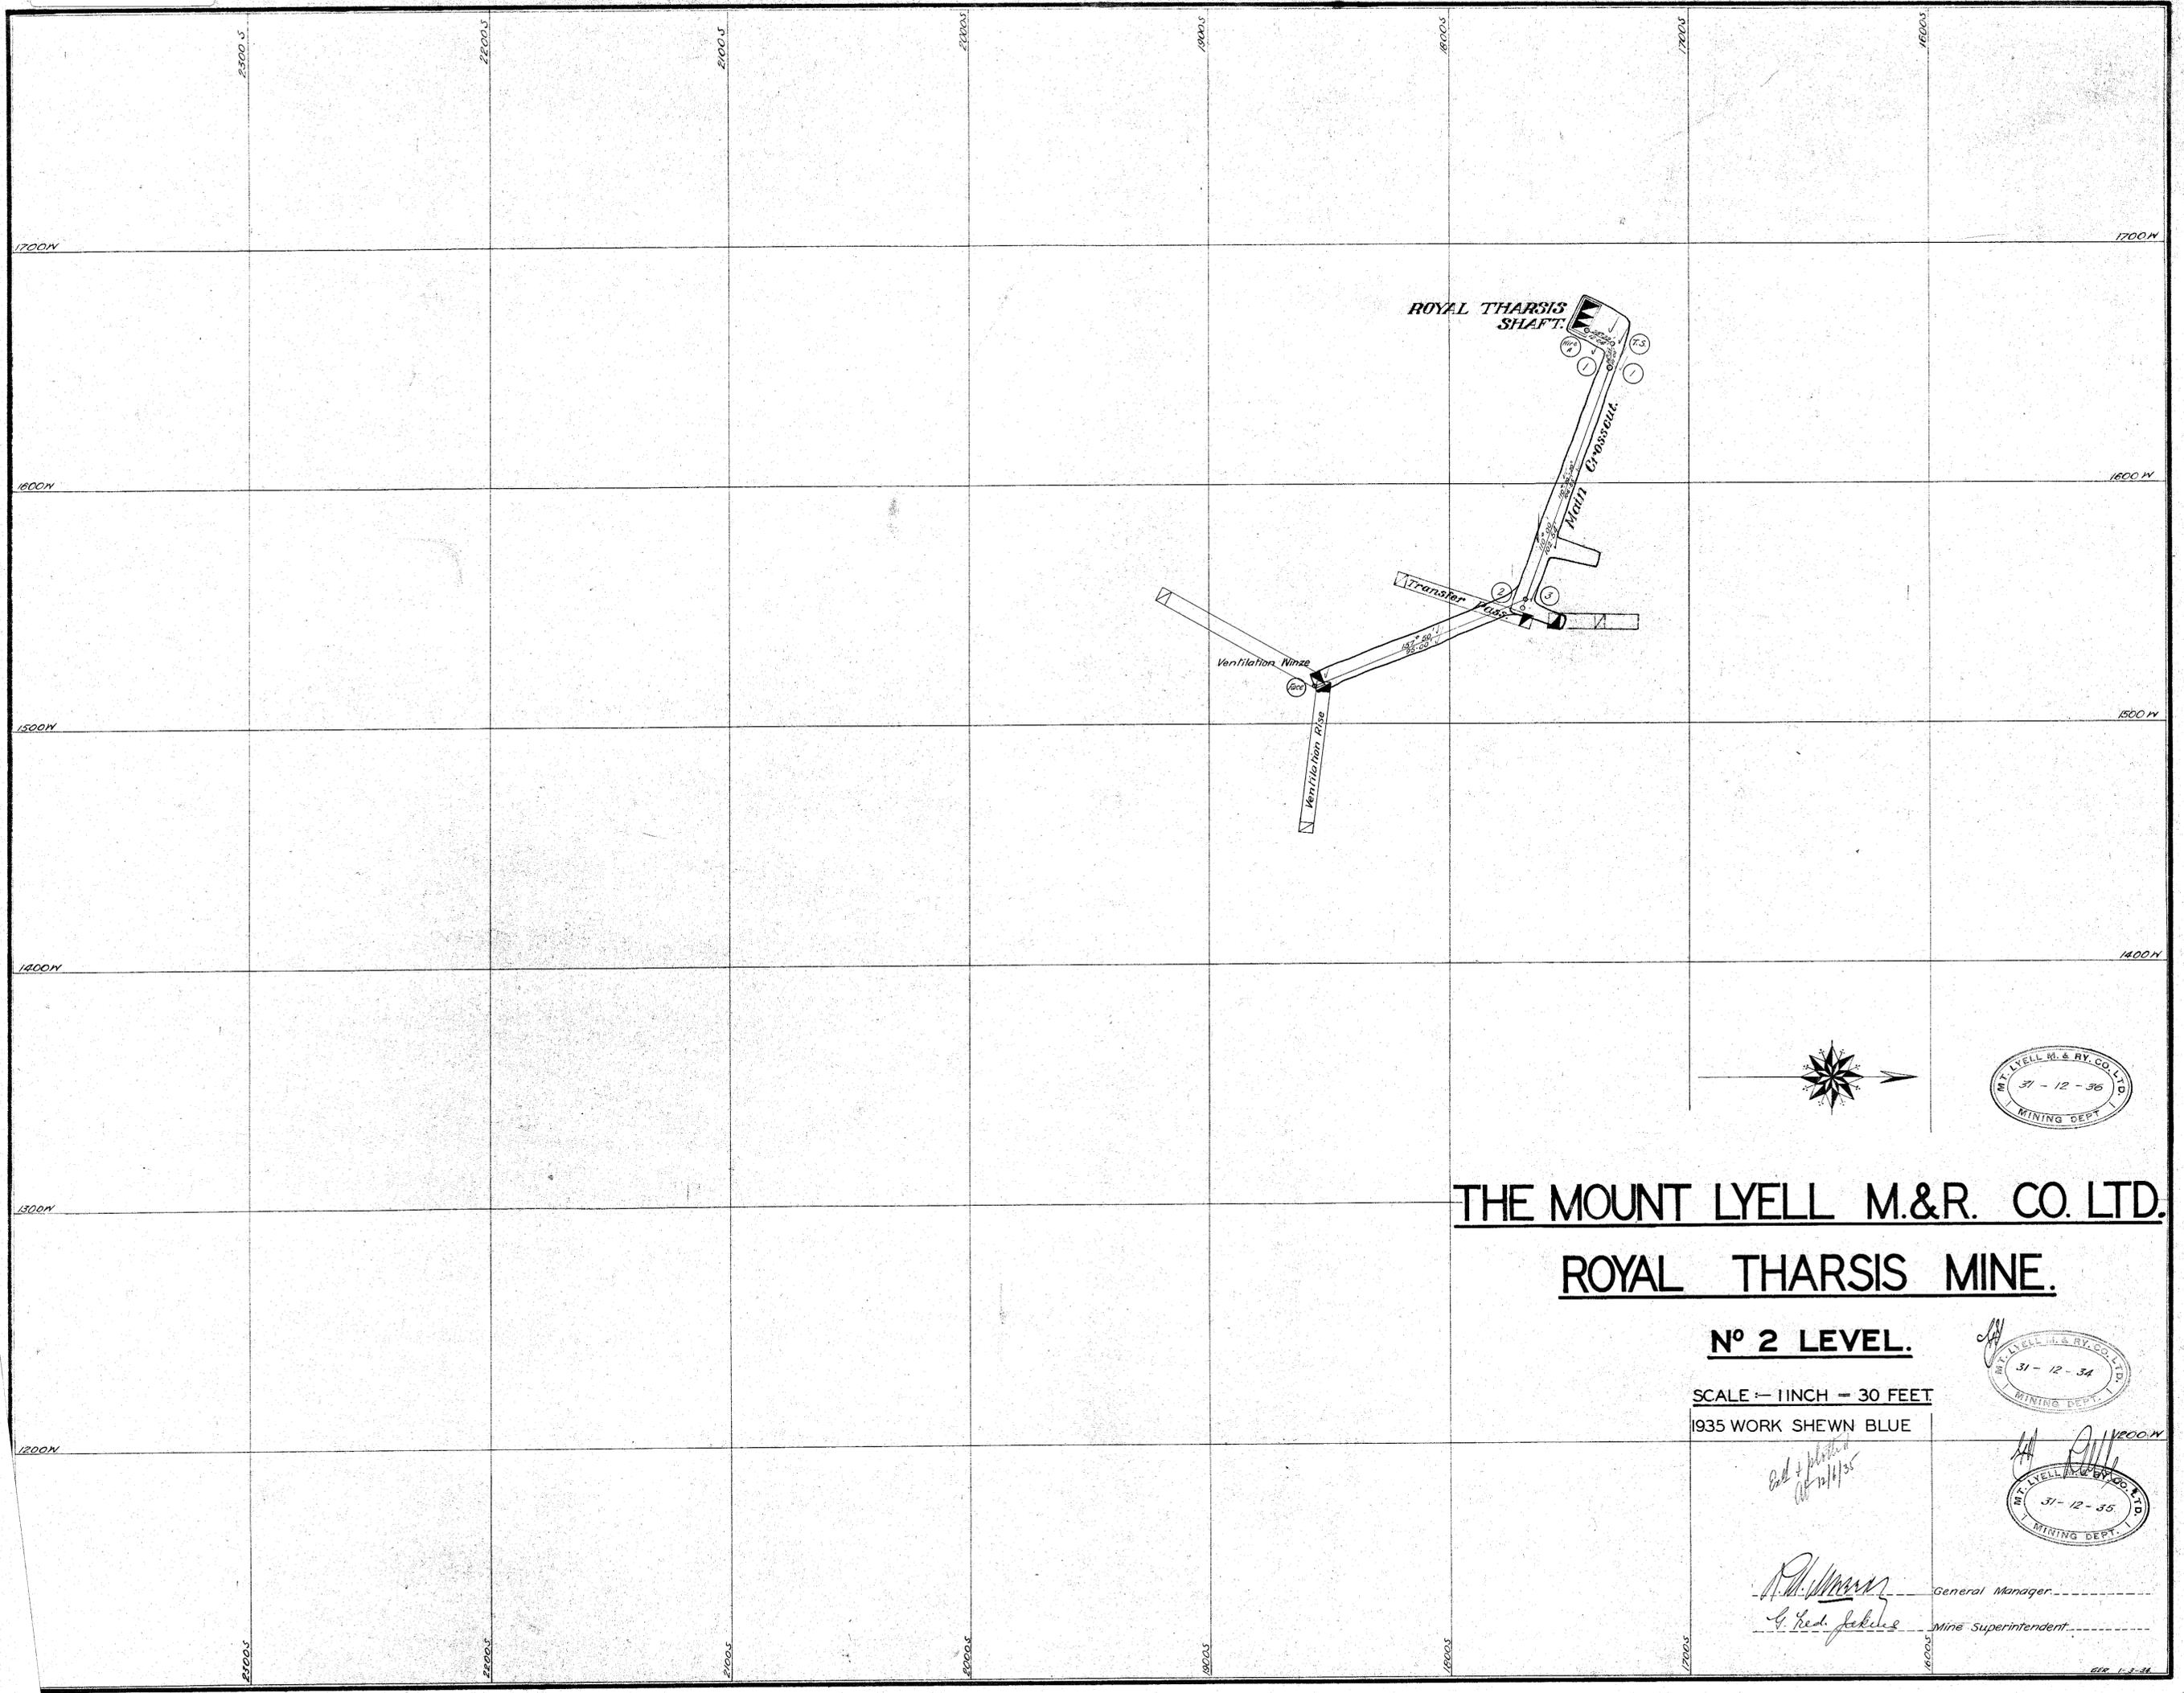

**THE MOUNT LYELL M. & R. CO. LTD.**  
**ROYAL THARSIS MINE.**

**Nº 2 LEVEL.**  
 SCALE — 1 INCH = 30 FEET  
 1935 WORK SHEWN BLUE



*Ed. J. ...*  
 12/1/35



*R. H. ...* General Manager  
*G. ...* Mine Superintendent