


5 cm

56-17

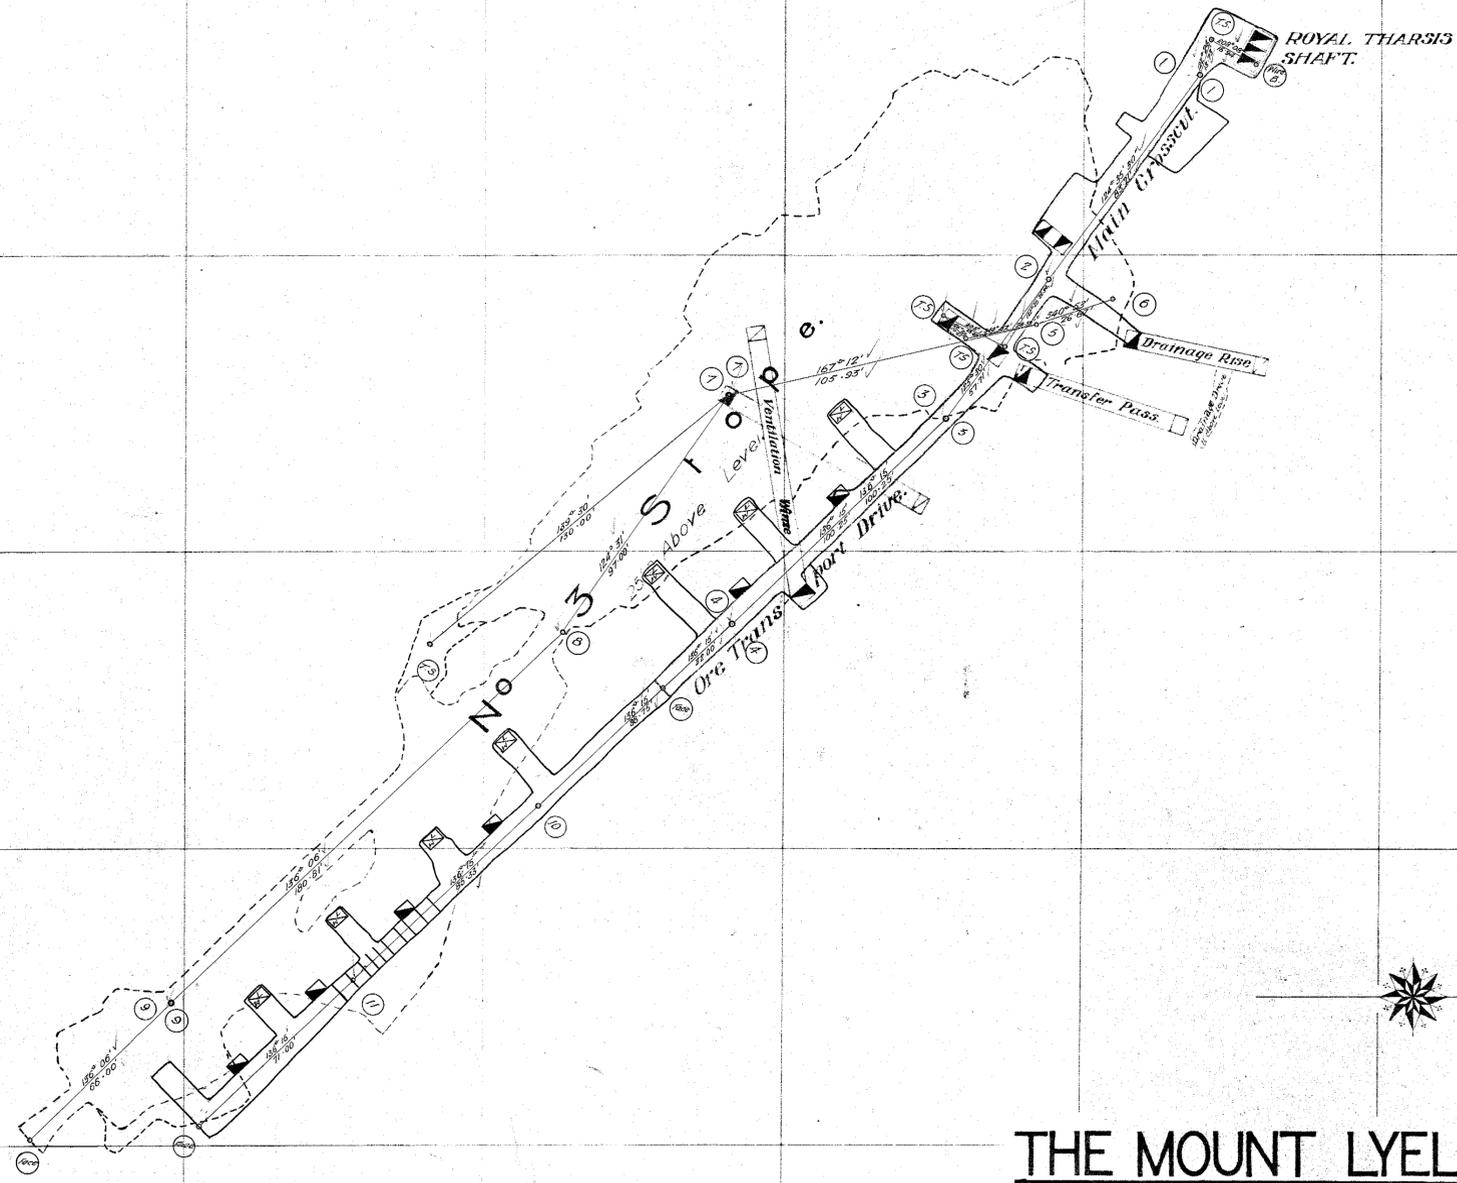

THE MOUNT LYELL M. & R. CO. LTD.
ROYAL THARSIS MINE.

No 3 LEVEL.

SCALE :- 1 INCH = 30 FEET.

1935 WORK SHEWN BLUE



*Ed + J. H. H. H. 12/1/35
 14/1/36*

[Signature]
[Signature]

General Manager

Mine Superintendent