


5 cm

56-20

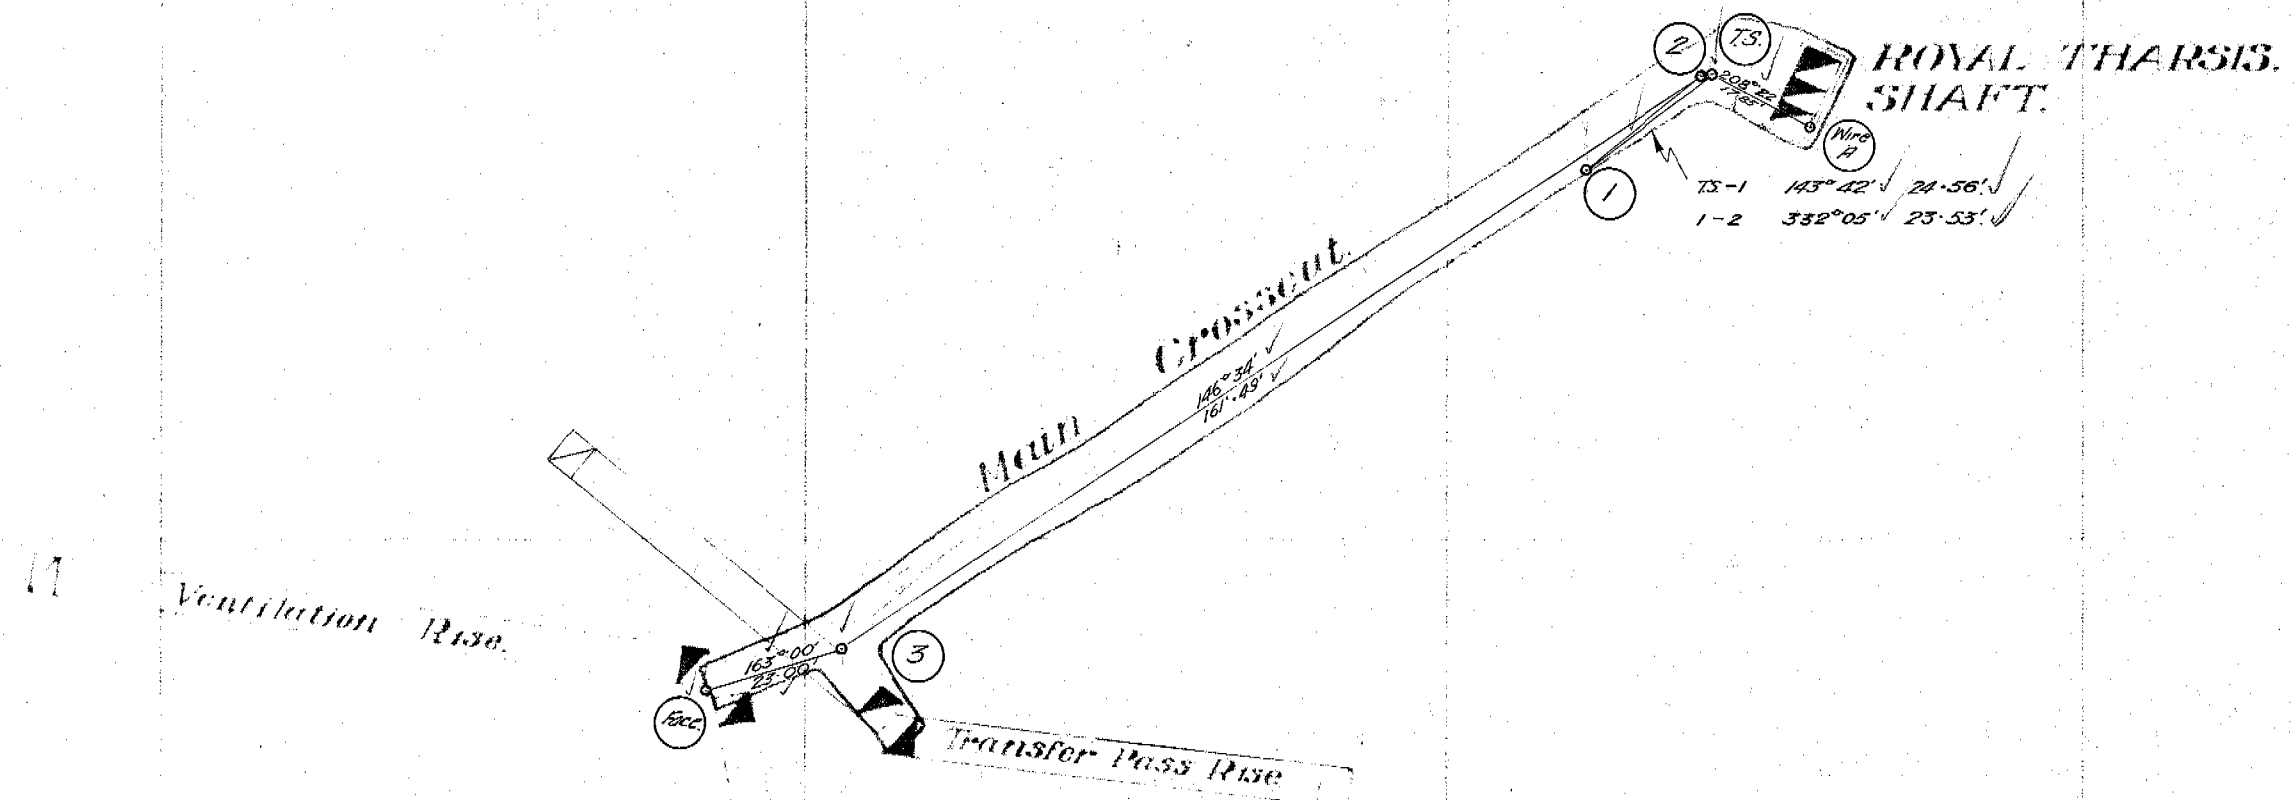

THE MOUNT LYELL M. & R. CO. LTD.  
ROYAL THARSIS MINE.

NO 4 LEVEL.

SCALE :- 1 INCH = 30 FEET.

*R. H. W. M.* General Manager  
*G. H. J. K.* Mine Superintendent