
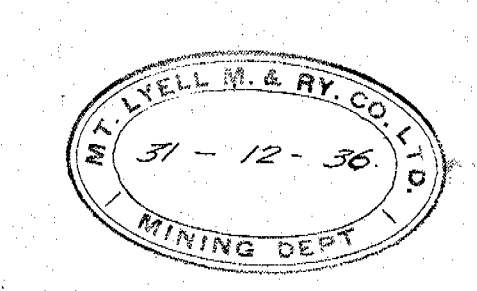
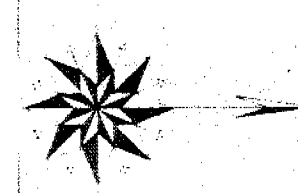


56-21

5 cm


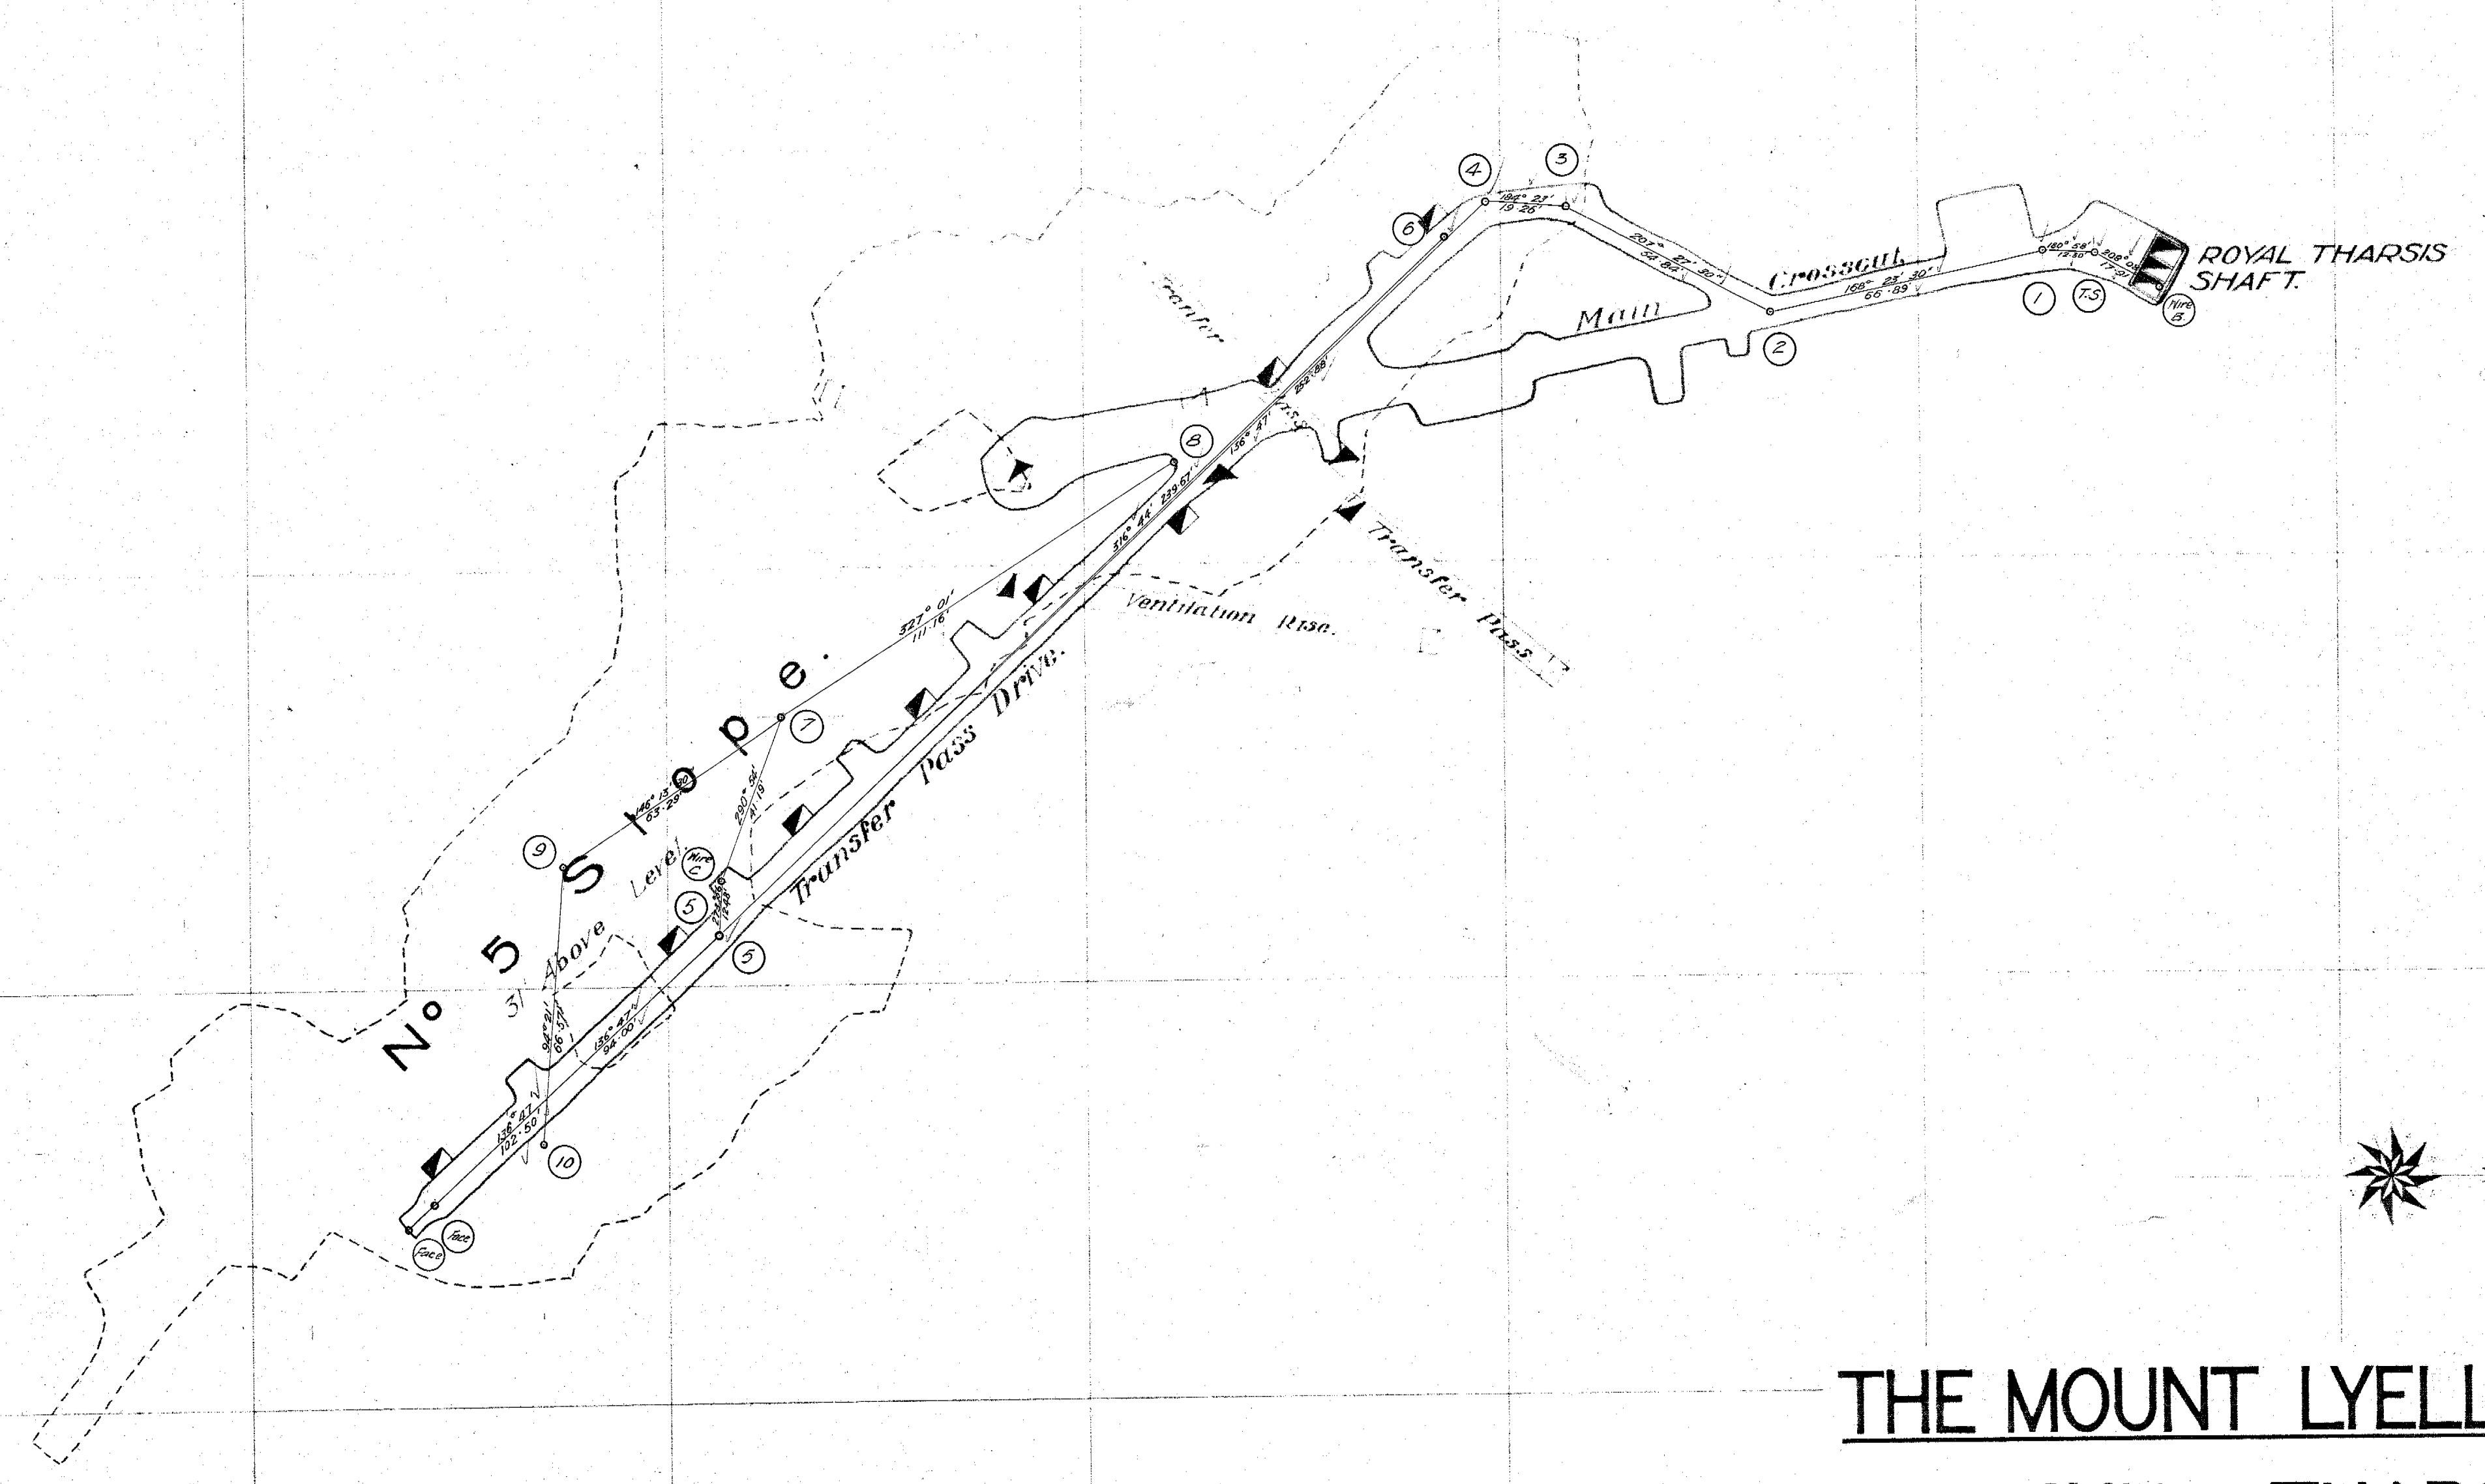


THE MOUNT LYELL M. & R. CO. LTD. ROYAL THARSIS MINE.

No 5 LEVEL.

SCALE :— 1 INCH = 30 FEET.

1935 WORK SHEWN BLUE

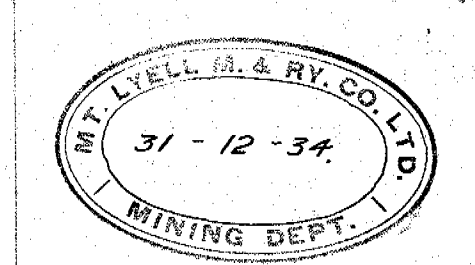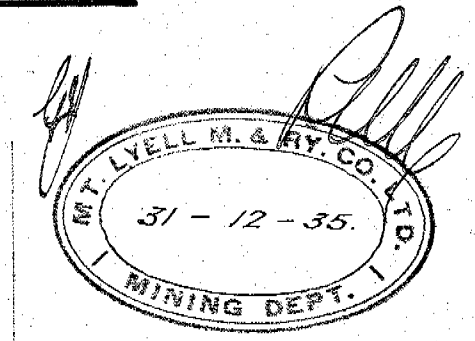

*Ed. & plotted
At 12/1/35*

R. H. Murray General Manager
S. Red J. J. J. Mine Superintendent