


5 cm

56-22

56-22

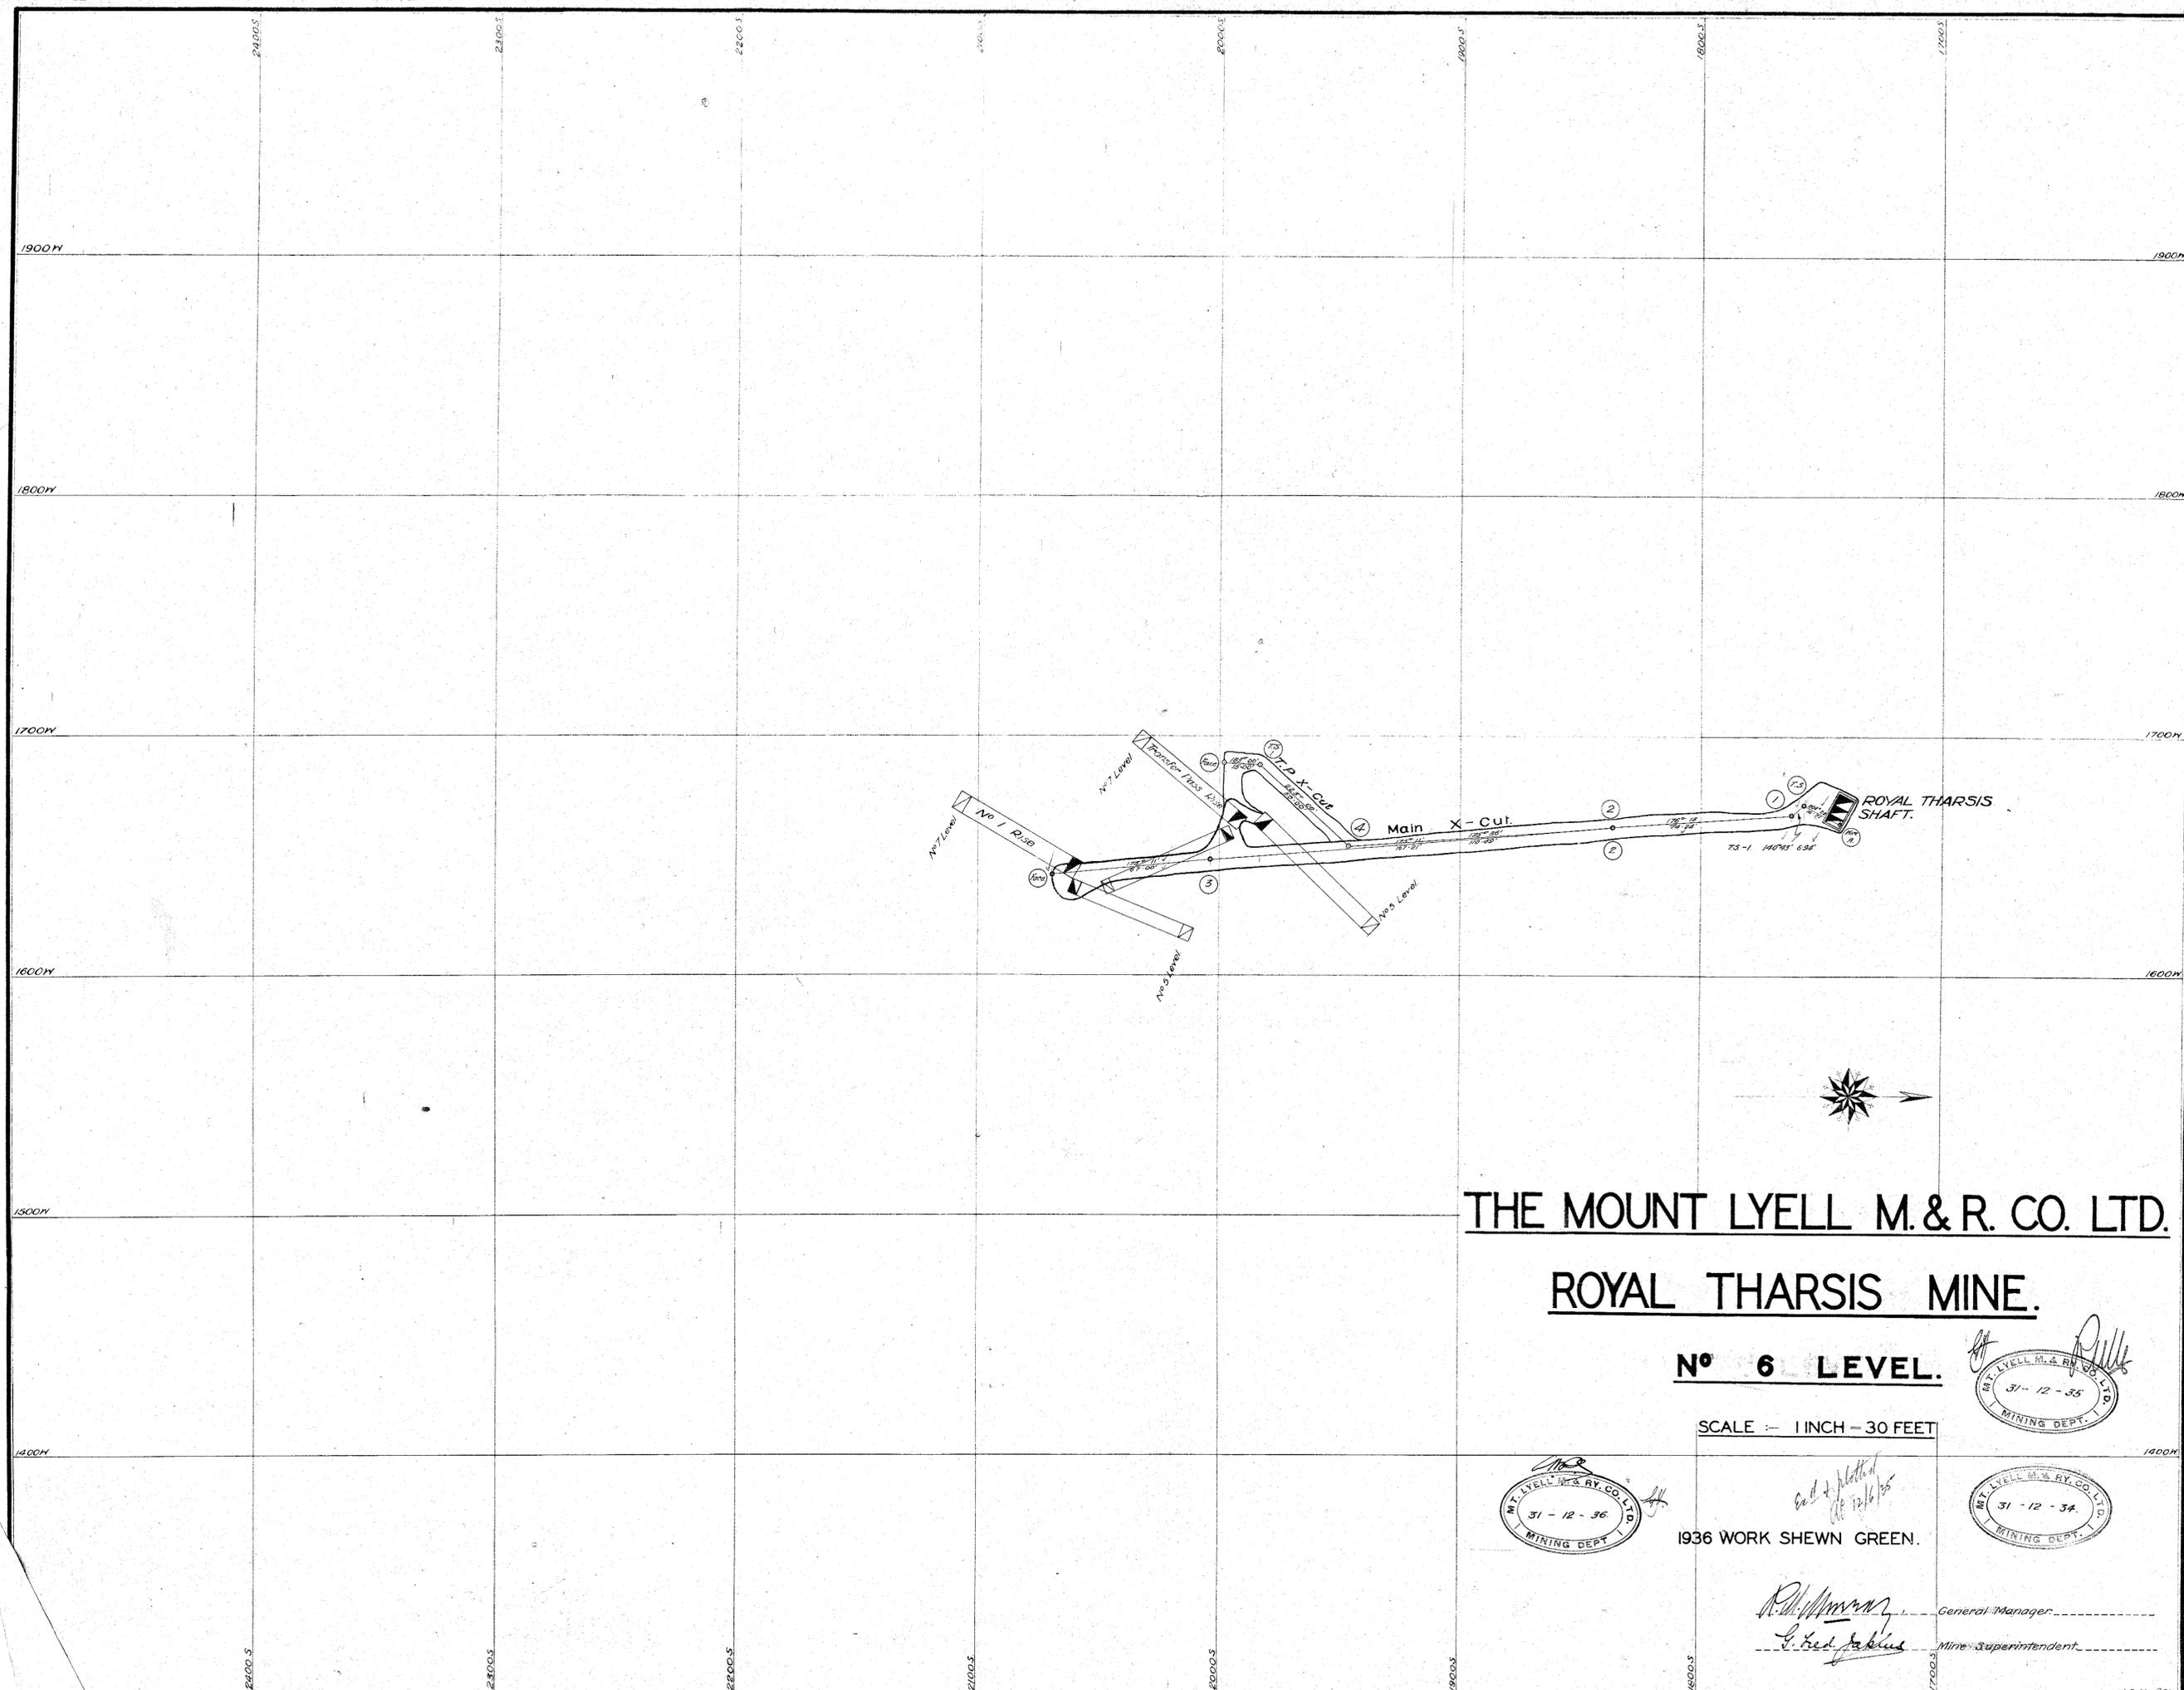

THE MOUNT LYELL M. & R. CO. LTD.

ROYAL THARSIS MINE.

No. 6 LEVEL.

SCALE : 1 INCH = 30 FEET

1936 WORK SHEWN GREEN.

R. H. Murray General Manager
E. Fred Jakins Mine Superintendent

