


56-26

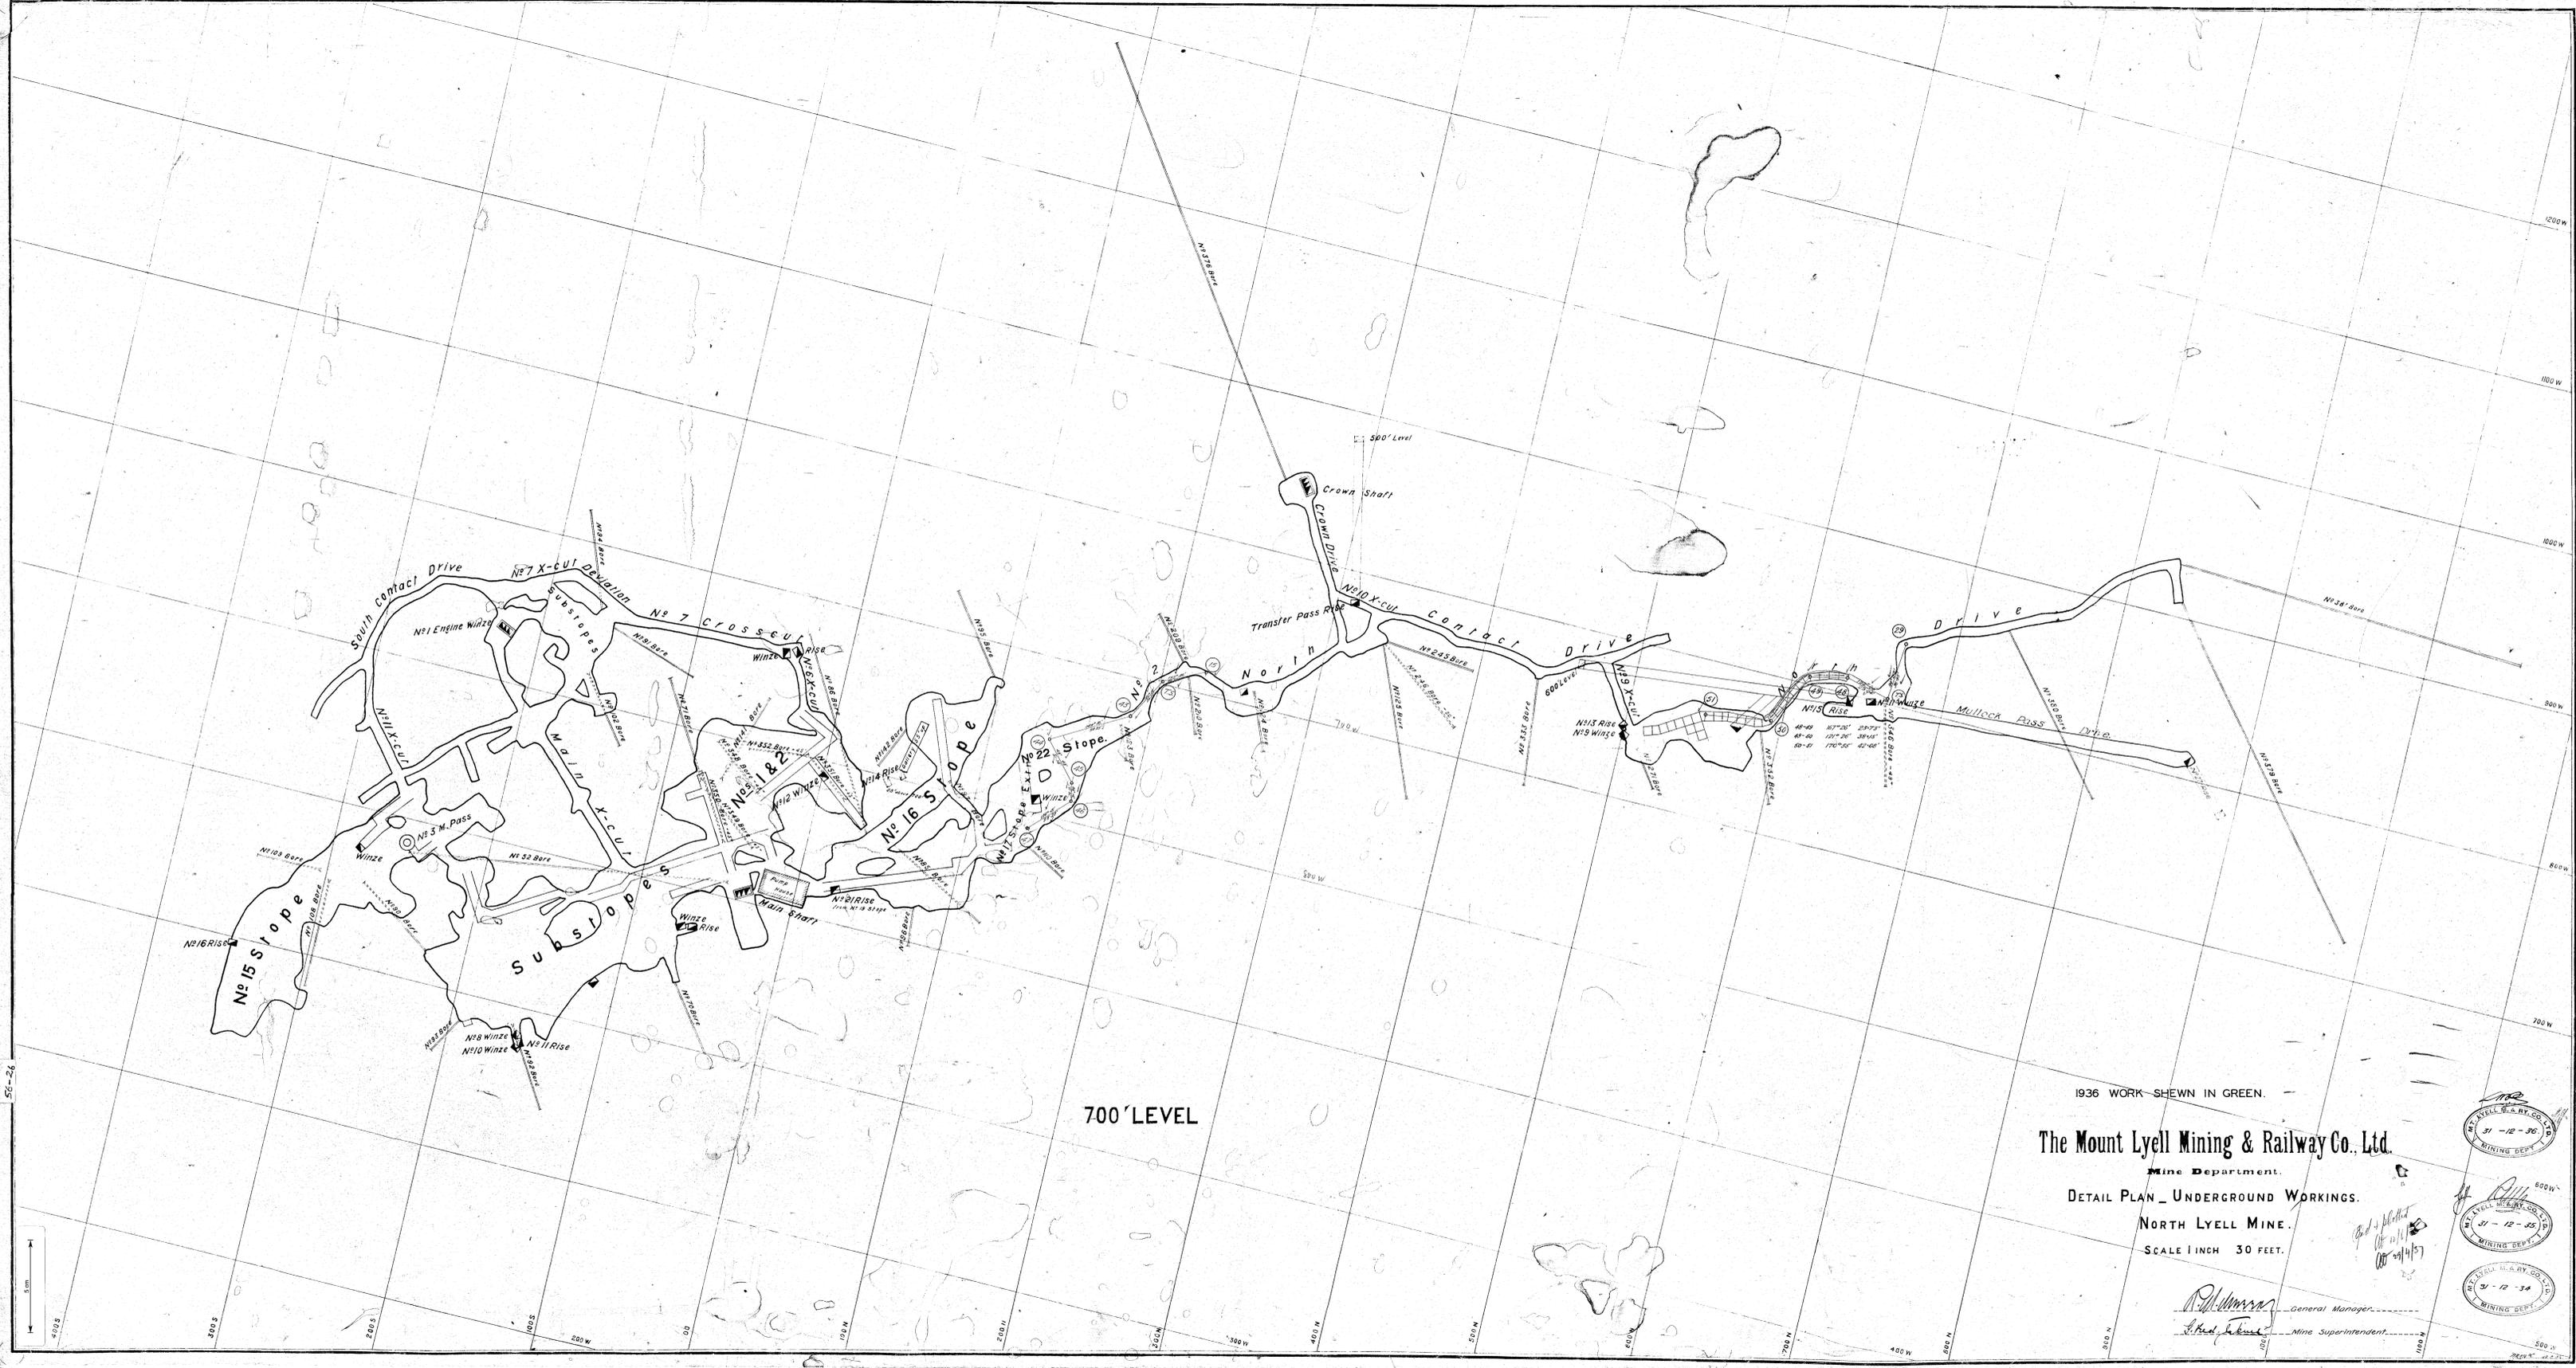

700' LEVEL

1936 WORK SHOWN IN GREEN.

The Mount Lyell Mining & Railway Co., Ltd.

Mine Department.

DETAIL PLAN - UNDERGROUND WORKINGS.

NORTH LYELL MINE.

SCALE 1 INCH = 30 FEET.

R. J. ... General Manager
A. ... Mine Superintendent



56-26