



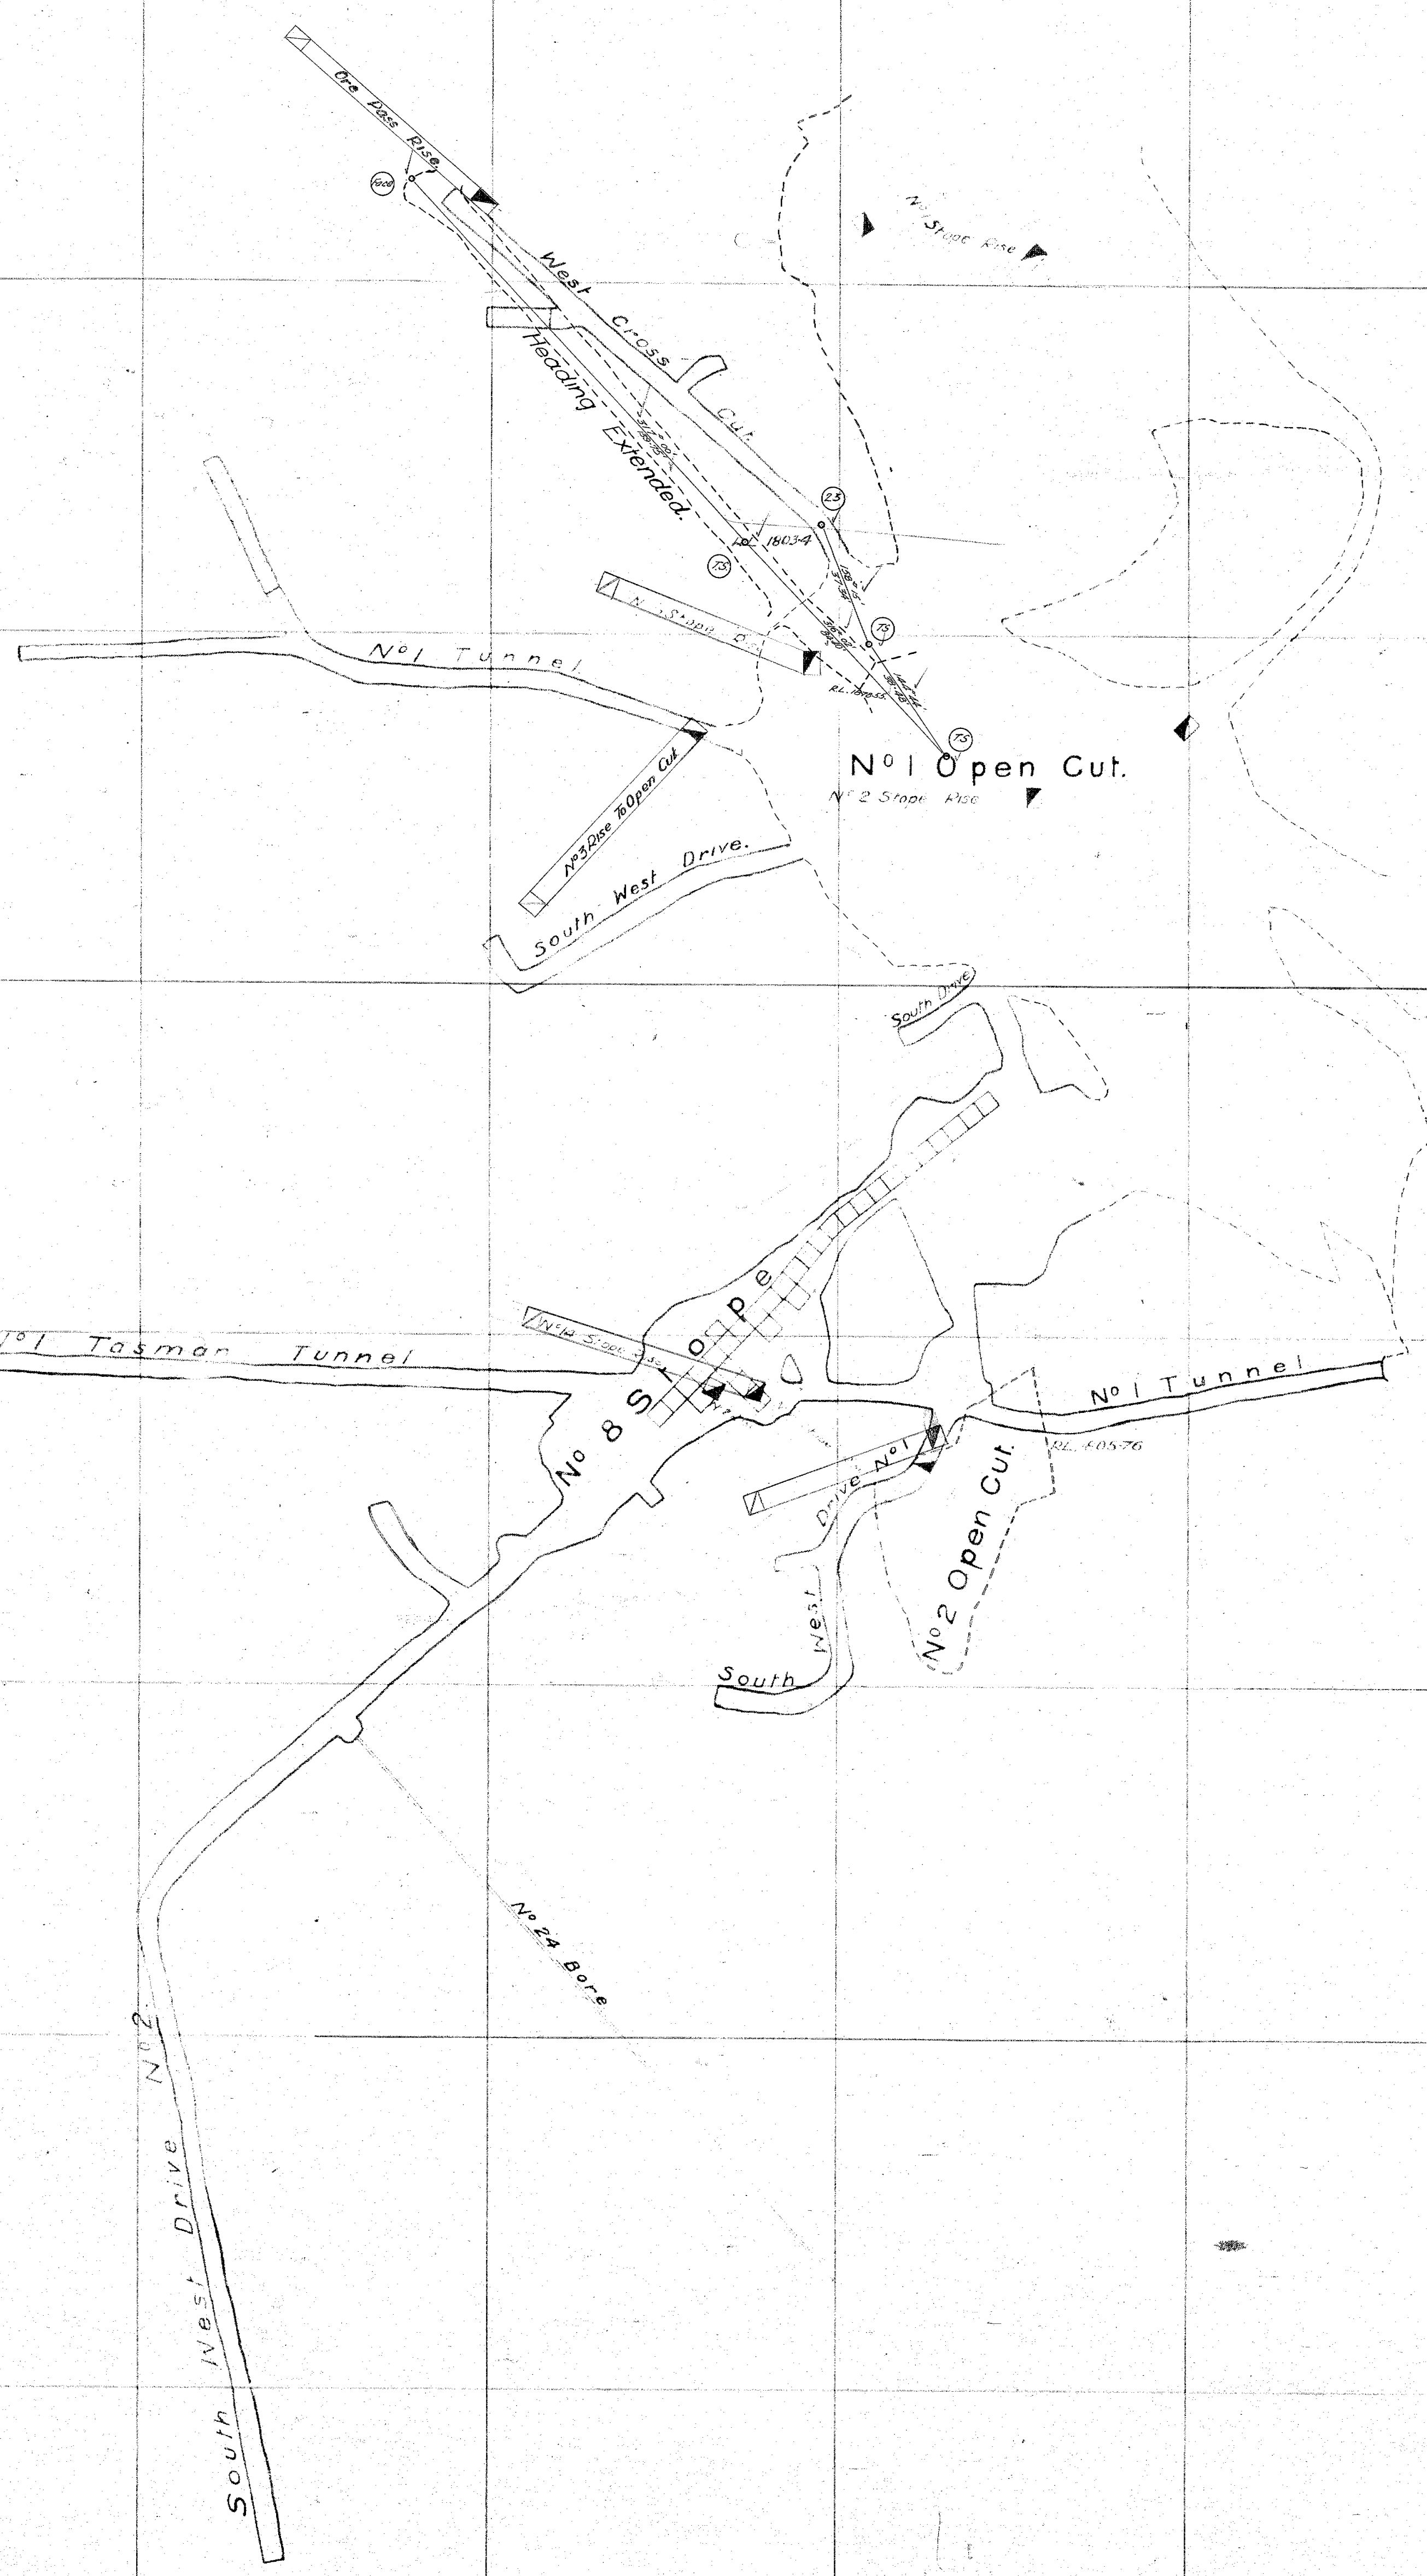


THE MOUNT LYELL M. & R. CO. LTD.
 LYELL COMSTOCK MINE.

No. 1 LEVEL.

SCALE - 1 INCH = 30 FEET

*Ed + plotted
 12/1/35*

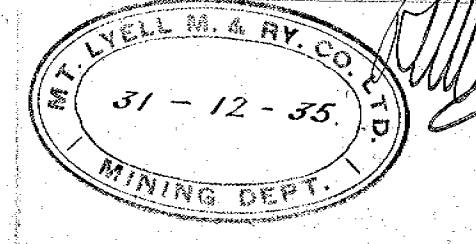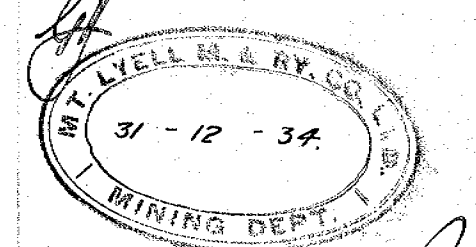

R. H. Wynn General Manager
S. Redfurn Mine Superintendent

58-29

