


56-34

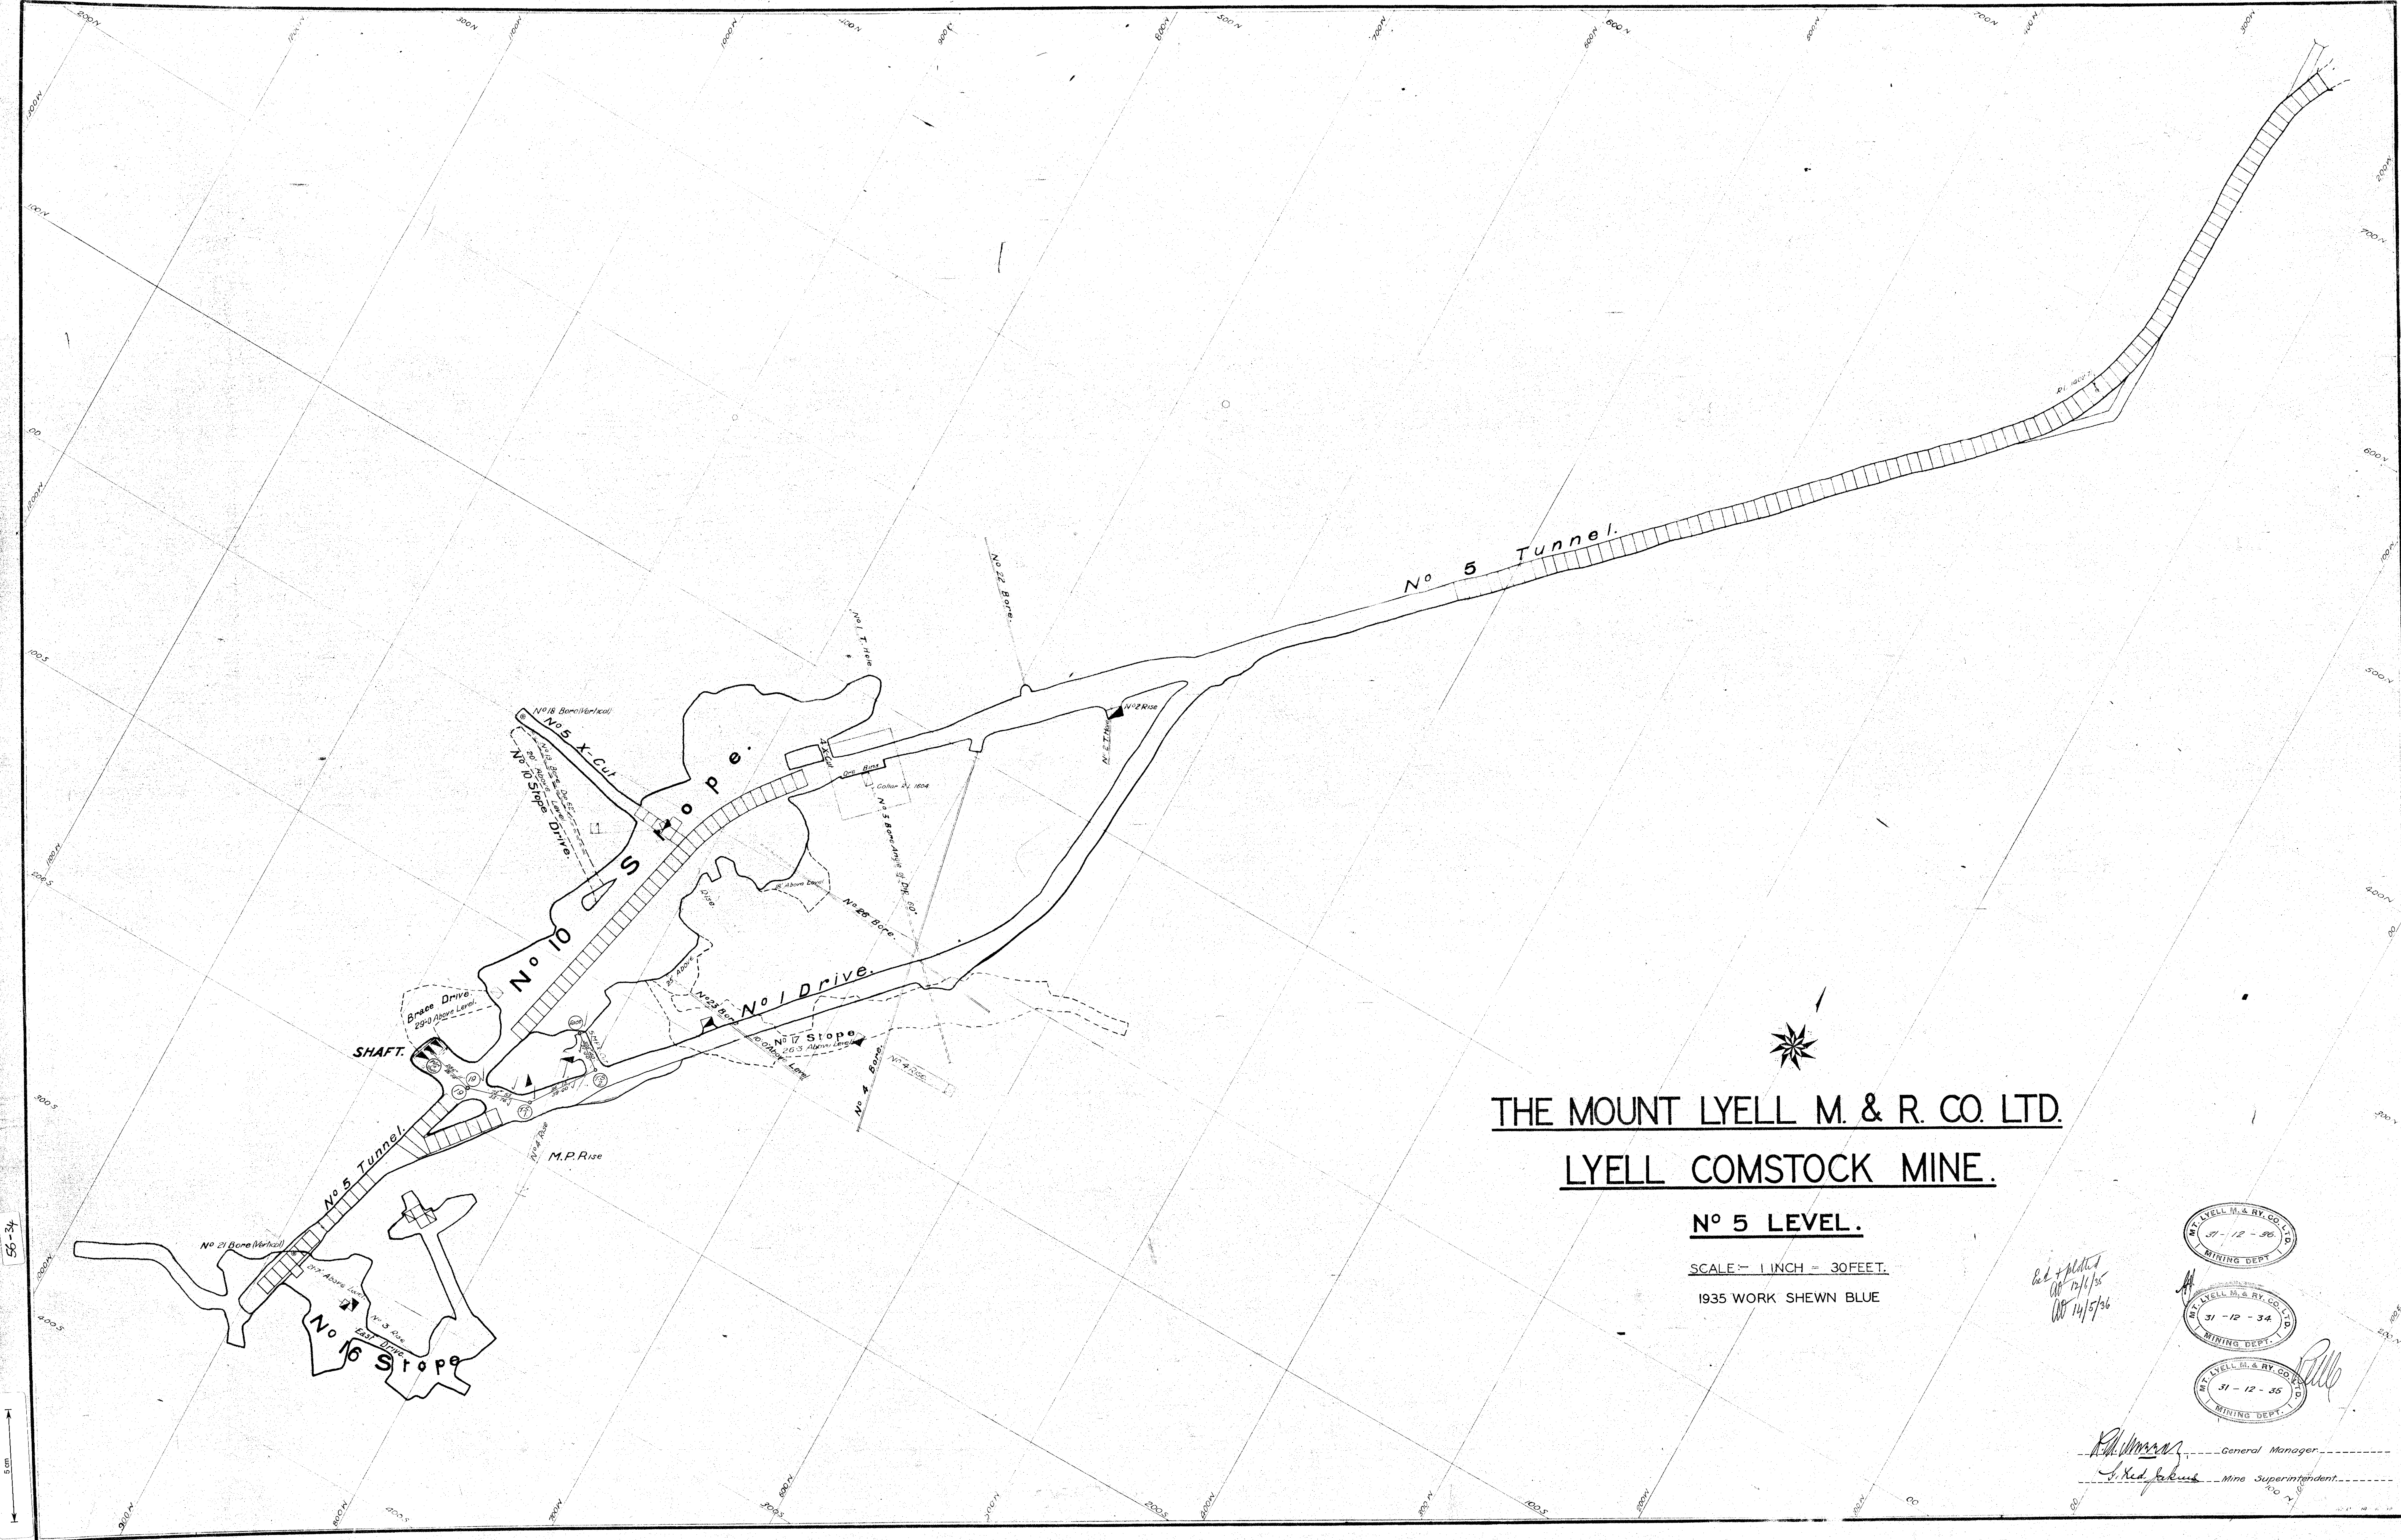




THE MOUNT LYELL M. & R. CO. LTD.
LYELL COMSTOCK MINE.

No. 5 LEVEL.

SCALE - 1 INCH = 30 FEET.

1935 WORK SHEWN BLUE

*Red + plotted
12/1/35
12/15/36*

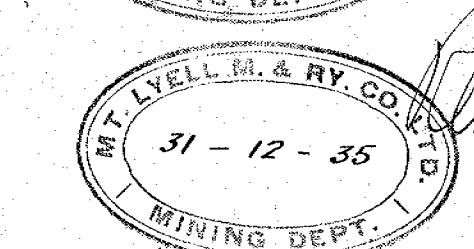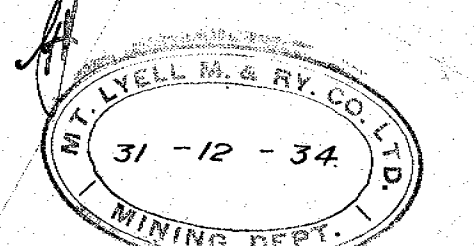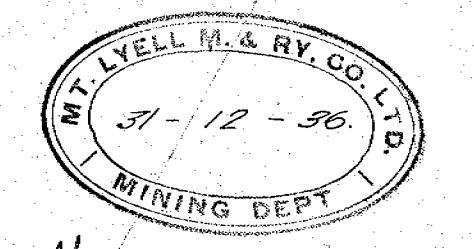

Red General Manager
J. Red Mine Superintendent