


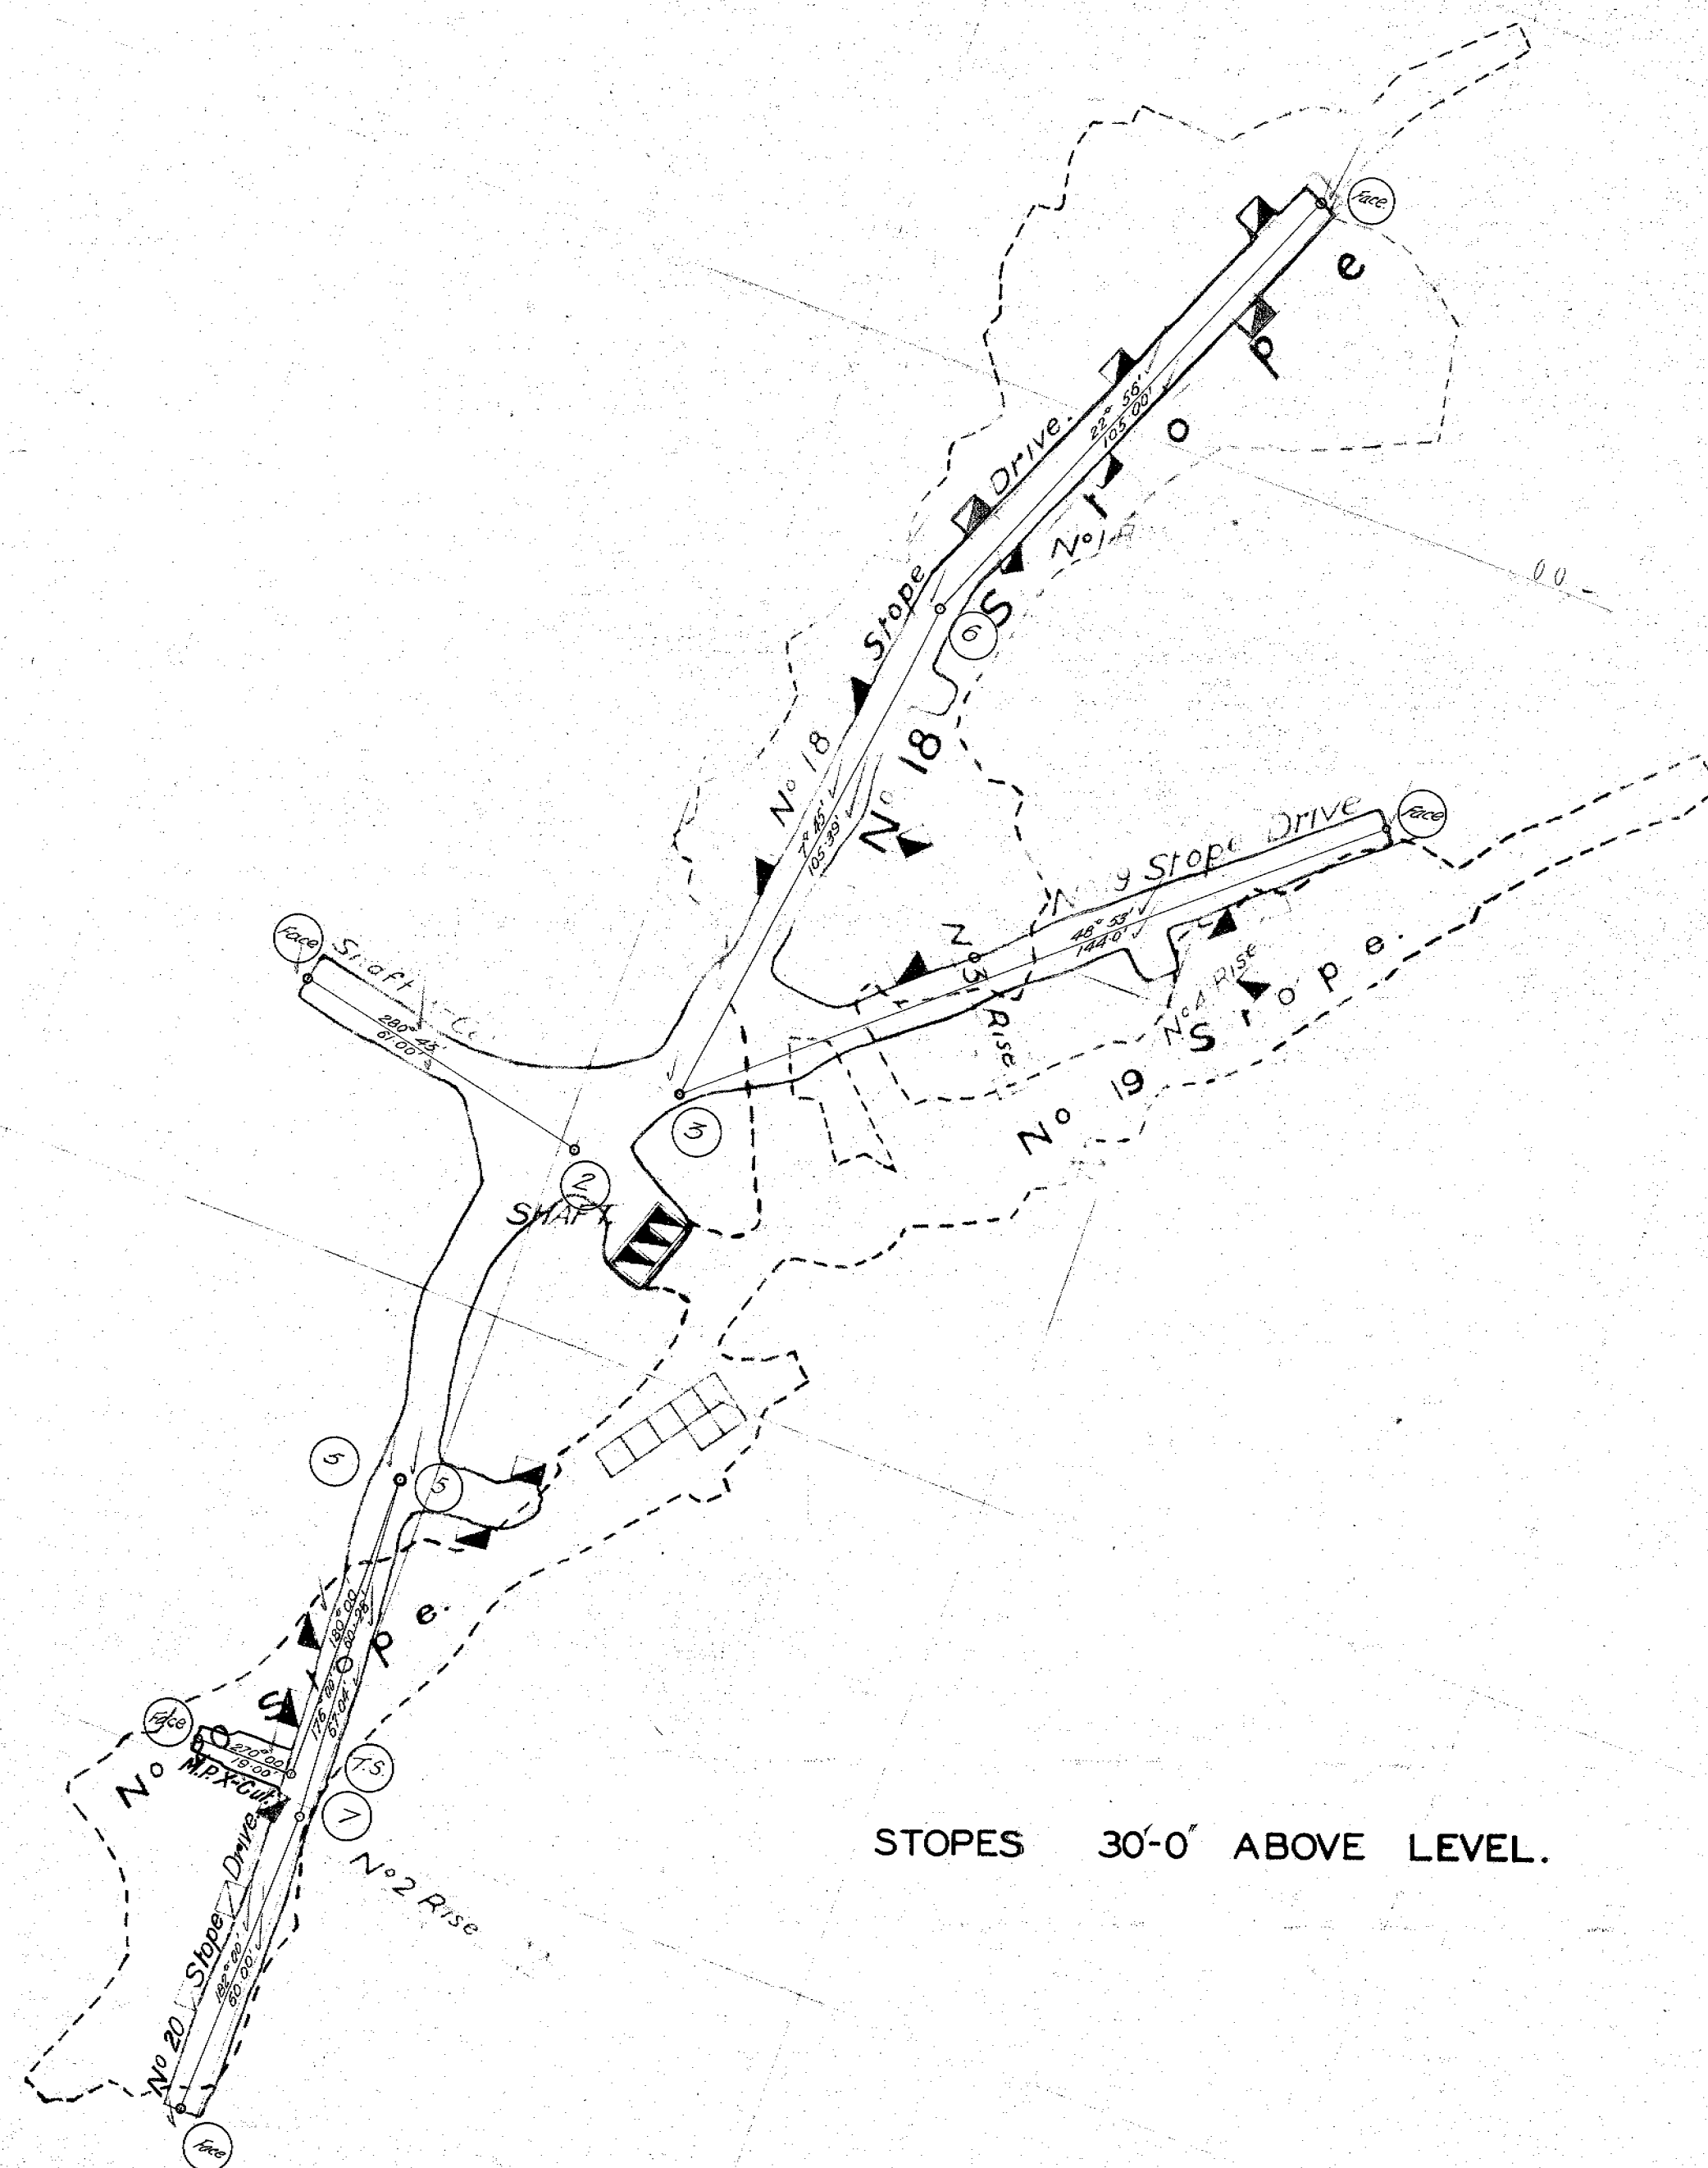

STOPE 30'-0" ABOVE LEVEL.



THE MOUNT LYELL M. & R. CO. LTD.

LYELL COMSTOCK MINE.

No 6 LEVEL.

SCALE = 1 INCH = 30 FEET
1935 WORK SHEWN BLUE

*Exd & plotted
12/1/35
14/5/36*

[Signature]
[Signature]

General Manager
Mine Superintendent

