

56-37


5 cm

900 W.


800 W.

700 W.

600 W.

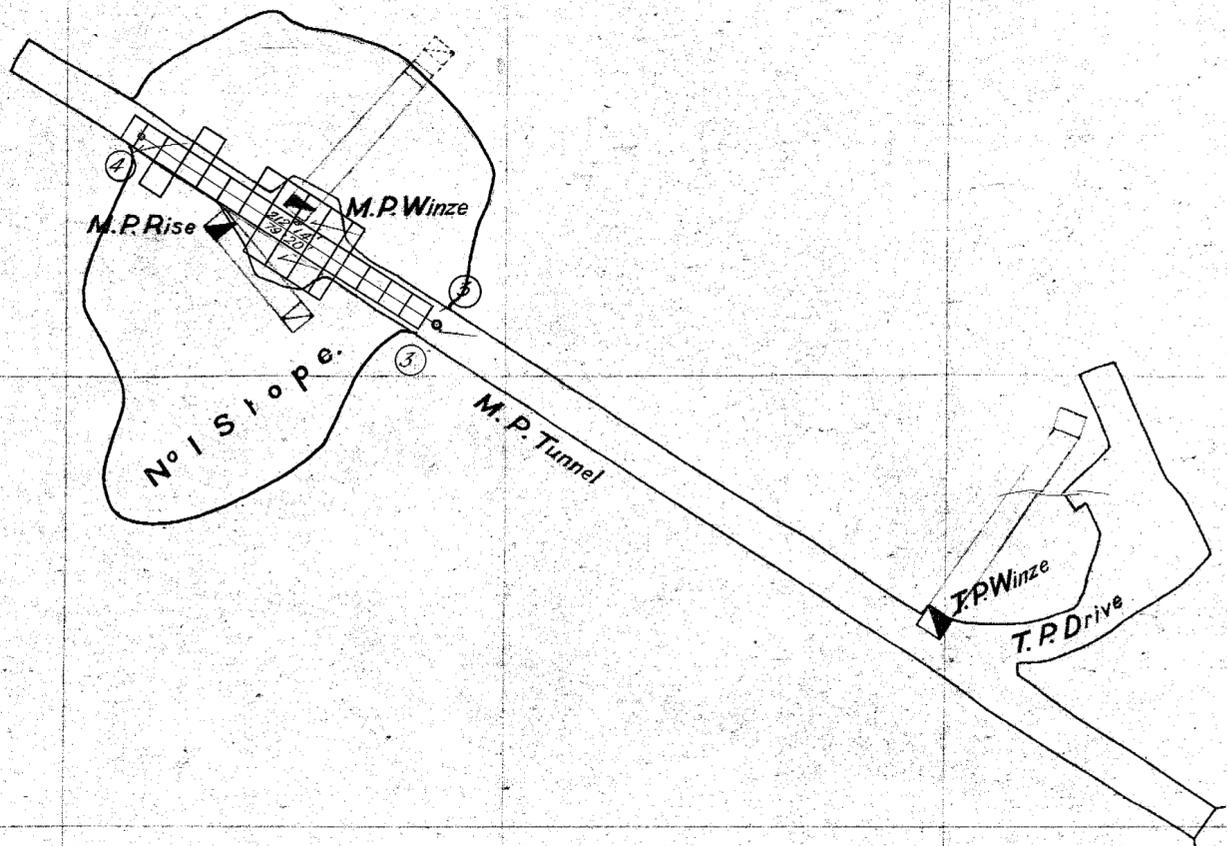

CROWN SHAFT

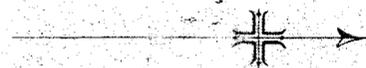

THE MOUNT LYELL M. & R. CO. LTD.

DETAIL PLAN

UNDERGROUND WORKINGS

M. P. TUNNEL LEVEL

CROWN LYELL MINE



A. P. Williams
S. Red. Jenkins

General Manager

Mine Superintendent

SCALE - 30 FEET TO THE INCH.

1935 WORK SHEWN BLUE

