
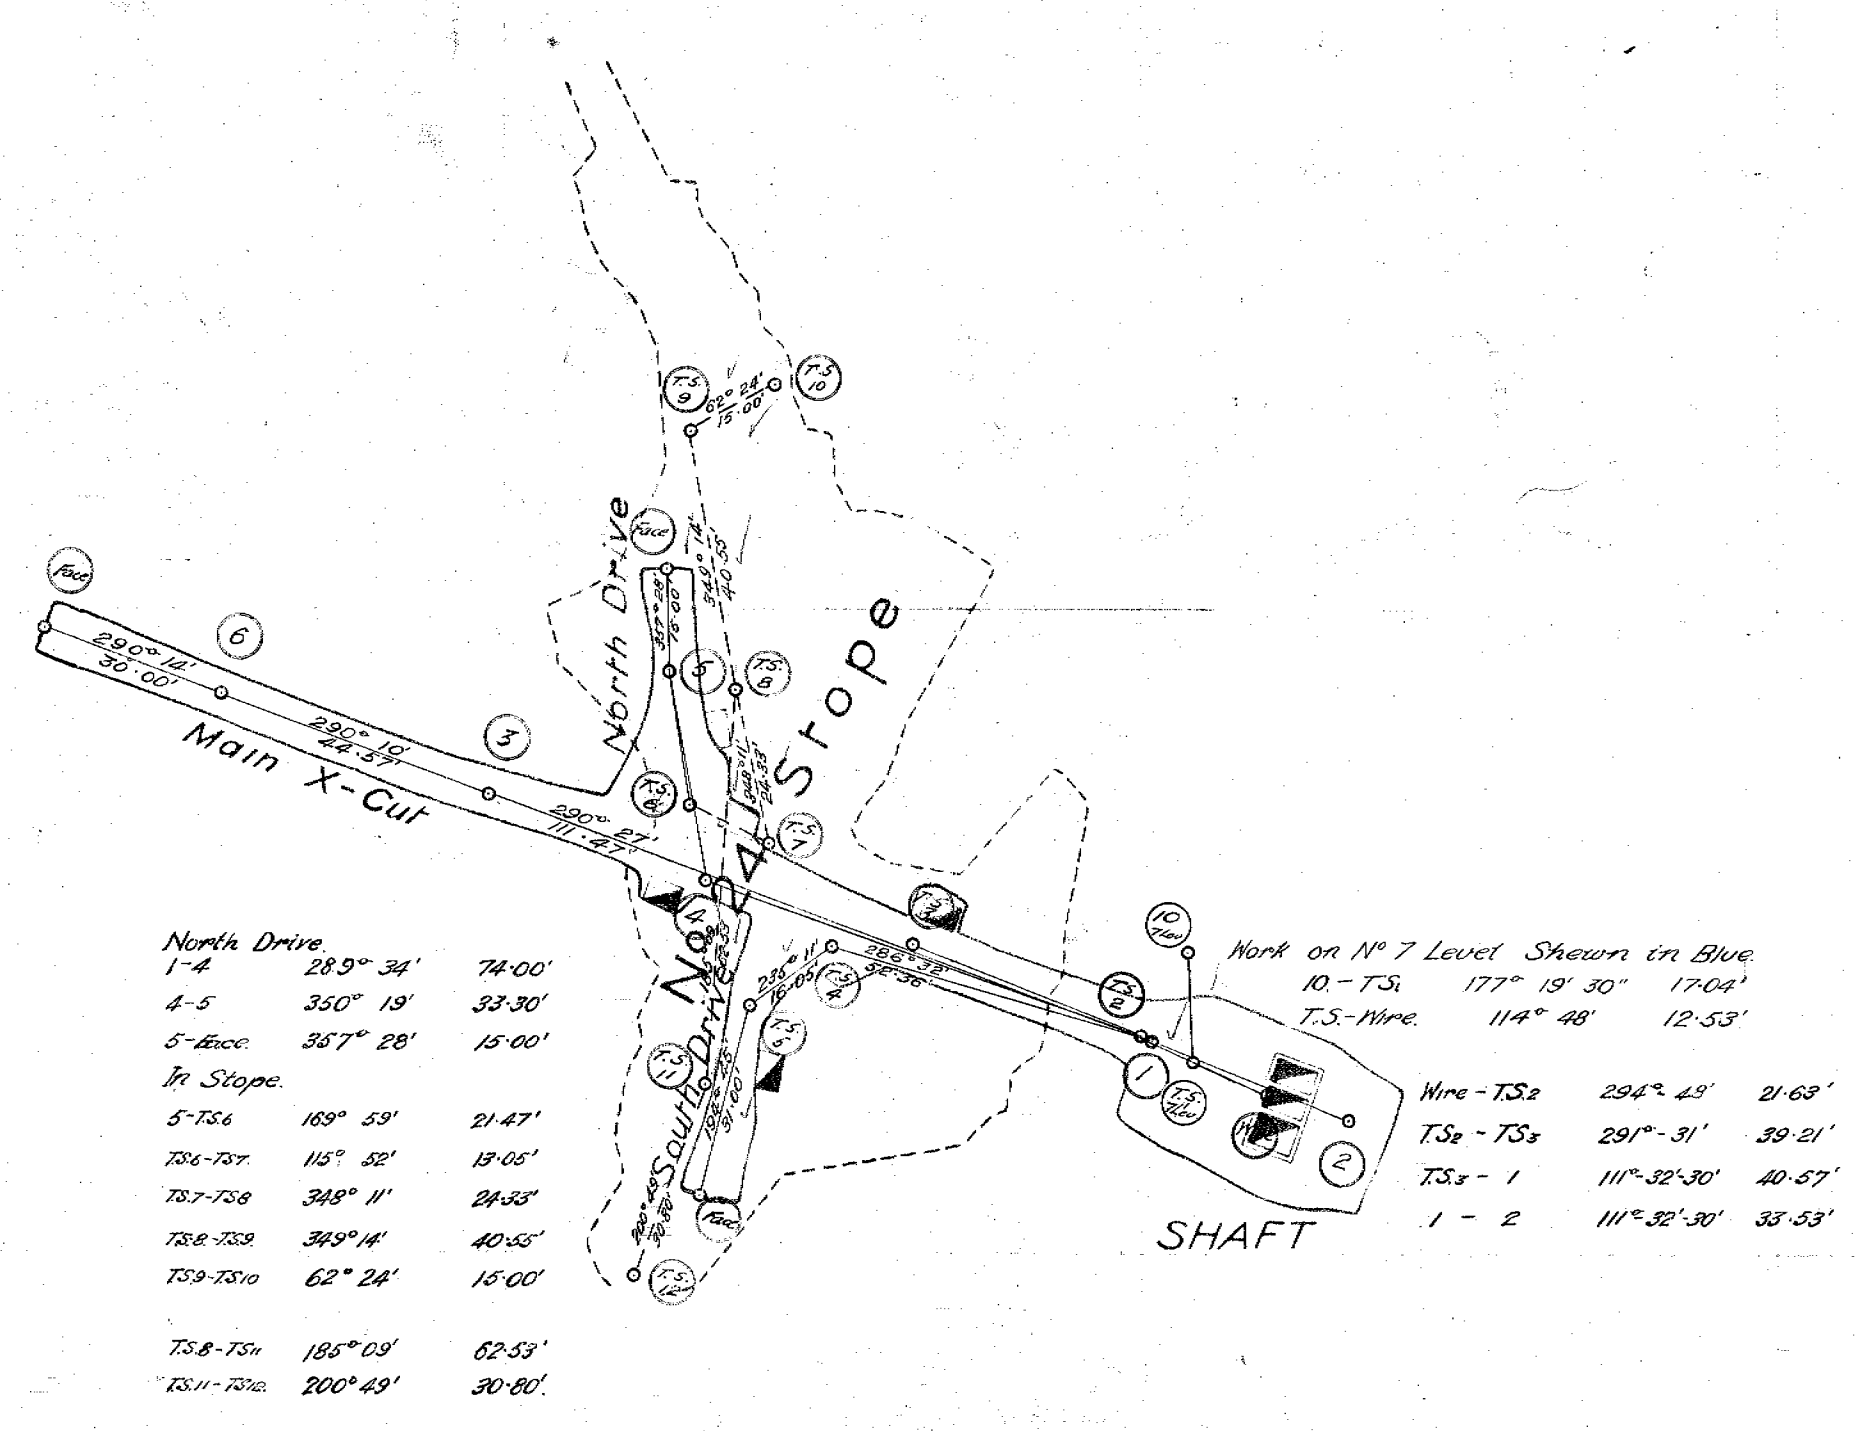


THE MOUNT LYELL M. & R. CO. LTD. LYELL COMSTOCK MINE.

No 8 LEVEL.

SCALE 1 INCH = 30 FEET

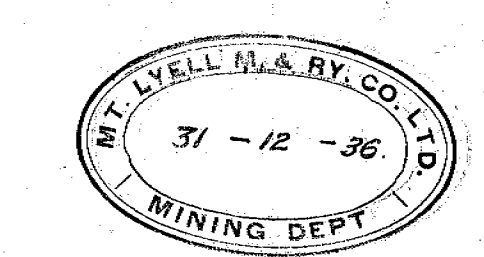

1936 WORK SHEWN GREEN.

General Manager *R. H. H. H.*
Mine Superintendent *H. H. H.*

58-38

