


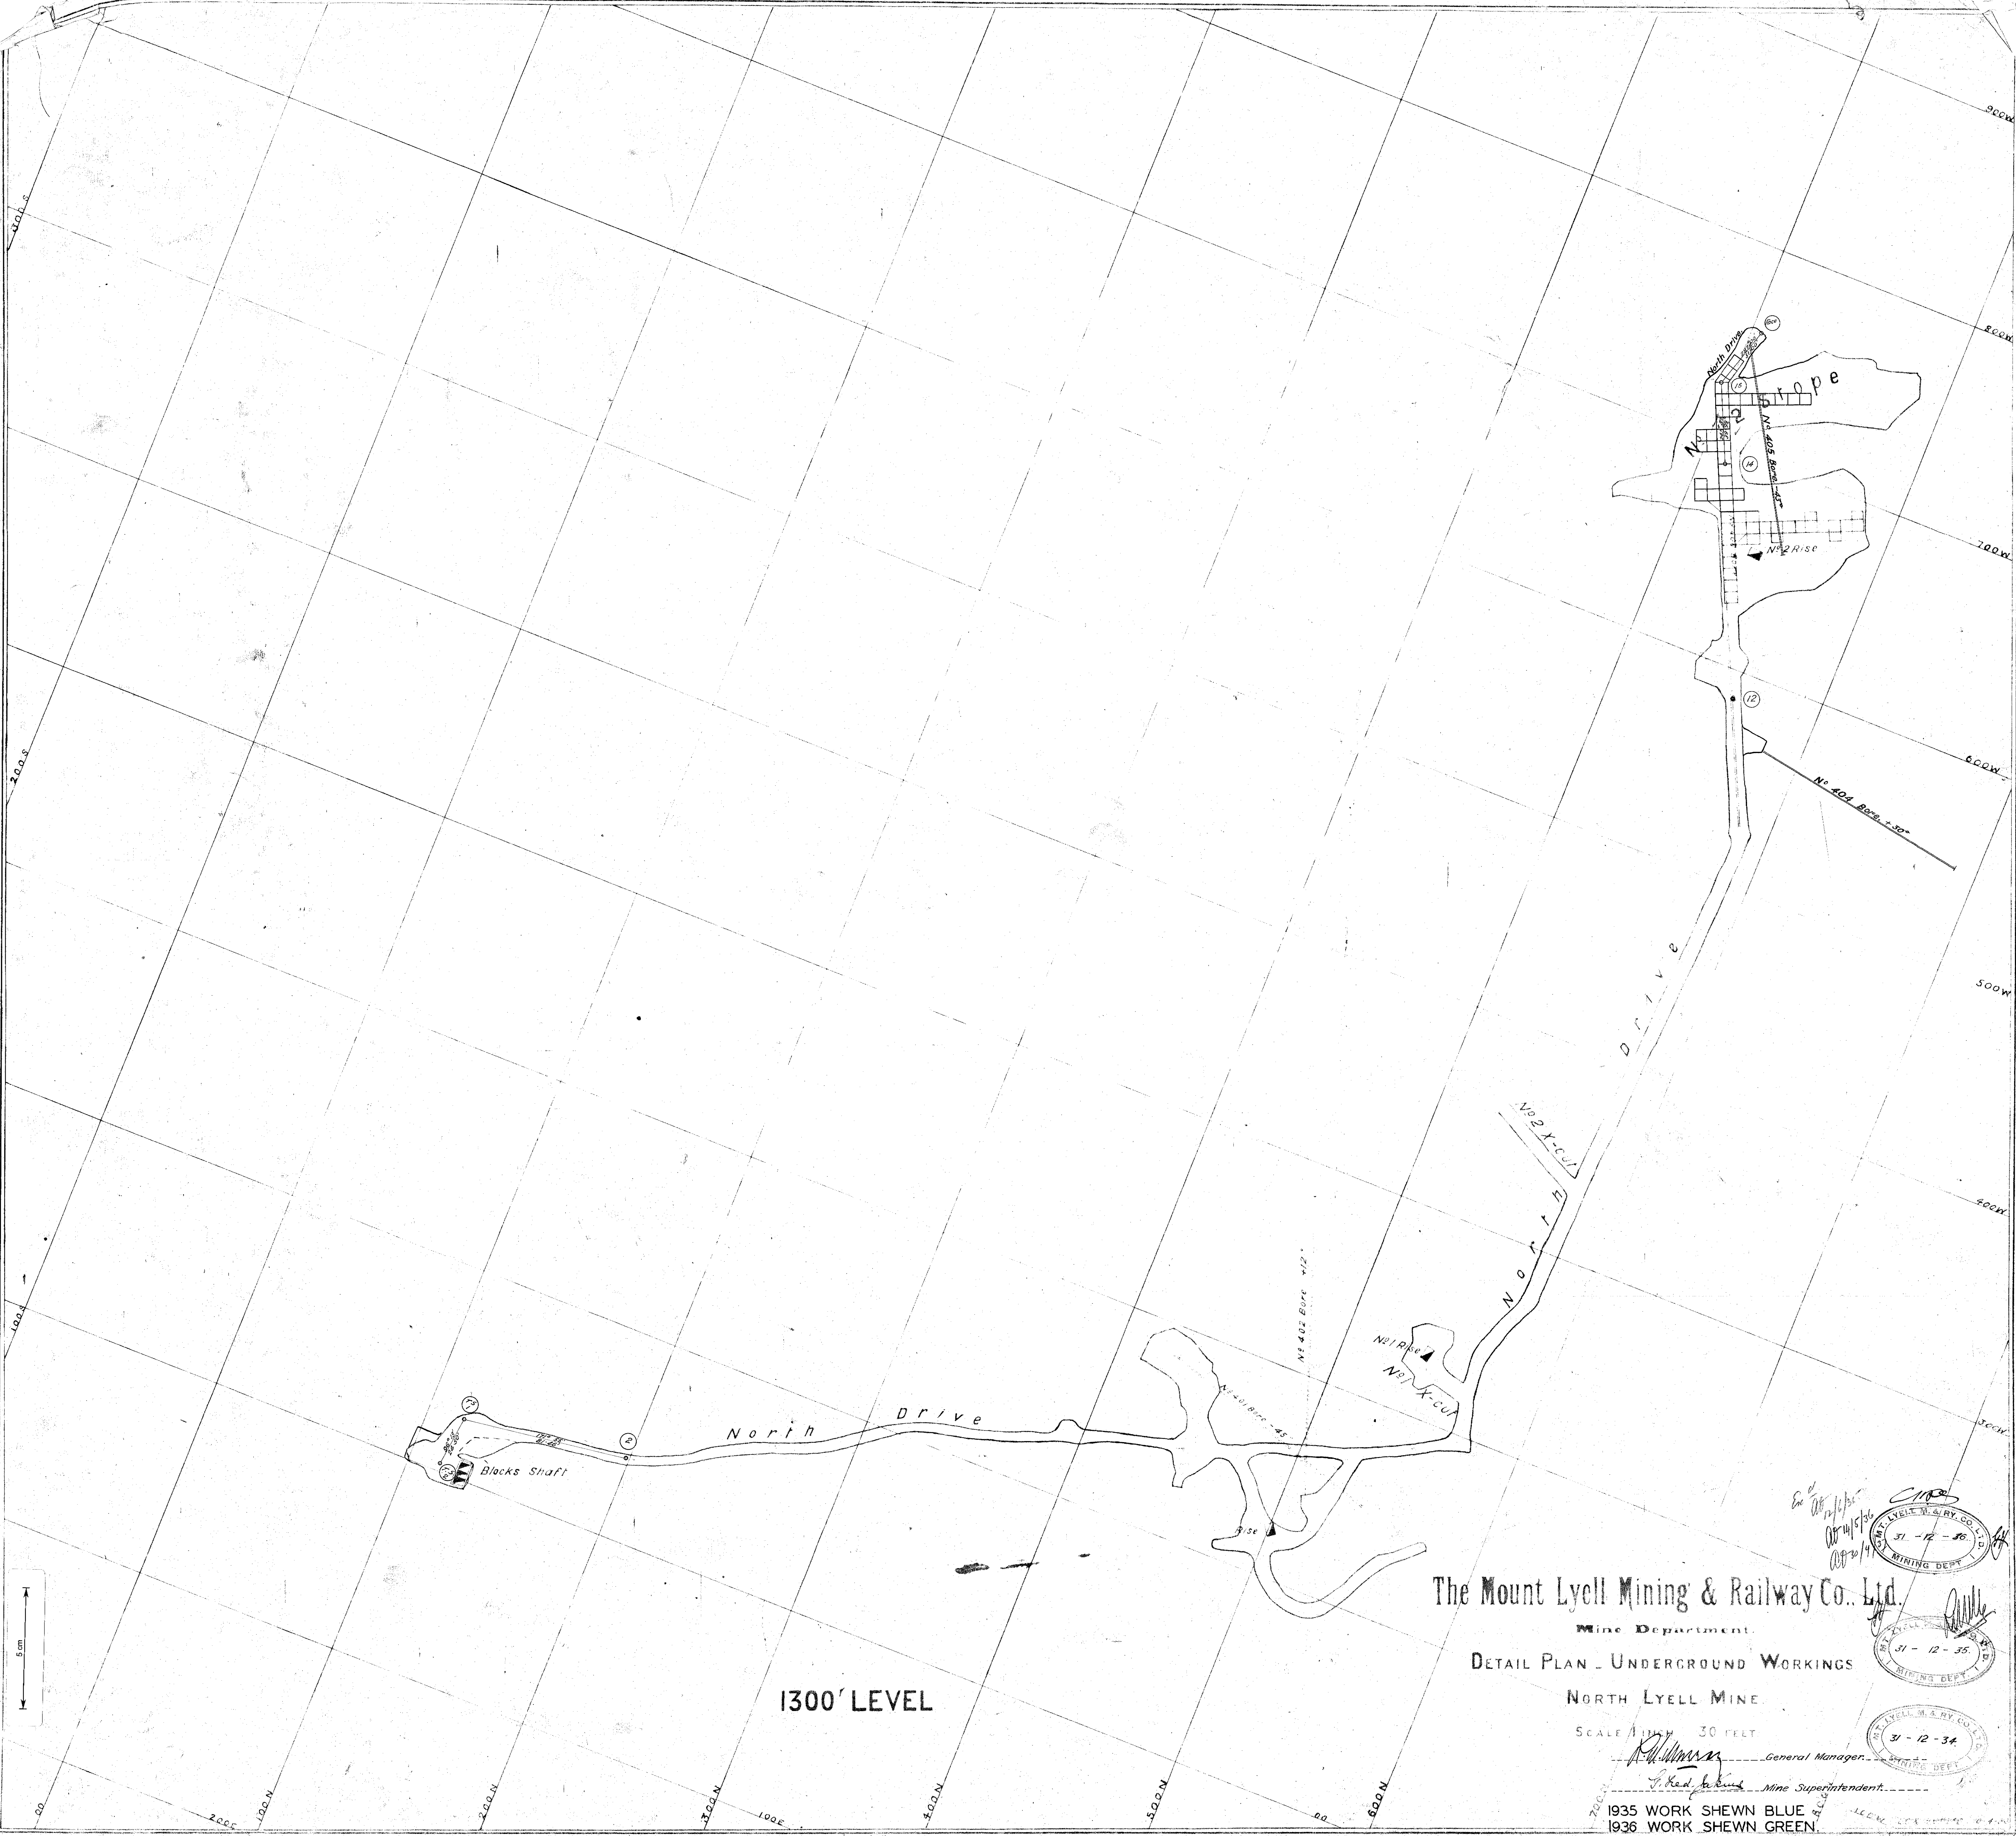

The Mount Lyell Mining & Railway Co., Ltd.

Mine Department:
DETAIL PLAN - UNDERGROUND WORKINGS
NORTH LYELL MINE.

SCALE 1 inch = 30 FEET
General Manager: *[Signature]*
Mine Superintendent: *[Signature]*

1935 WORK SHEWN BLUE
1936 WORK SHEWN GREEN.

