

56-41

5 cm

1000 W.

900 W.


800 W.

700 W.

100 S.

00

100 N.

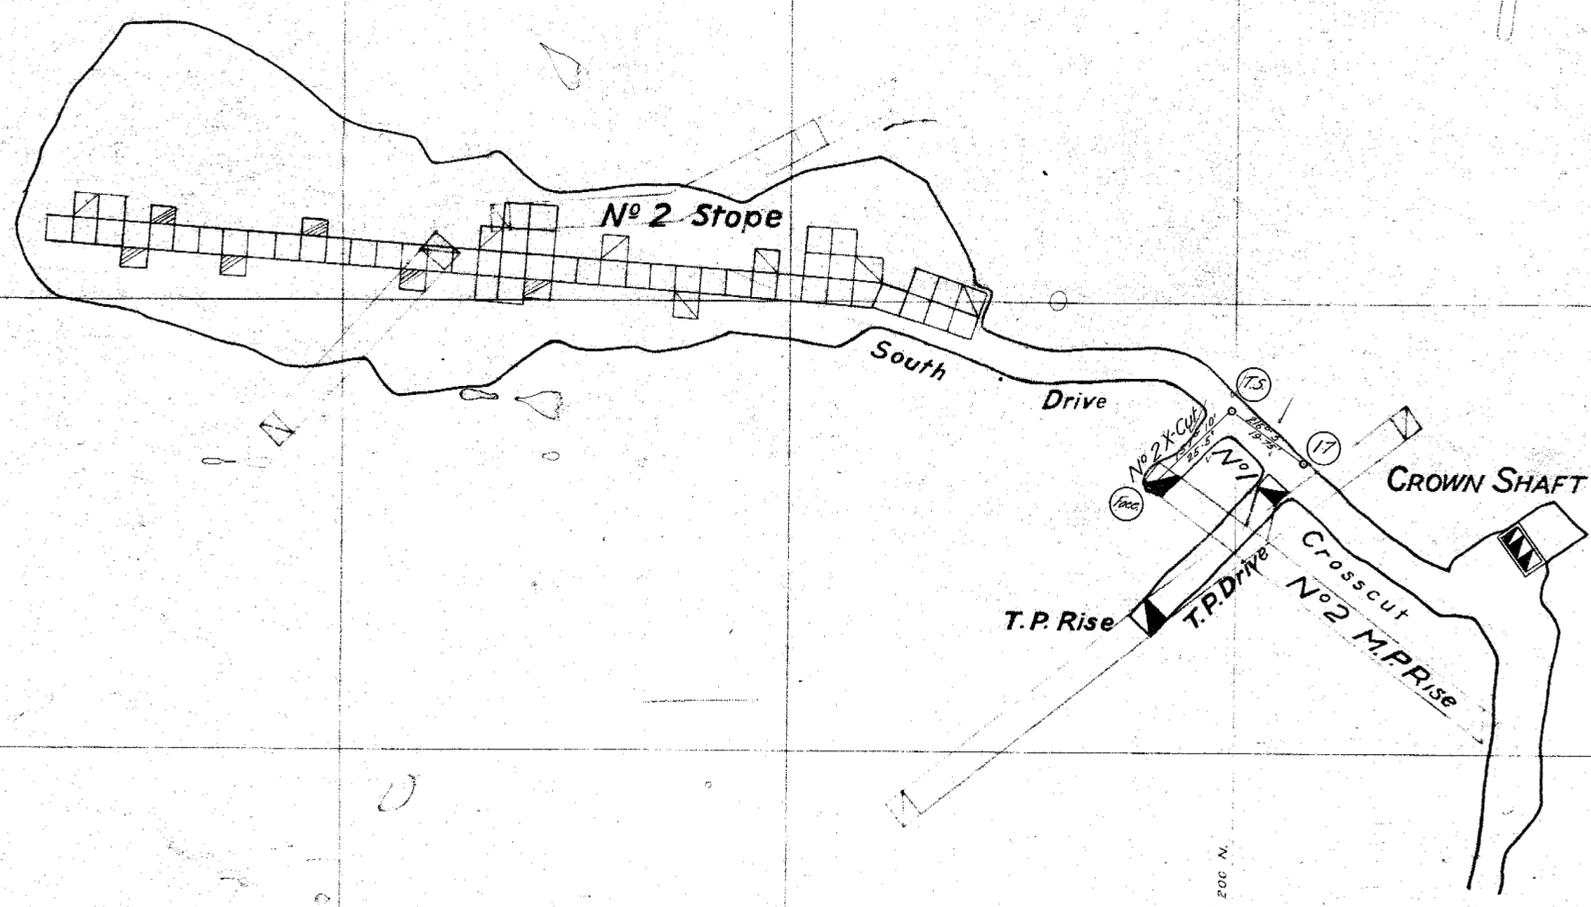


THE MOUNT LYELL M. & R. CO. LTD.

DETAIL PLAN

UNDERGROUND WORKINGS

200 FT. LEVEL

CROWN LYELL MINE

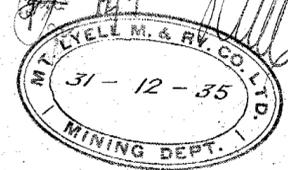

*R. H. W. W. W.* General Manager

*S. Red. Jakus* Mine Superintendent

SCALE - 30 FEET TO THE INCH

