
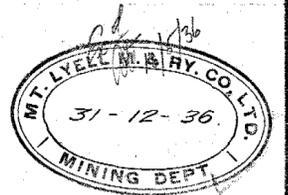


56-42

5 cm

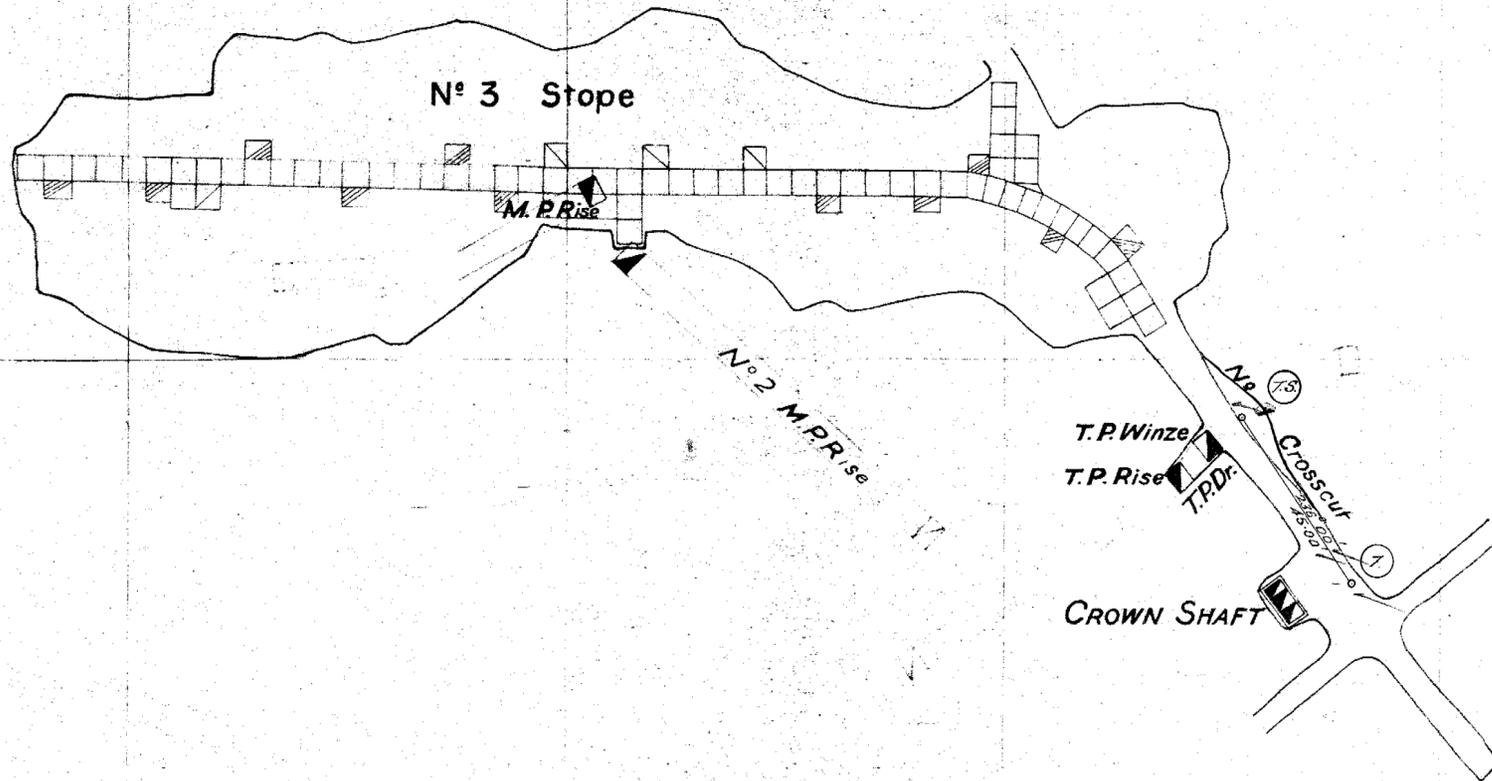


THE MOUNT LYELL M. & R. CO. LTD.

DETAIL PLAN

UNDERGROUND WORKINGS

300 FT. LEVEL

CROWN LYELL MINE

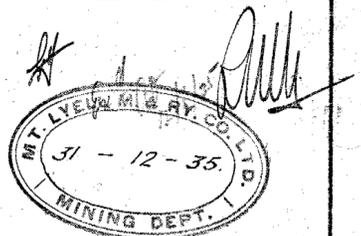

*R. W. Murray* General Manager

*G. L. J. J. J.* Mine Superintendent

SCALE - 30 FEET TO THE INCH



1935 WORK SHEWN BLUE